


PLAT OF SURVEY FOR 3.3967 ACRE PARCEL
 PART OF LOT 35, TRACT 5, TWP. 2-N, RANGE 18-W,
 HUNTINGTON TWP., COUNTY OF LORAIN
 STATE OF OHIO

21-052035-000

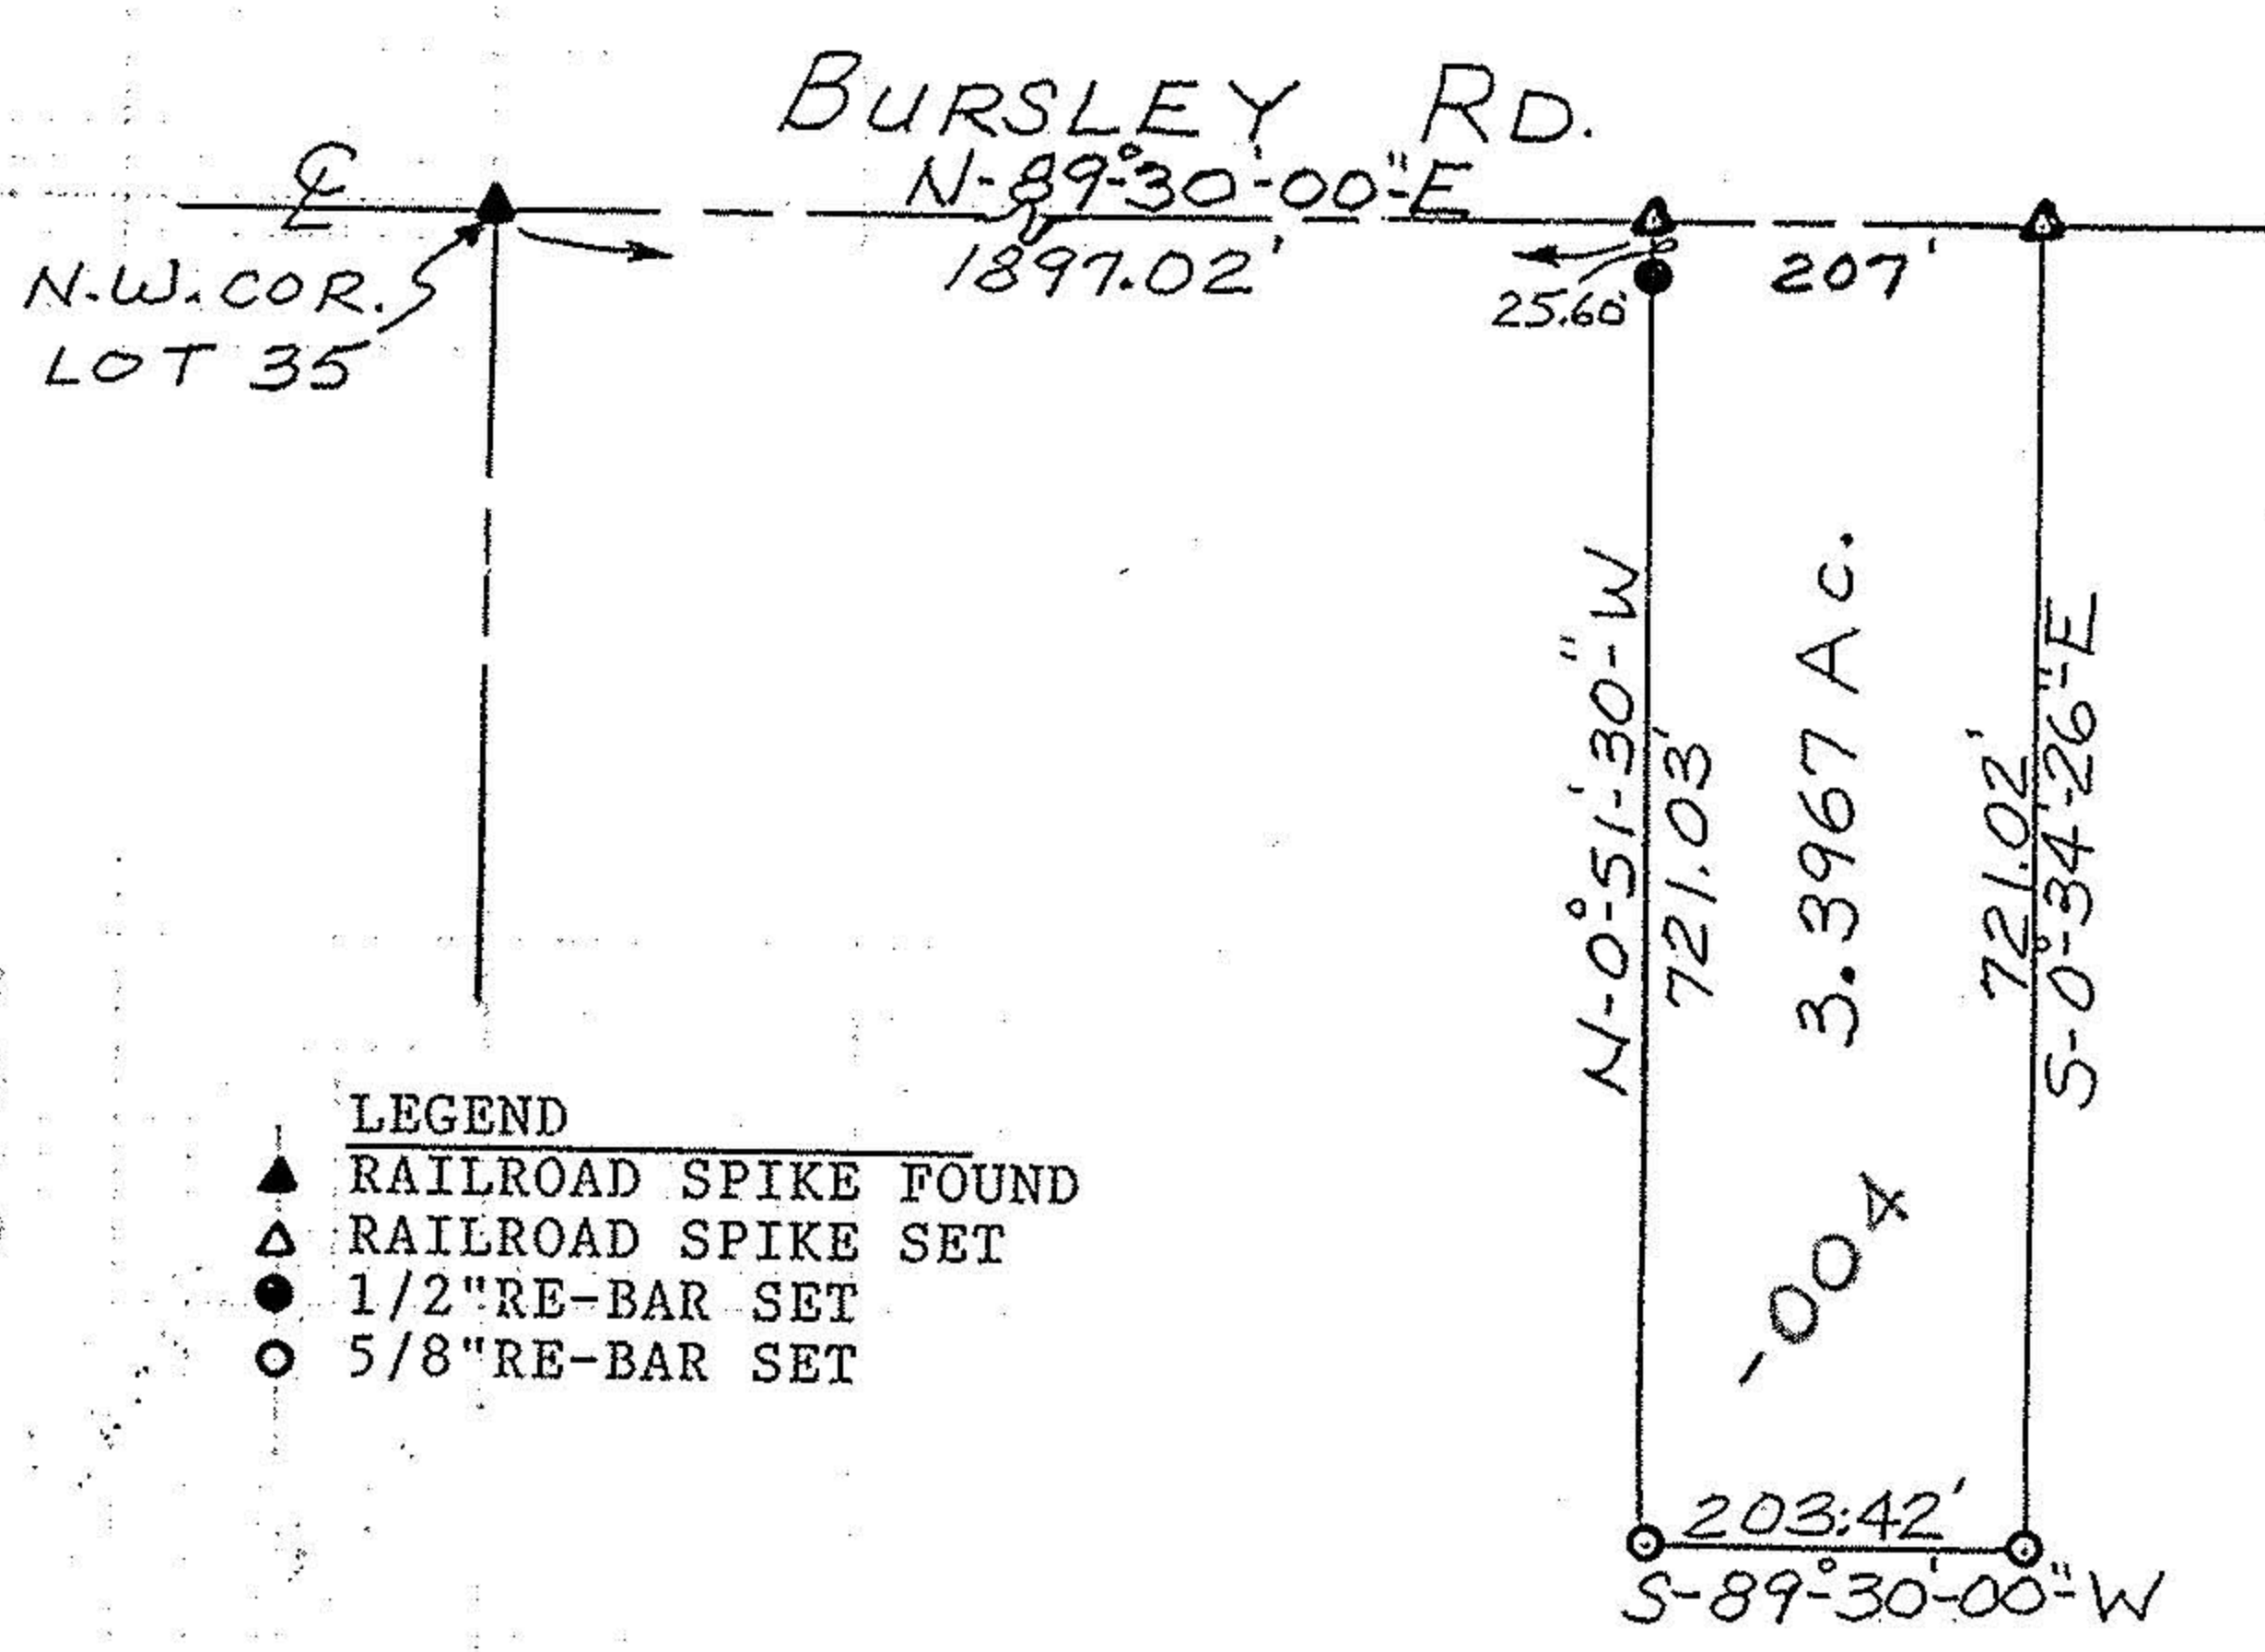

#17978

- LEGEND**
- ▲ RAILROAD SPIKE FOUND
 - △ RAILROAD SPIKE SET
 - 1/2" RE-BAR SET
 - 5/8" RE-BAR SET


Scale: 1"=200'

17978

All bearings are magnetic and are to be used for the determination of angles only.

APPROVED	
LORAIN CO.	
MAP DEPT.	
DATE	6-8-88
PAGE	21-A
BY	Carl Francis
VOID AFTER	# 17978

William L. Fox
 William L. Fox, P.S.
 Registered Surveyor No. 5878

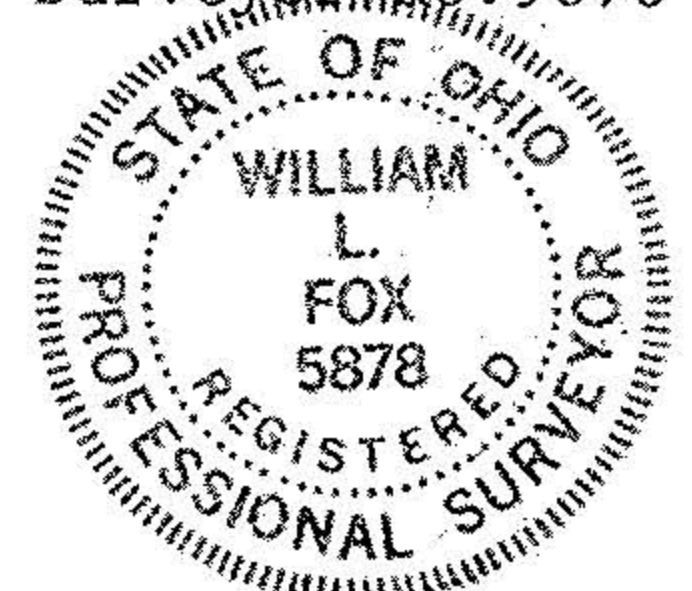

Job No, 1882 May 1988

21-05-035-000
 21-A
 000-032-000
 91-02-002-000-001
 600-000-000-001

A-12

(061)