


#3848

16-00-0477-000-A

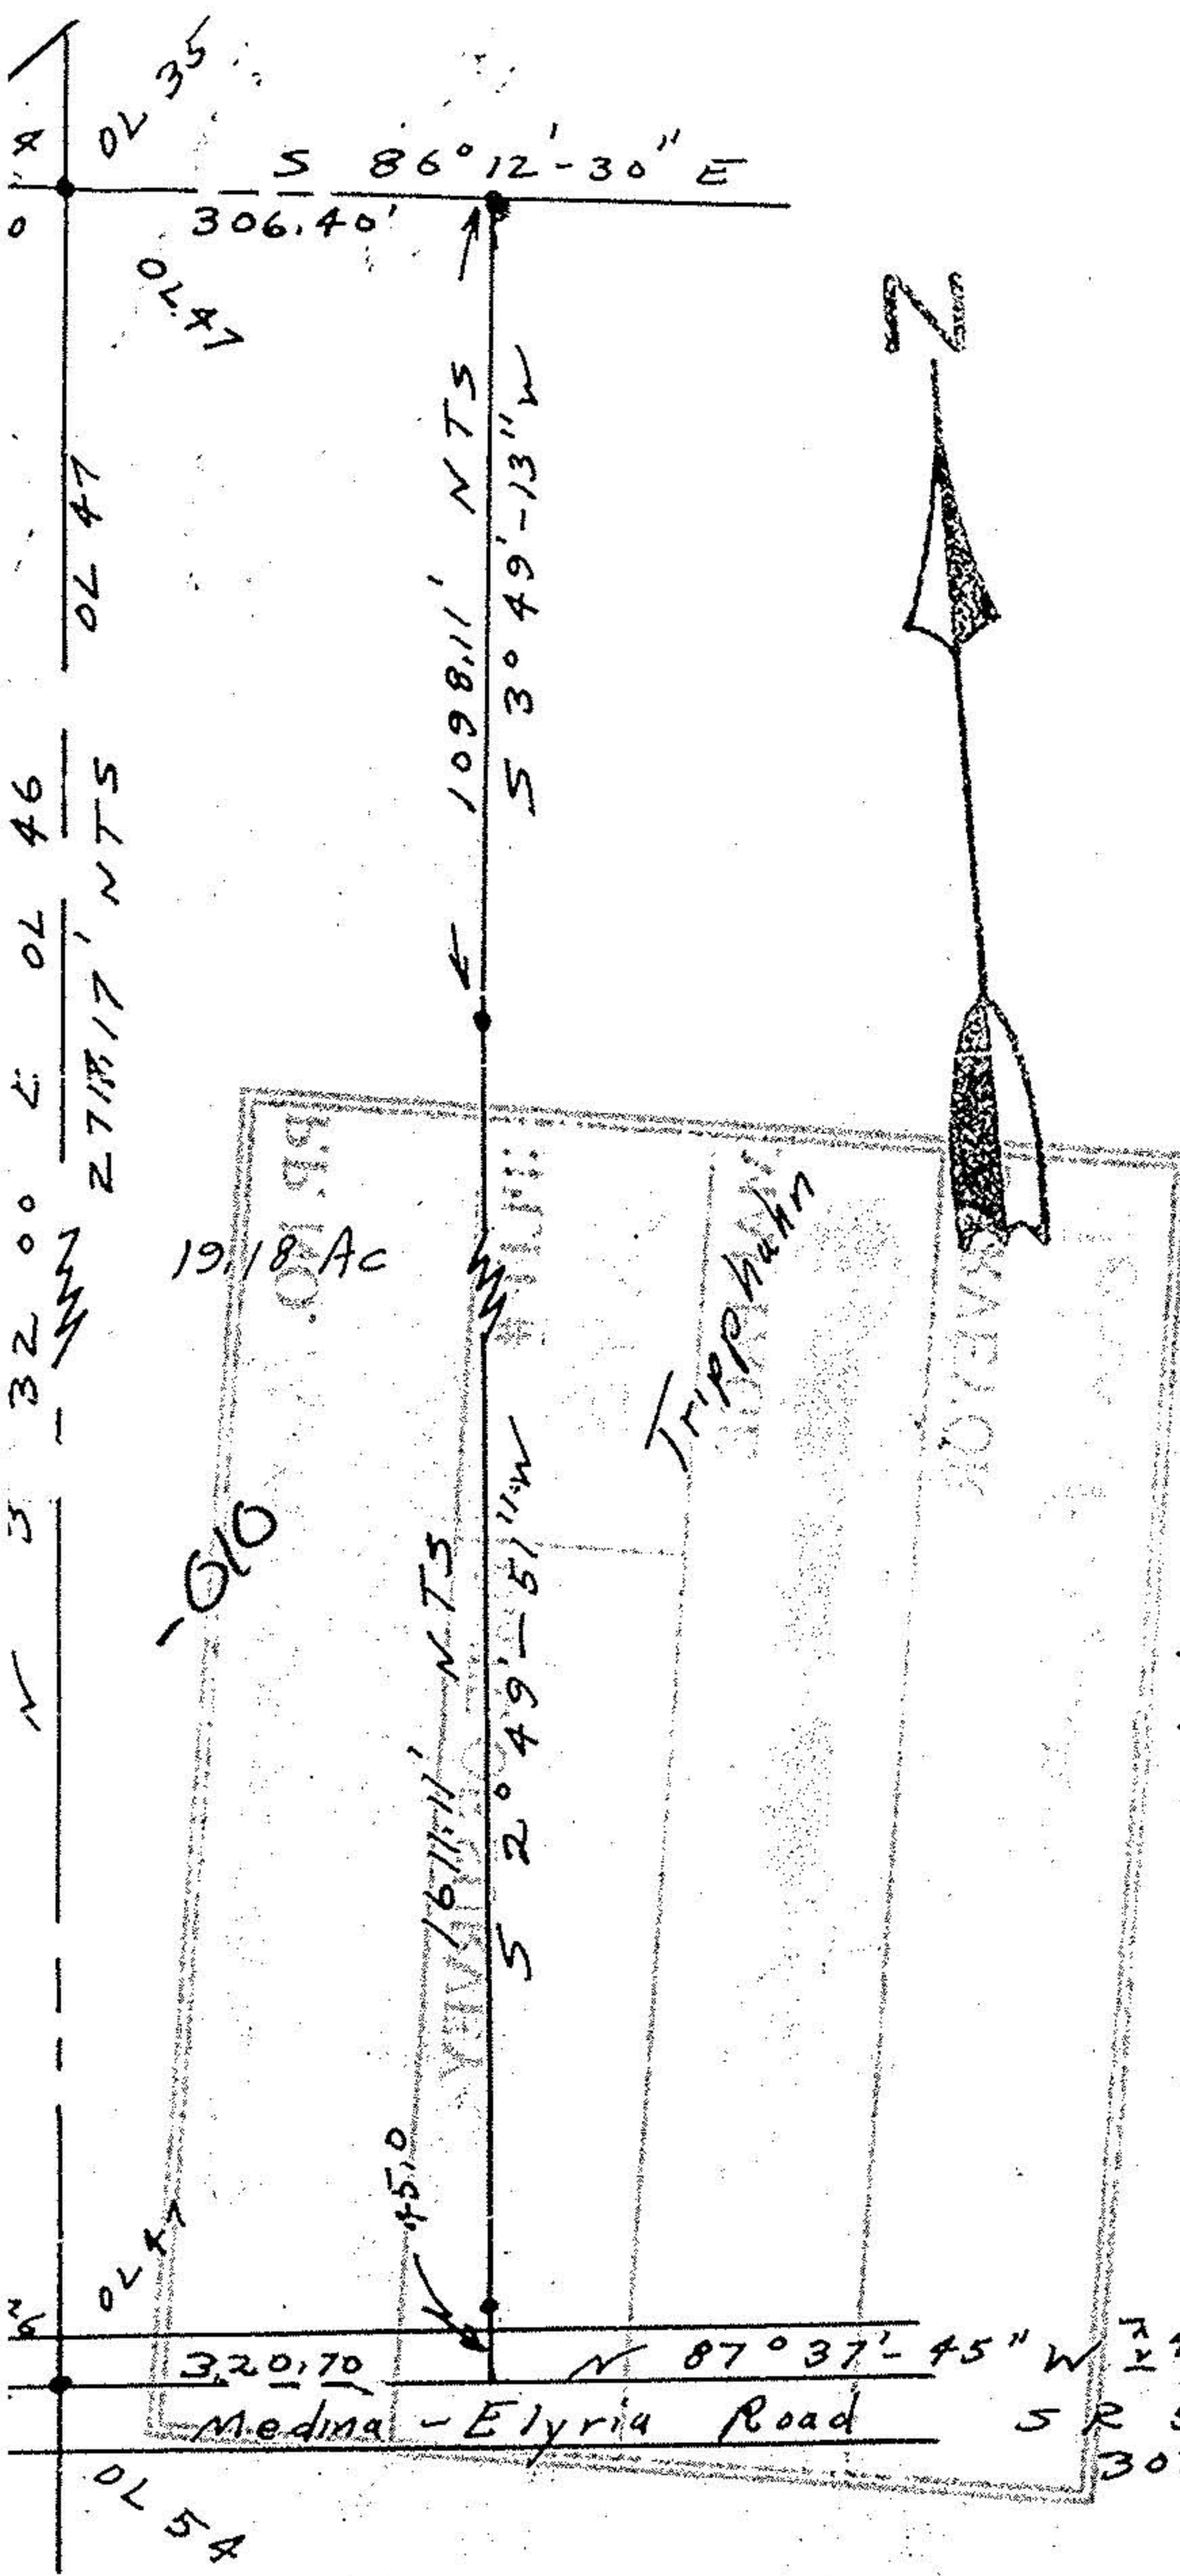

Survey for
 Lillian Tripphahn
 Part of 02 47
 Grafton Twp
 Lorain County Ohio
 Scale 1" = 200
 April 1970

#3848

John Poznywak
 Reg Surveyor
 # 5292

16-00-0477-000-A

• 1P's fd or set
 Bearings from state R/W Plans