


18-00-027-102

18-00-027-A

Map of Part of Bennett and Kirk Co. Add.
Wellington Village Lorain Co. Ohio.
Scale 1" = 100' June 10, 1978

Volume 1 Page 33 Lorain Co. Records

18-00-027-

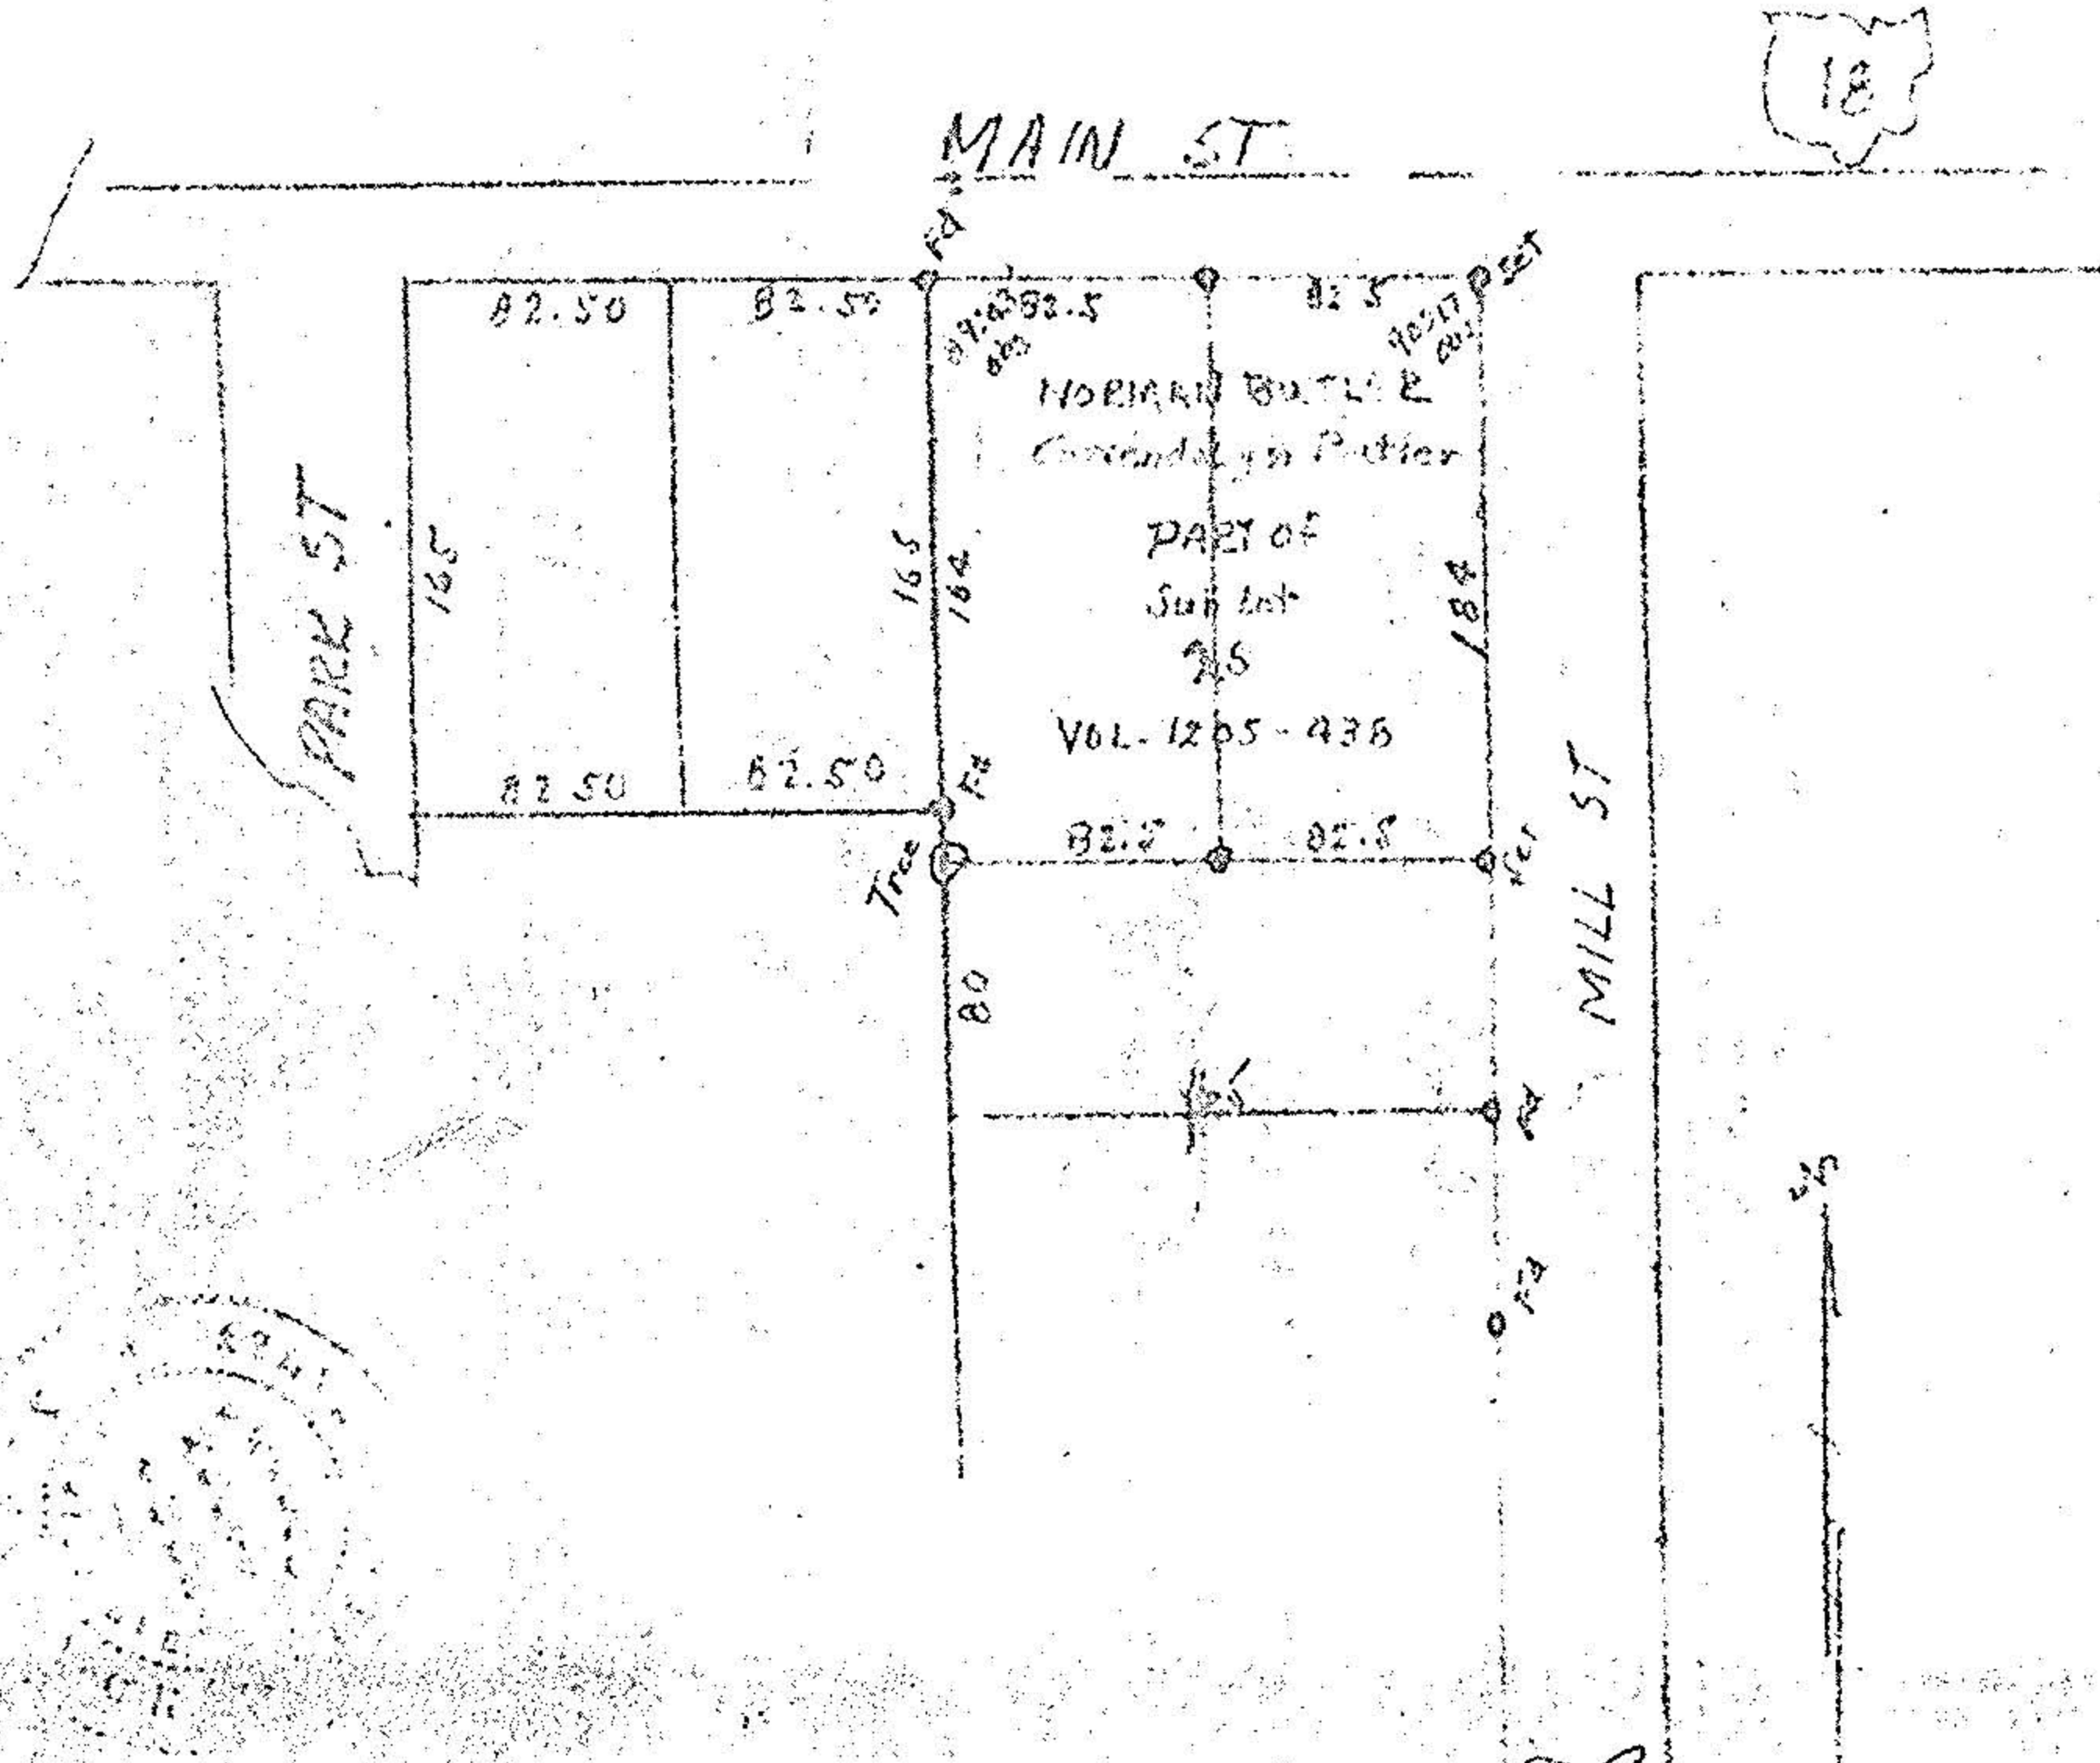

The Wellington Planning Com.
James Guerin
7/24/78

18-00-027-102