




LAUNDON • SIMON • CAHL & ASSOC., INC.
 CONSULTING ENGINEERS & SURVEYORS
 110 MIDDLE AVE., ELYRIA, O. 44035

SURVEY FOR:

DUANE EATON

Orig. Lot 12	City of	Date 2-2-96	Scale 1"=100'
Orig. Sec	Village of	Dwn. by R.G.S.	Chkd. by R.C.
Tract 5	County of LORAIN	Job No. 96-2824 F.B. 238/3A	
Township of ROCHESTER	State of OHIO	Printed	

BEARINGS ARE TO AN ASSUMED
 MERIDIAN AND USED TO DESCRIBE
 ANGLES ONLY.

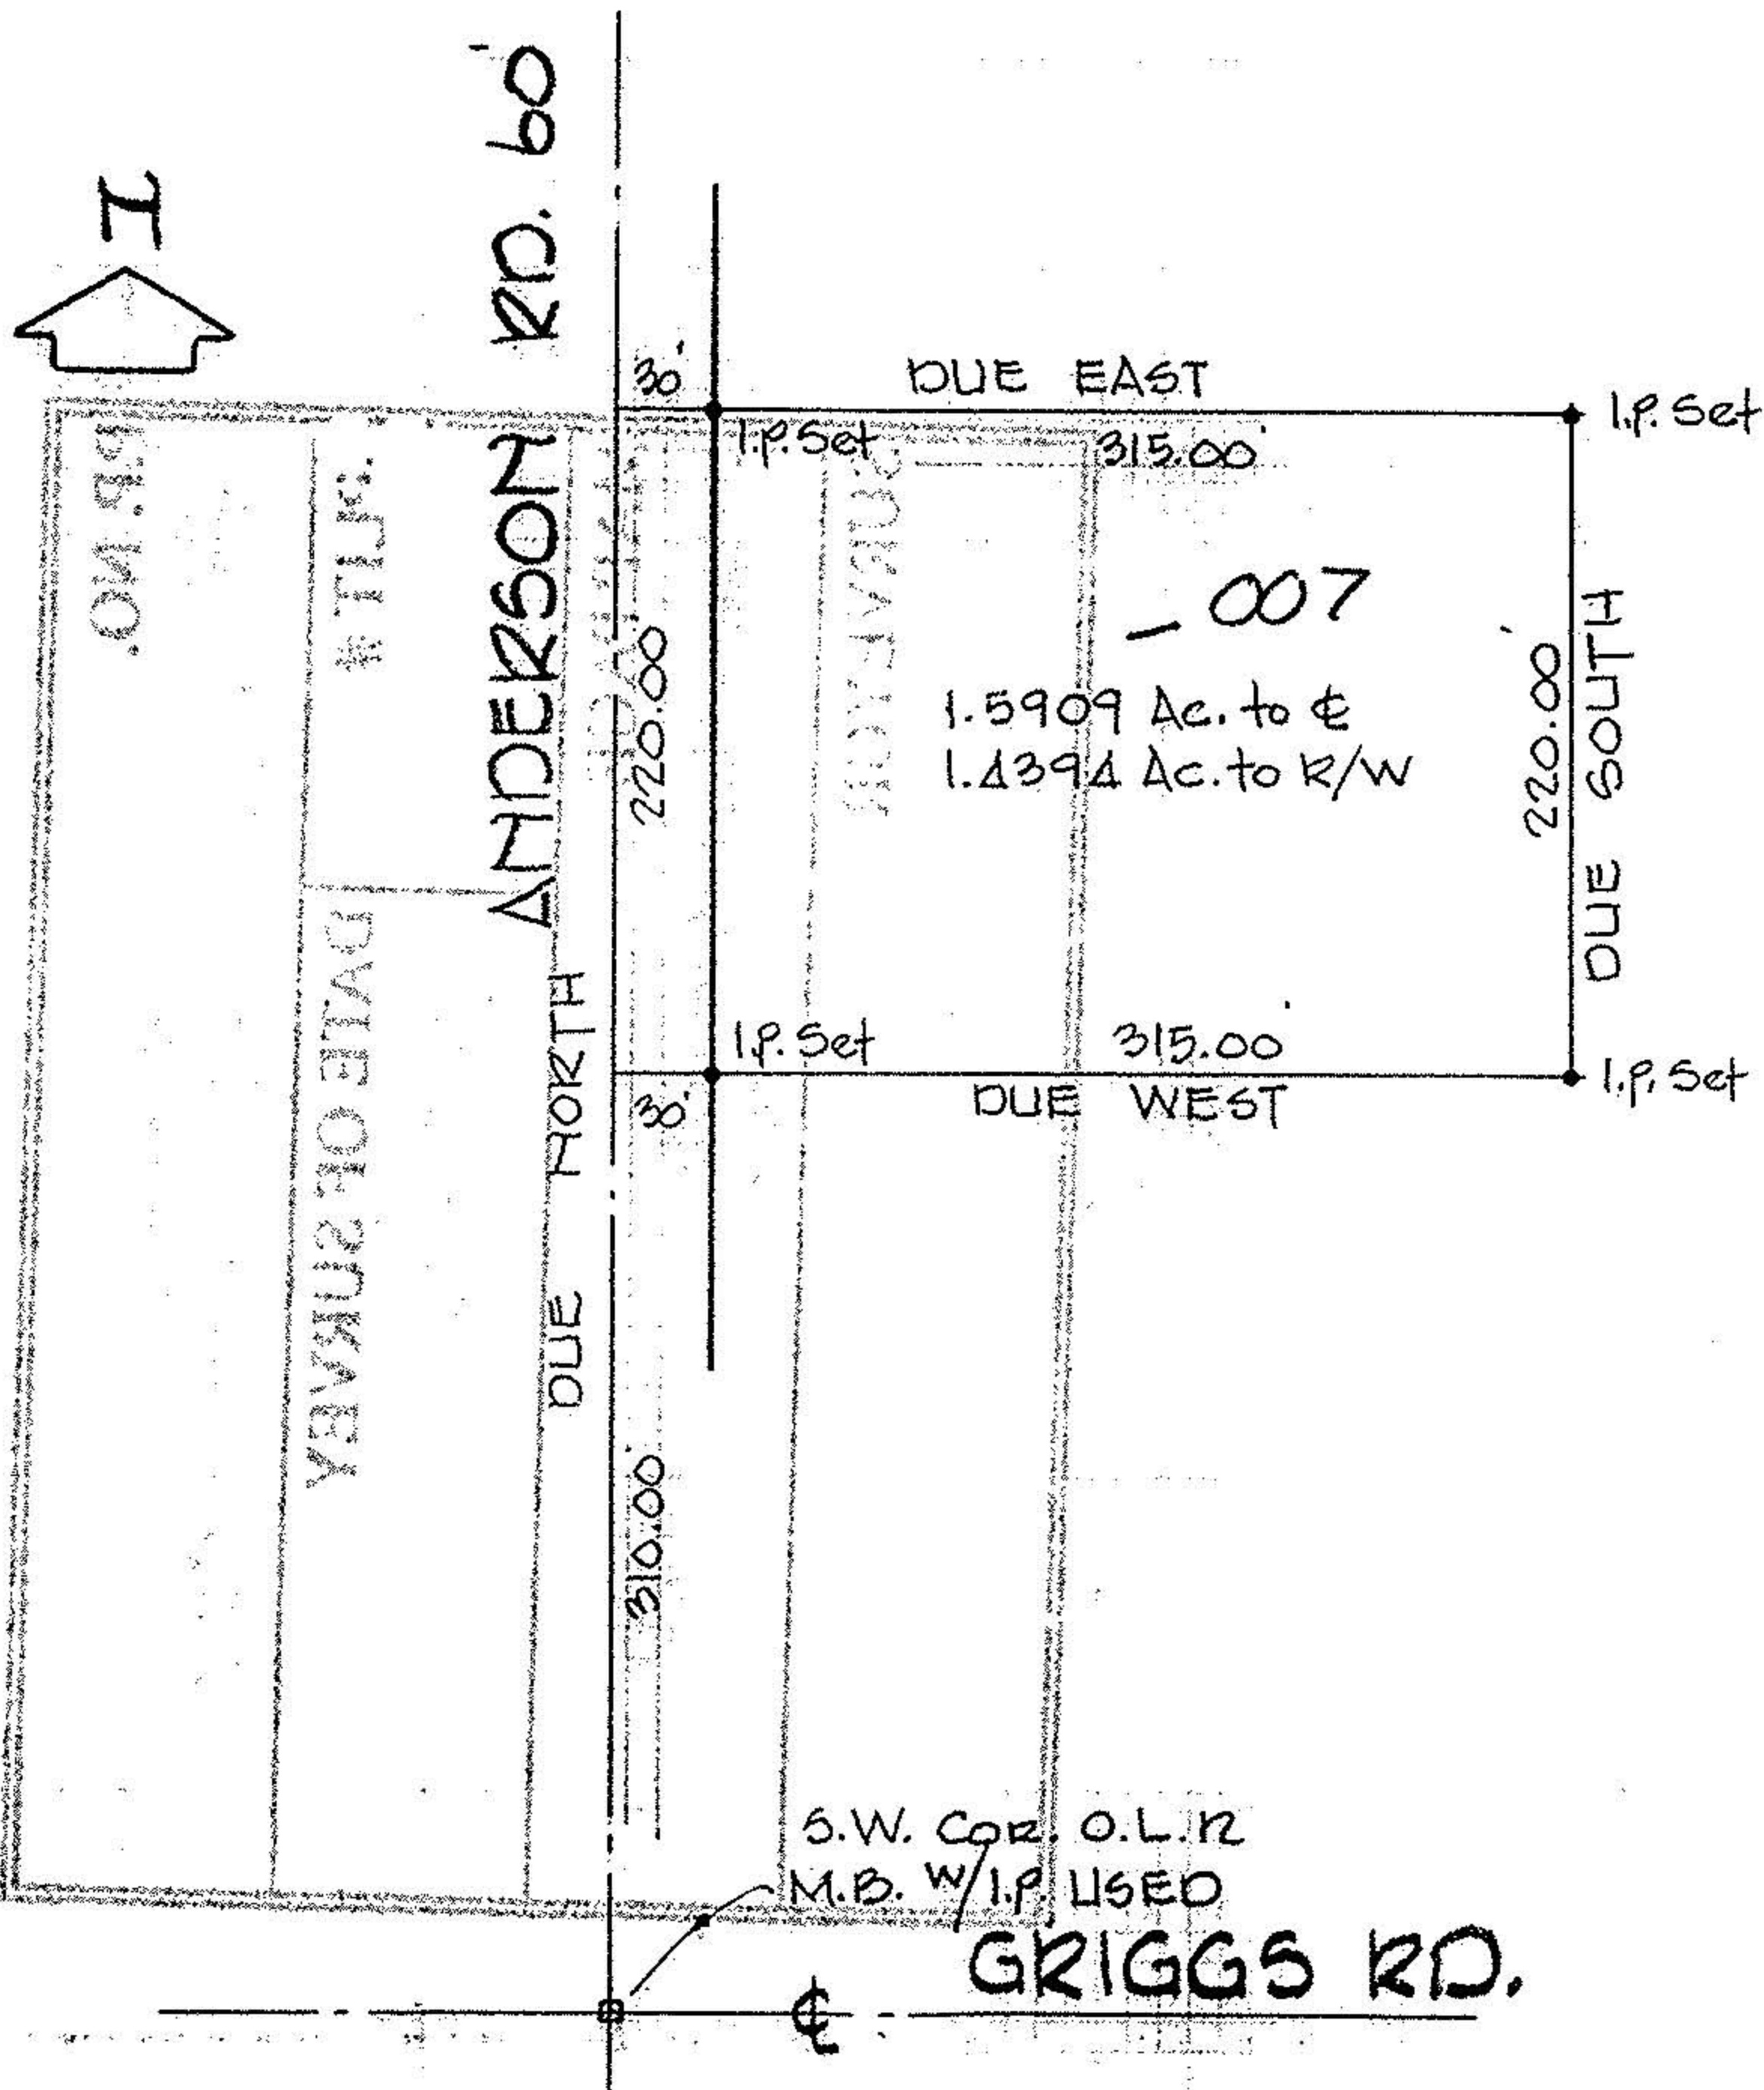

RMDR. of -006
 25.41 Ac. Calc.

HOWARD C. & MARVERNE M. EATON
 O.R.V. 68 P. 226

S.W. COR. O.L.R.
 M.B. W/I.P. USED
 GRIGGS RD.