

LAUNDON . SIMON . CAHL & ASSOC. INC.
CONSULTING ENGINEERS & SURVEYORS
ELYRIA, OHIO 44035

SURVEY FOR:
RICHARD & ELAINE McQUATE

Orig. Lot 29 & 30	City of	Date JULY '91 Scale 1"=100'
Orig. Sec	Village of	Dwn. by R.G.S. Chkd. by R.C.
Tract - 2	County of LORAIN	Job No. 91-2070 F.B. 221/29
Township of PENFIELD	State of OHIO	Printed

JONES RD.

DUE WEST

R.R.S. Fd.

M.B. Used

175.00'

3550.98'

I.P. Set

OL 30
0.35 Ac.

I.P. Fd.

O.L. 30

1.66 Ac.
O.L. 29

O.L. 29

FOSTER RD.

RMOR. 33.13 Ac.

- 025

2.0086 Ac.

S. 0° 29' 10" W. 500.00'

N. 0° 29' 10" E. 500.00'

RONALD A. & DOROTHY M. DIEHL
V. 1065 P. 878

19596

APPROVED
LORAIN CO.
MAP DEPT.


DATE 11-14-91

PAGE 19-G

CAROLYN FRONEL

VOID AFTER

#19596

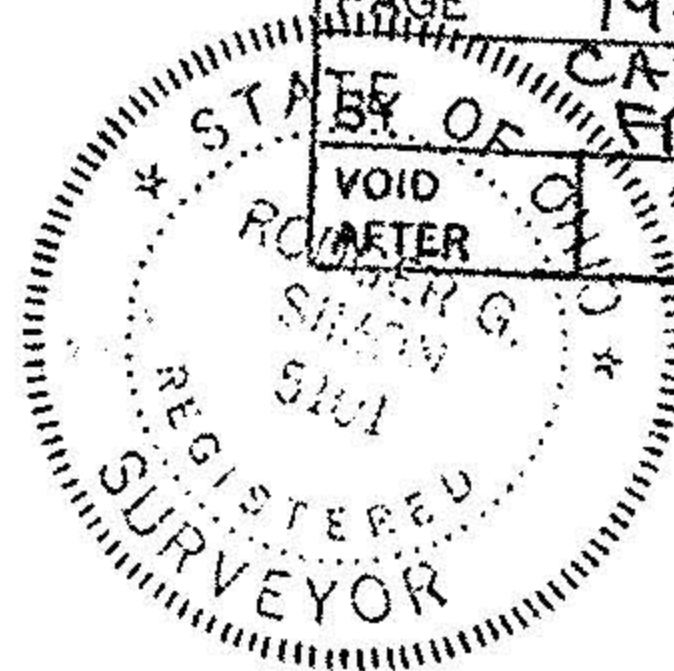

NORTH SHOWN IS
ASSUMED. BEARINGS
USED TO DESCRIBE
ANGLES ONLY

075

19-02-029-000-050
-030-050

9661

19-G