


Helen Carter



Younglas Bros

shown graphically

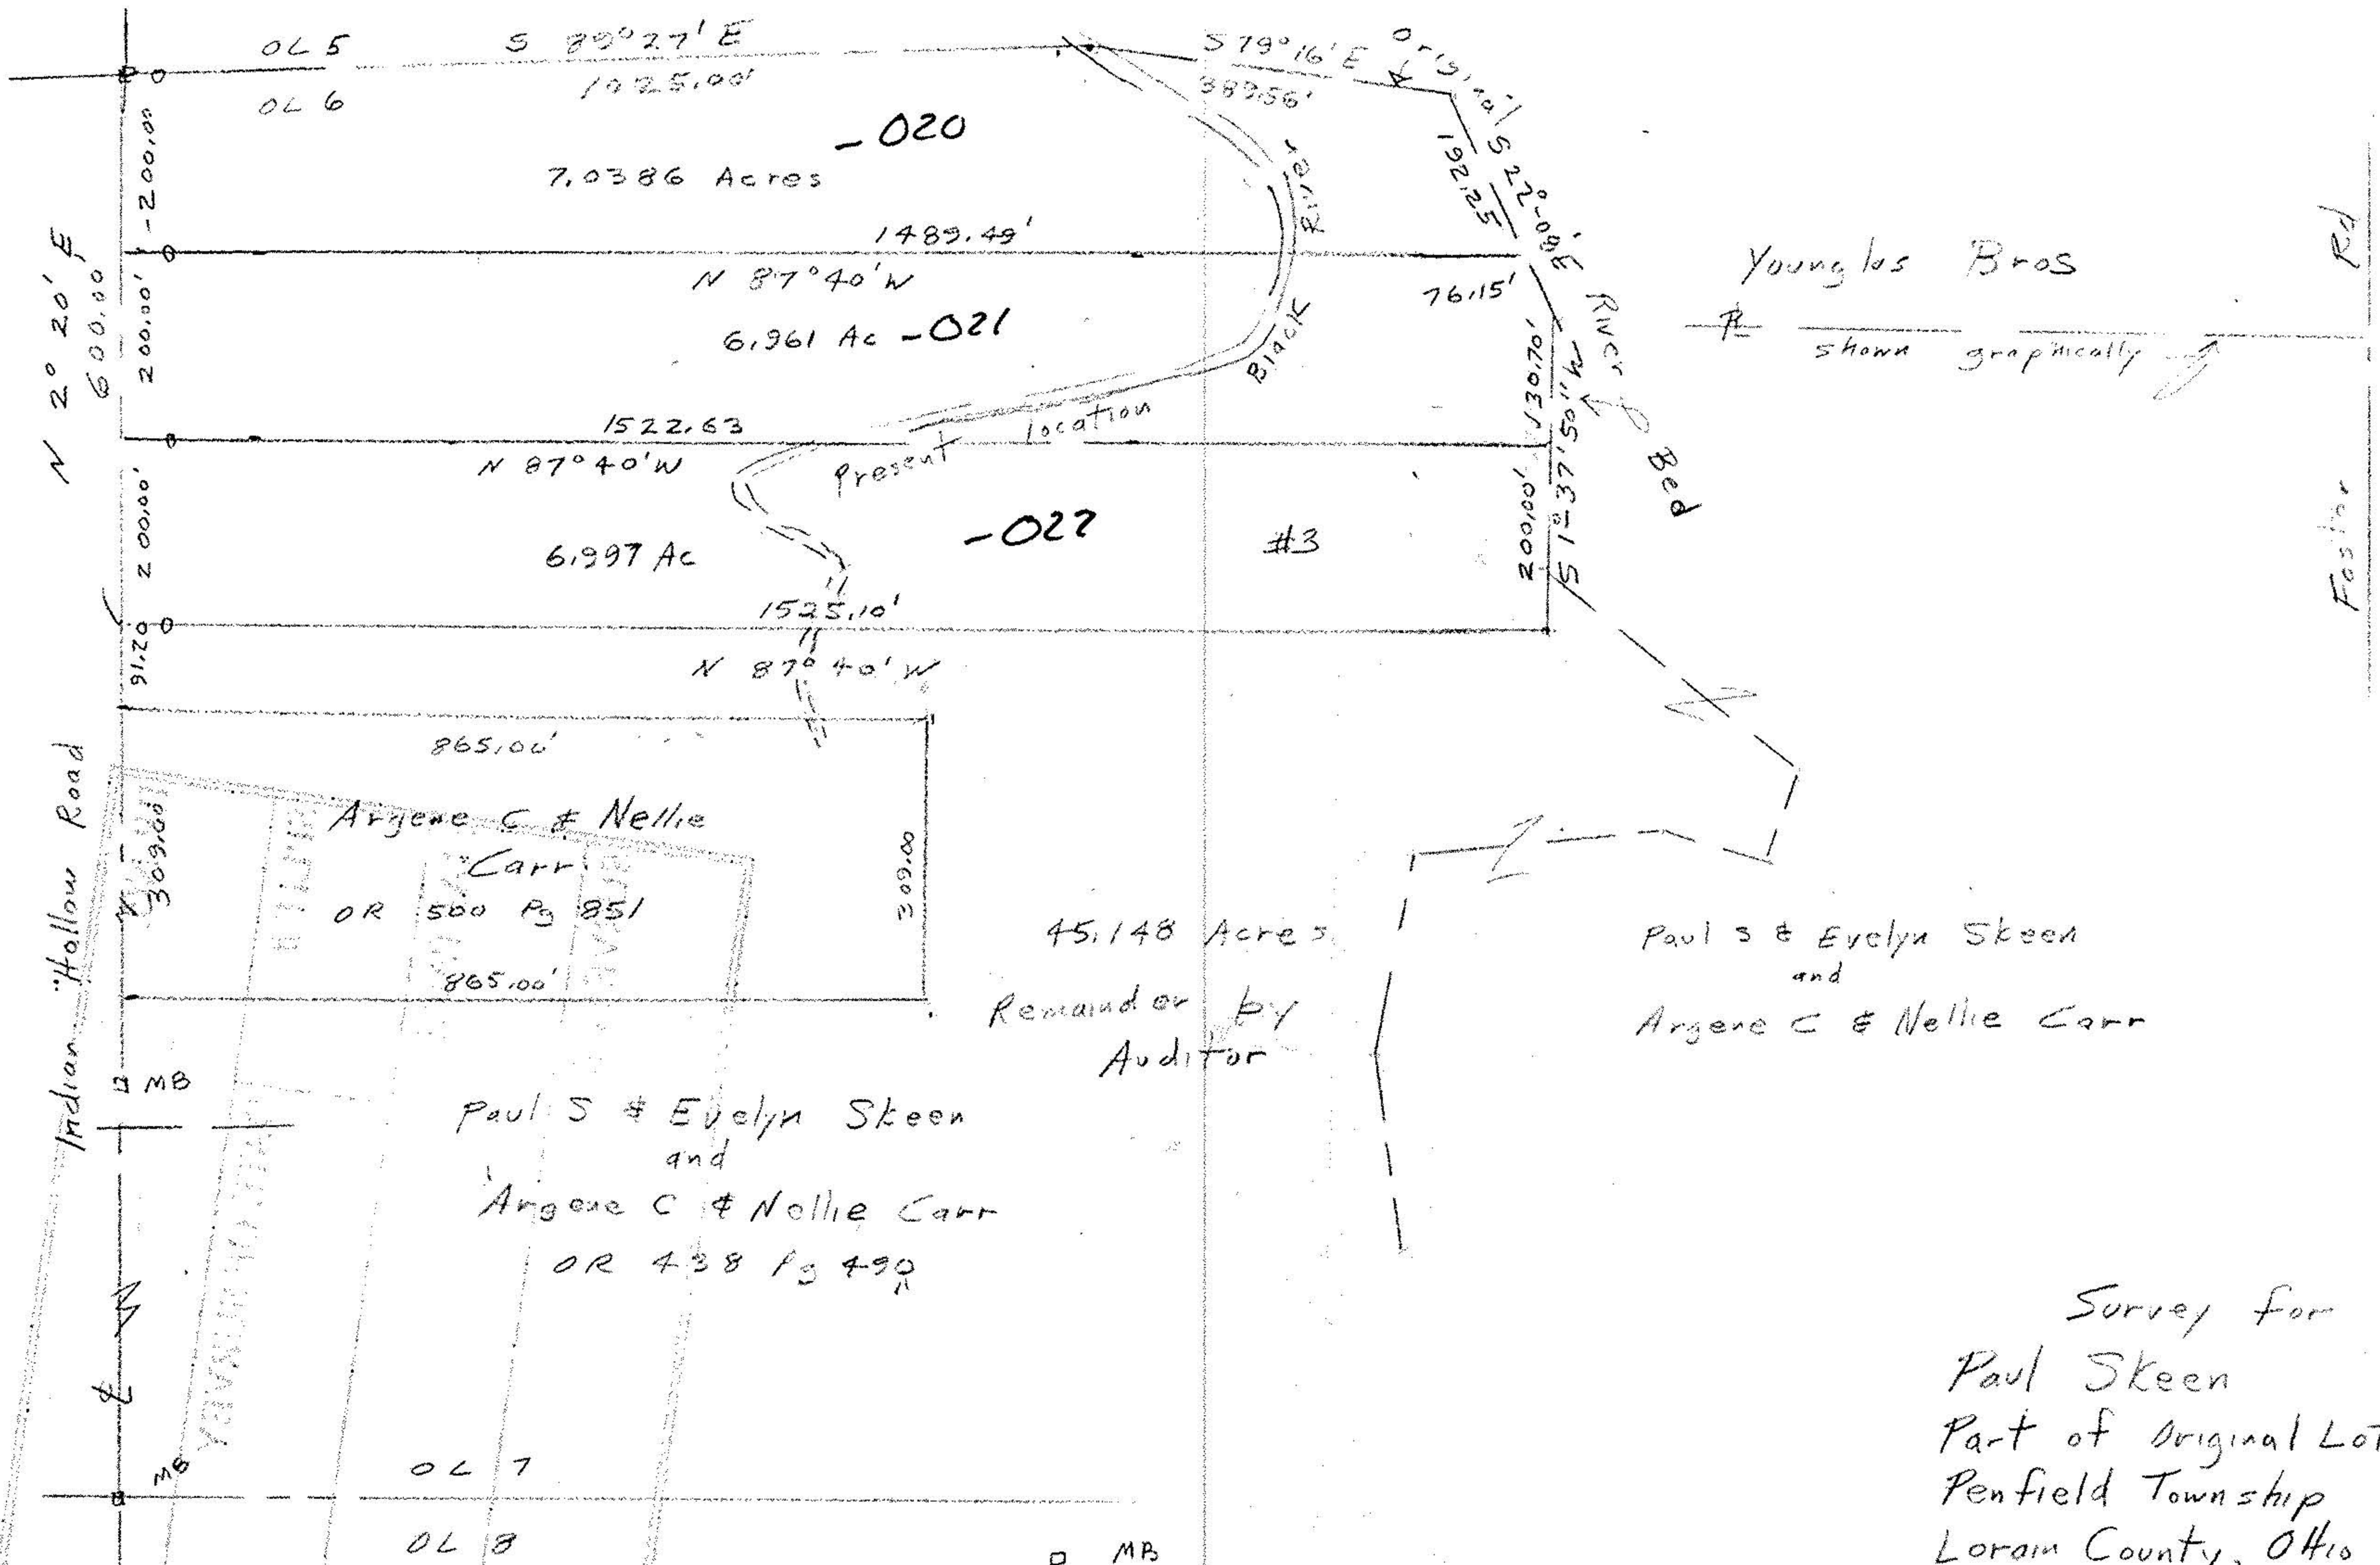


Remainder by Auditor

Paul S & Evelyn Skeen and Argene C & Nellie Carr

Paul S & Evelyn Skeen and Argene C & Nellie Carr OR 438 Pg 490

Survey for  
 Paul Skeen  
 Part of Original Lot 6, Tract 5  
 Penfield Township  
 Lorain County, Ohio  
 Scale 1" = 200' Apr 1992

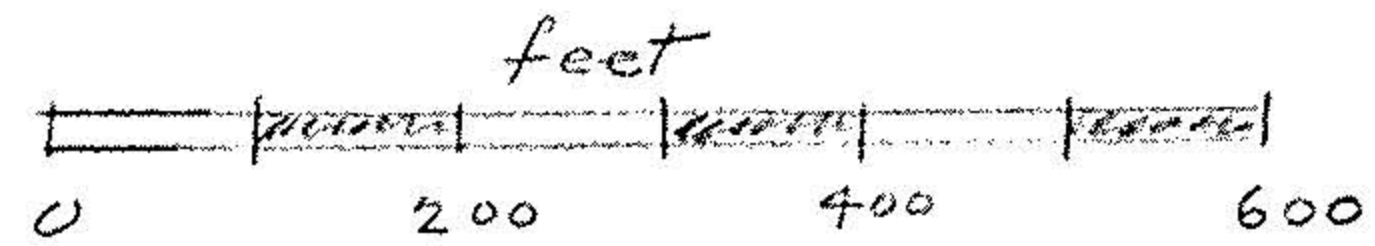

Revised 6/3/92

- MB
- iron pipes set
- iron pipes found
- Ac Acres

John Pozywak  
Registered Surveyor  
5292

