


15-C

18364

15-014-000-

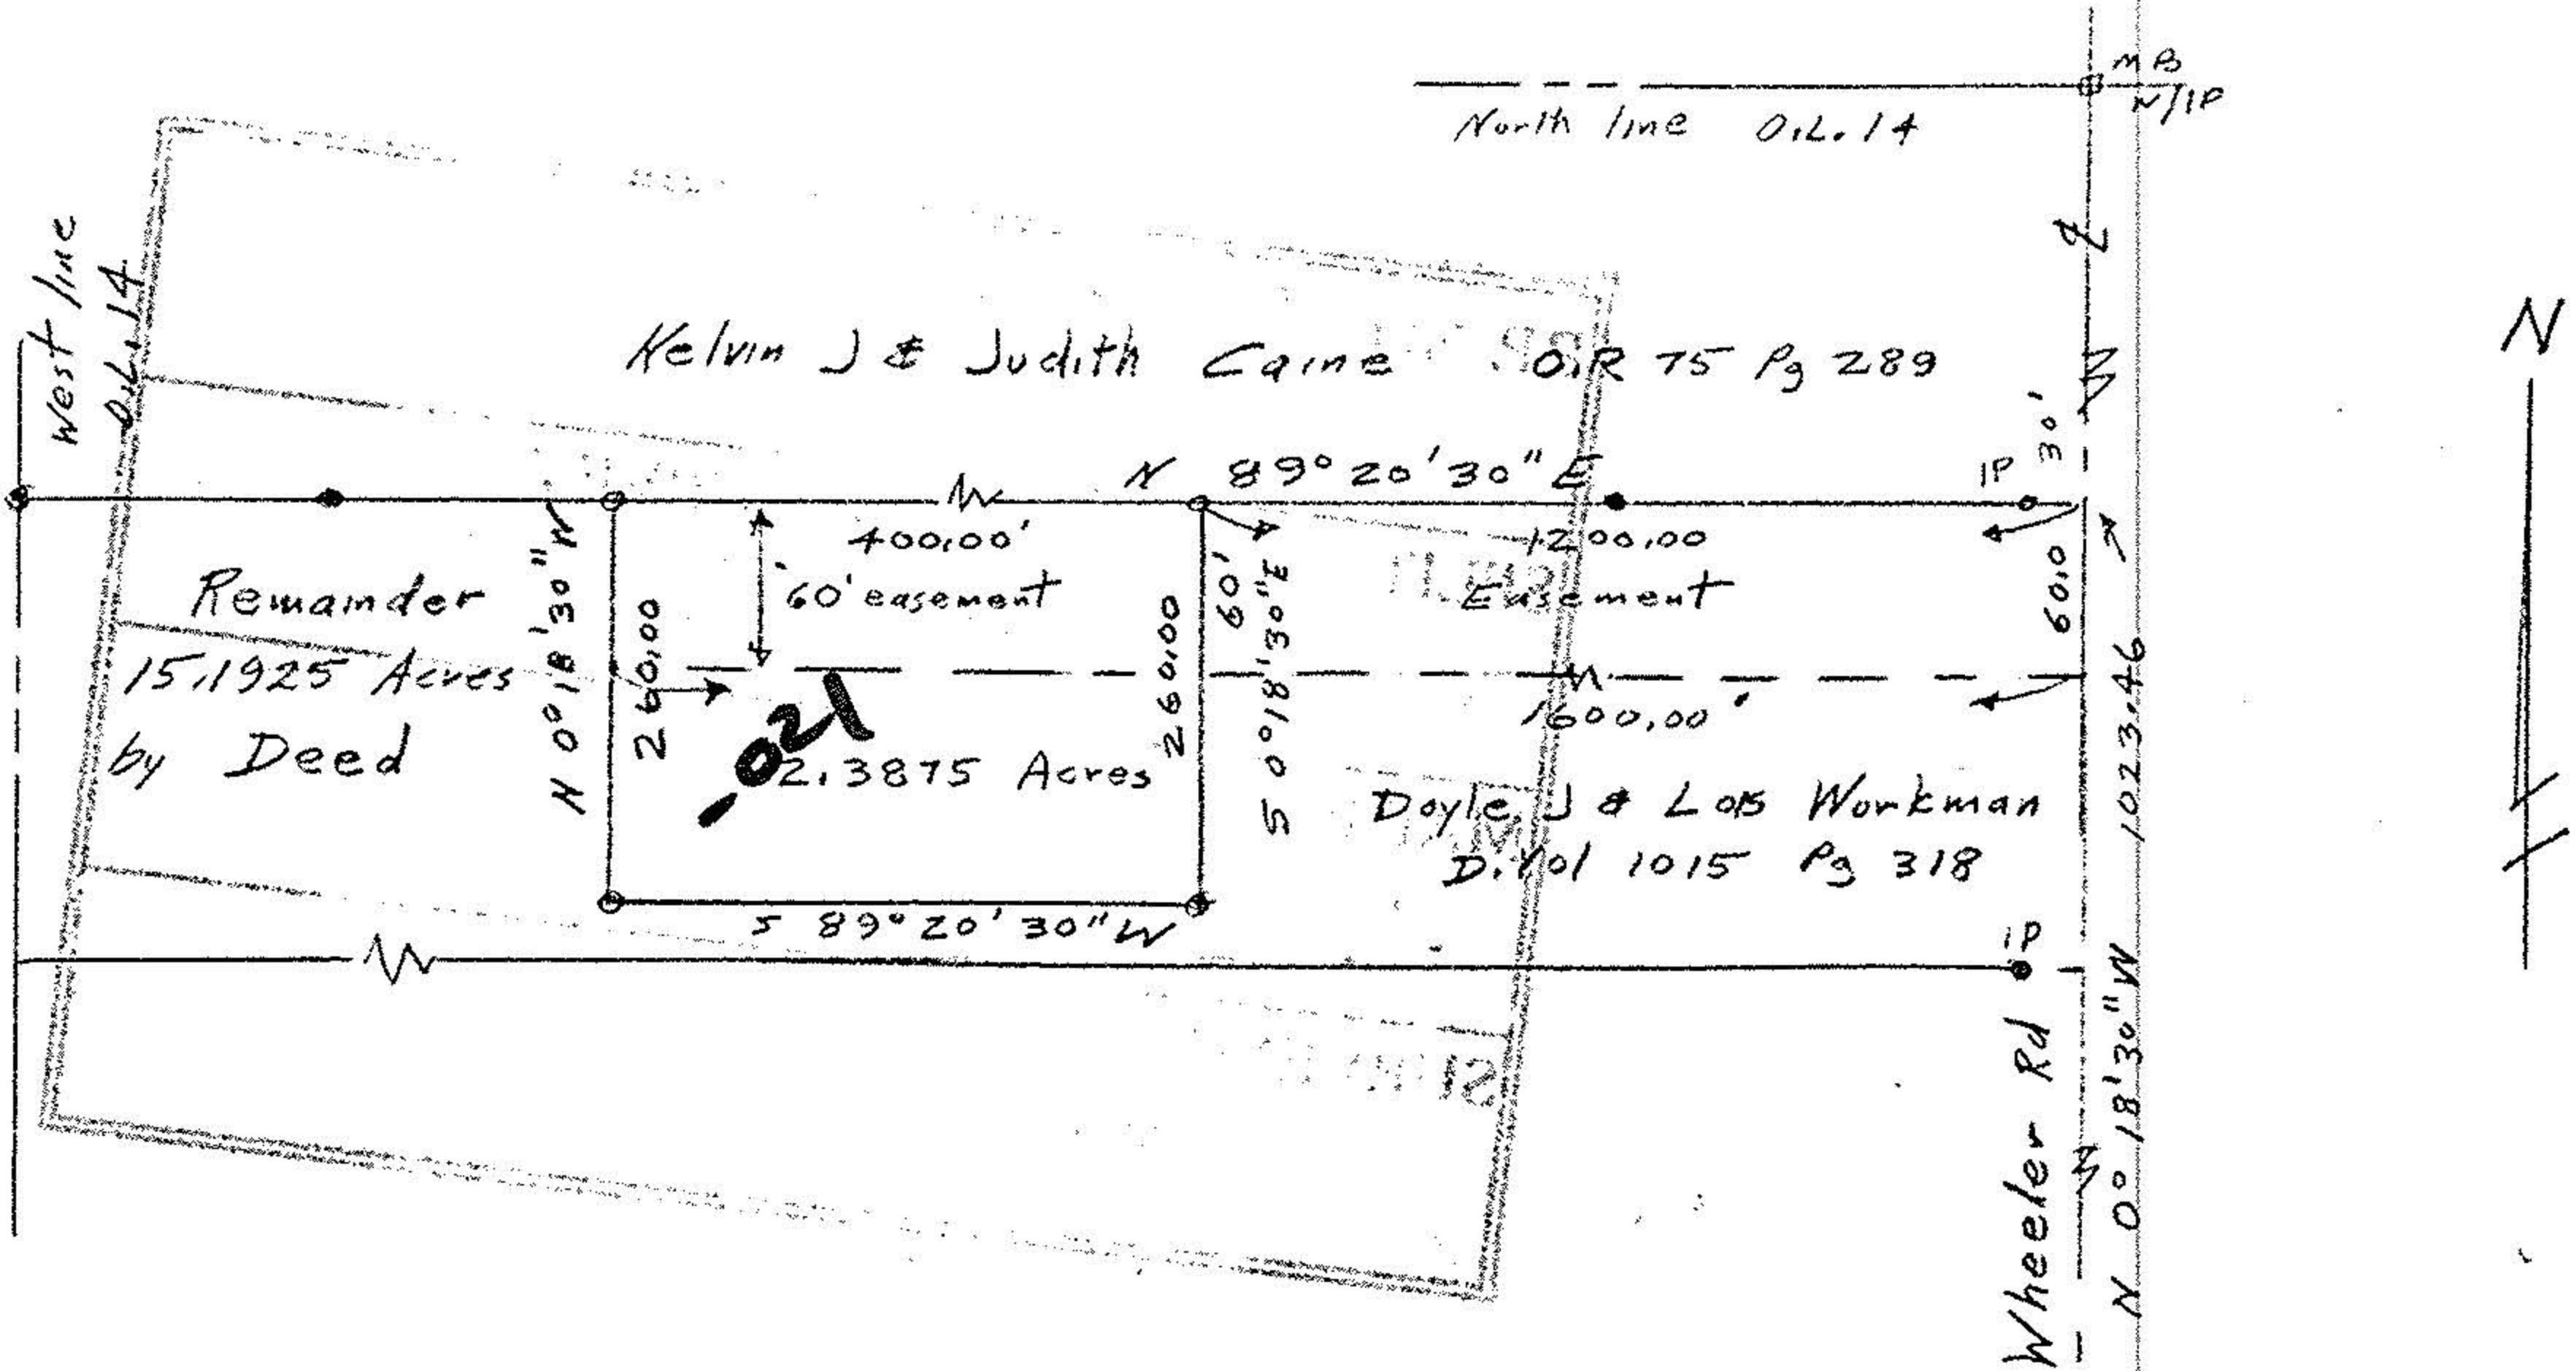

- IP's fd
- o IP set

John Poznywak
 Reg Surveyor
 5292

Survey of a
 Parcel Split in Original Lot 14
 LaGrange Township
 Lorain County Ohio
 Mar 18, 1989 Scale variable

#18364

APPROVED LORAIN CO. MAP DEPT.	
DATE 3-24-89	
PAGE 15-C	
BY CAROL FRANCIS	
VOID	# 18364