

Weldon & Mary
Eaton

DIV 1230
Pg 124

Quarry Rd 50'

N 2°00' E

289.5 E
462.10
25'

S 88°12' E
1383.40

3,000 Acres

-015

325.00

325.00'

S 2°00' W

13,952 Ac

98.00'
25.0

208.10 E

N 88°12' W

402.10

1790.50'

N 88°12' W

014

413.01

Weldon & Mary Eaton

DIV 1018 Pg 407

Rochester Twp

Huntington Twp

Margaret McCafferty

327-01

PAGE 20-10



BY J. H. H. FIELD

#015-00697

Lorain County
Field BK
158 for E

205.7

01P

MB

Weldon & Mary
Eaton

013


DIV 1361
Pg 31

Bursley Rd

0 Iron pins

0 Iron pins set

0 Monuments

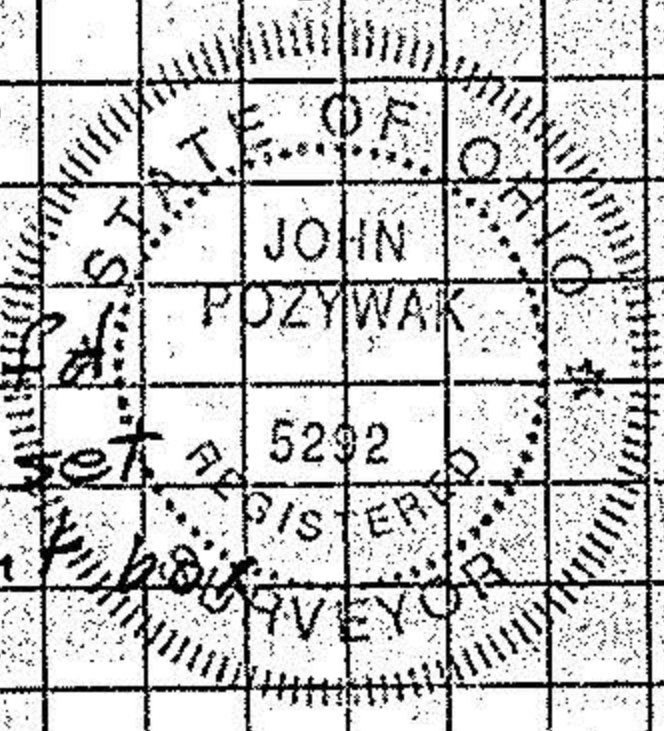

Survey of Parcel Split
Original Lot 4 Tract 5
Rochester Township
Lorain County Ohio
Scale 1" = 100' May 1998
Jan 2001