


15-00-090-000

15-H

WILLIAM B. BARTON  
 Reg. Land Surveyor No. 4438  
 188 PARKWOOD AVENUE  
 AVON LAKE, OHIO 44012  
 TELEPHONE (216) 933-6662

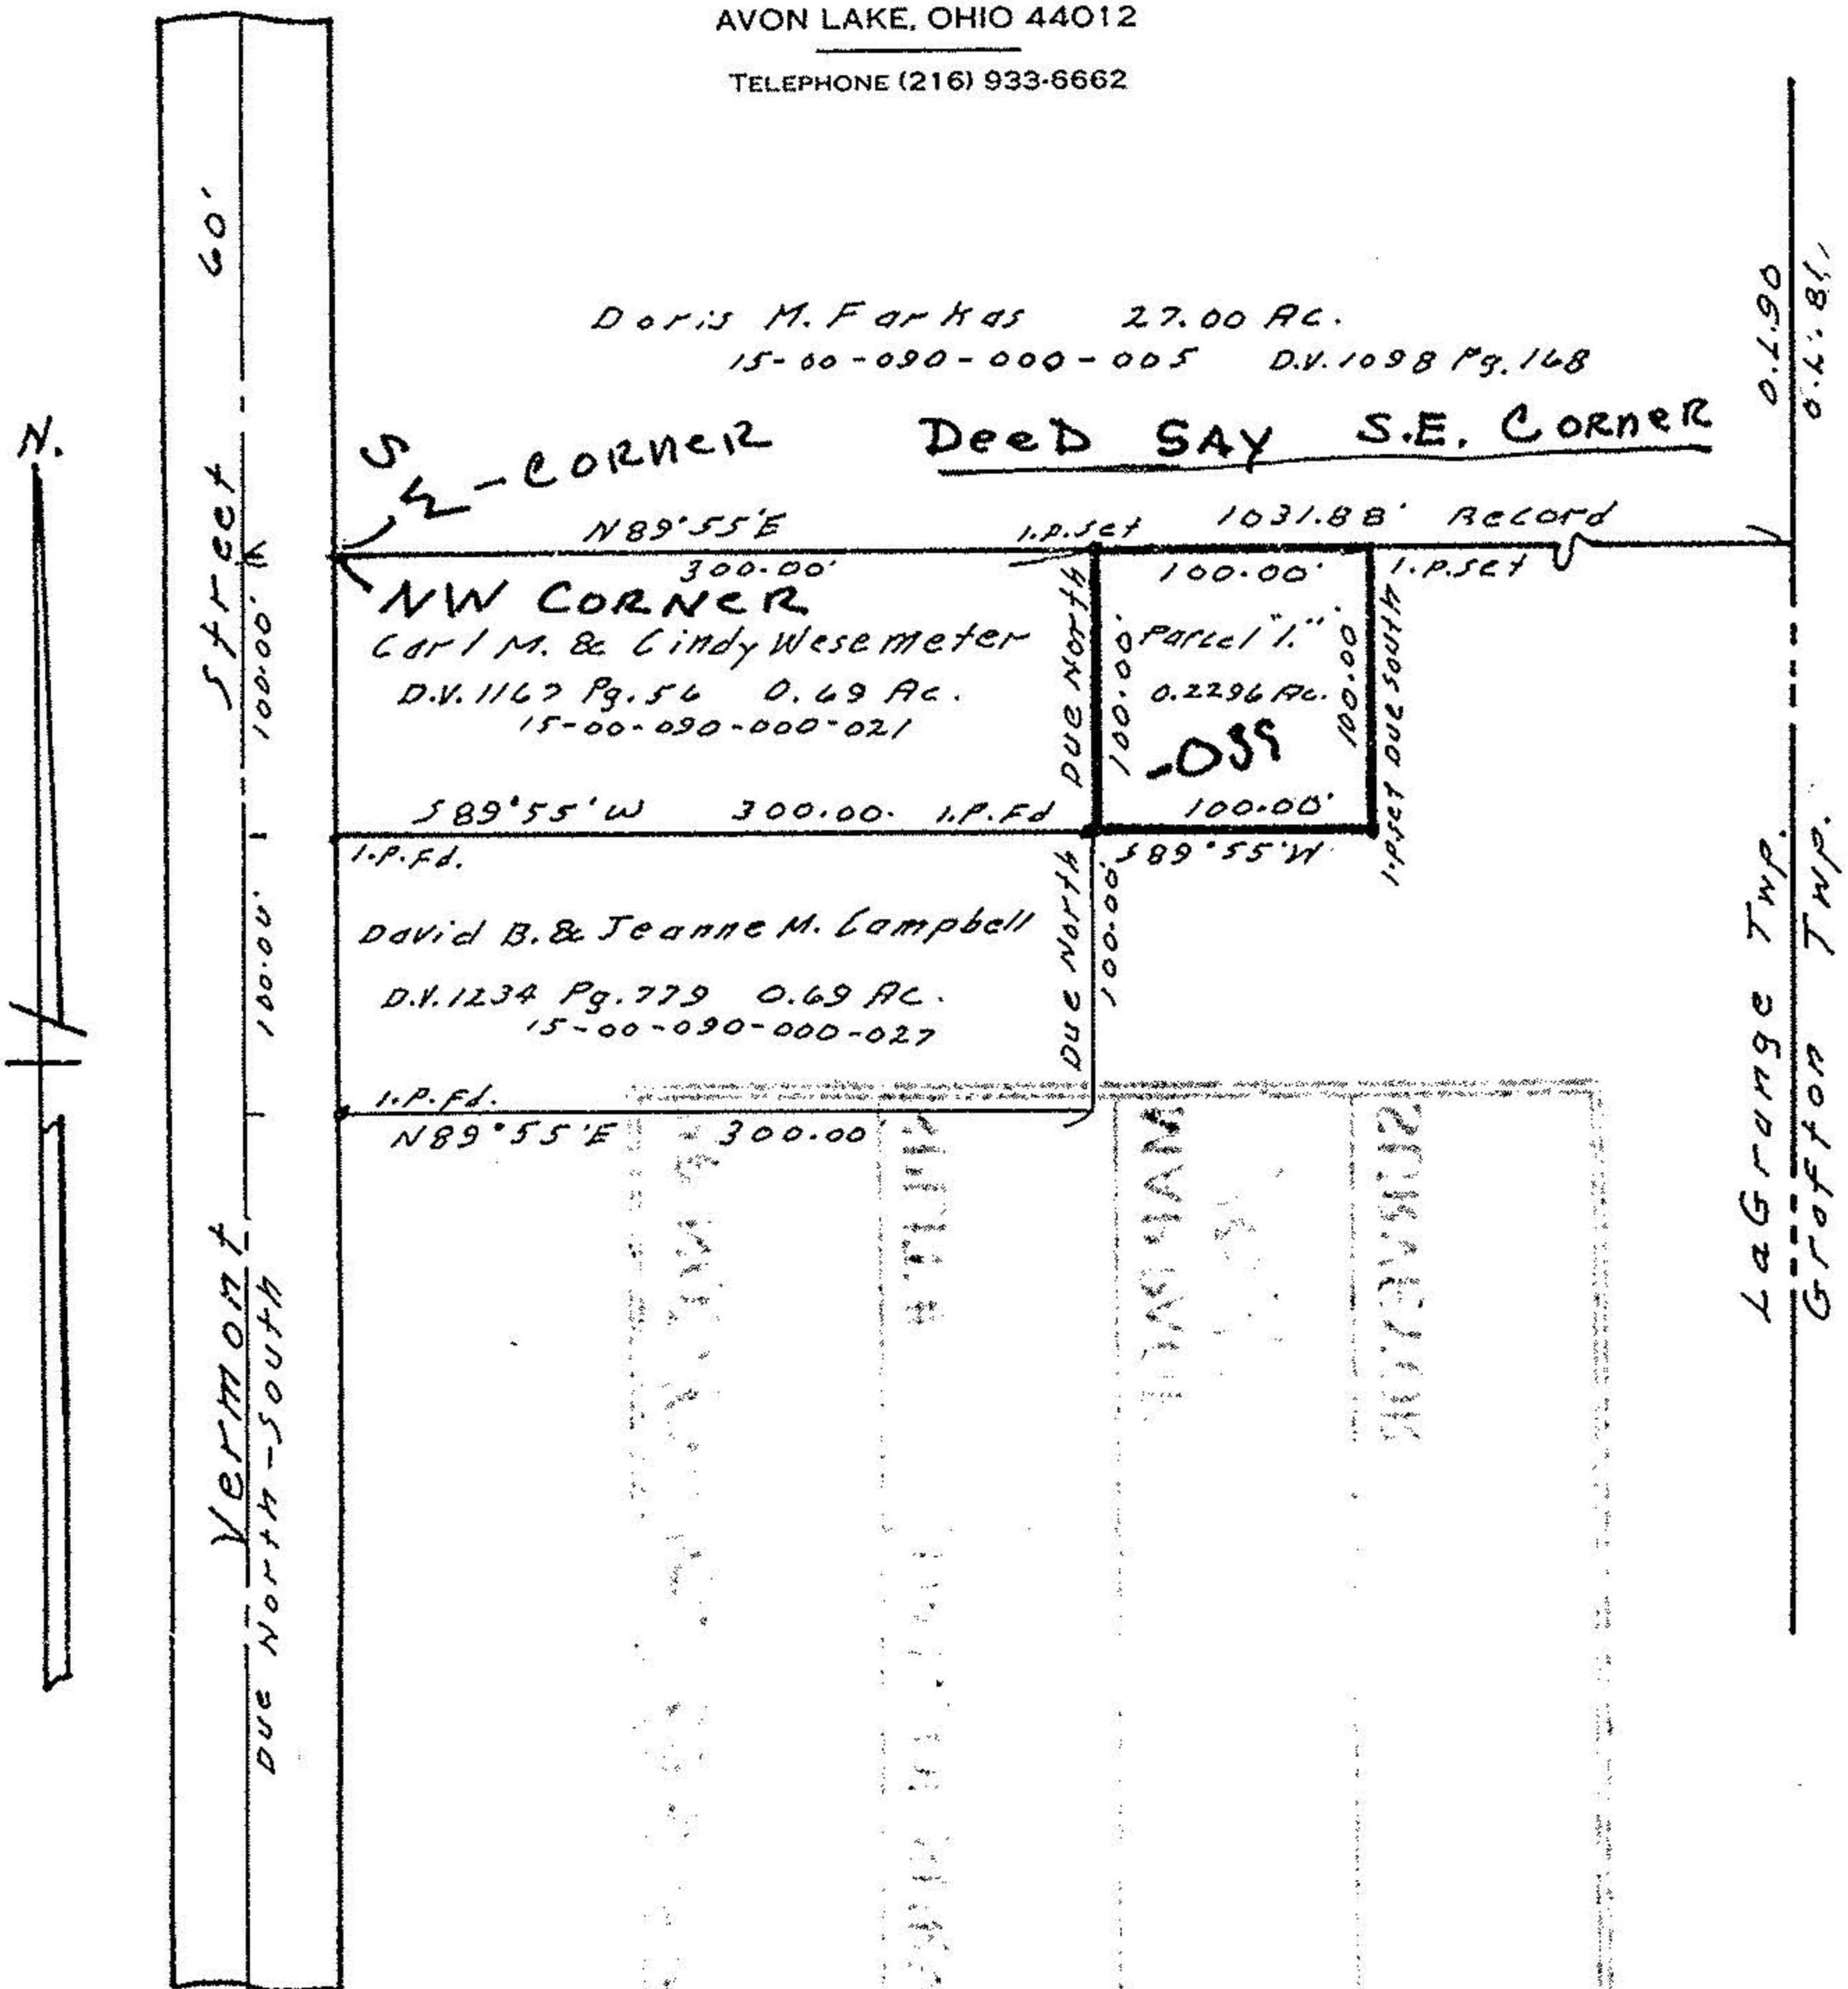

SURVEY  
 of  
 Part of Original Lot No. 90,  
 LaGrange Twp., Lorain Co., Ohio.  
 Scale 1"=100' Feb. 27, 1988.

