


NORTH  
SCALE 1" = 200'



# 19241

APPROVED
LORAIN CO.
MAP DEPT.
DATE 12-31-90
PAGE 15-H
BY CAROLYN FRANCIS
VOID AFTER #19241

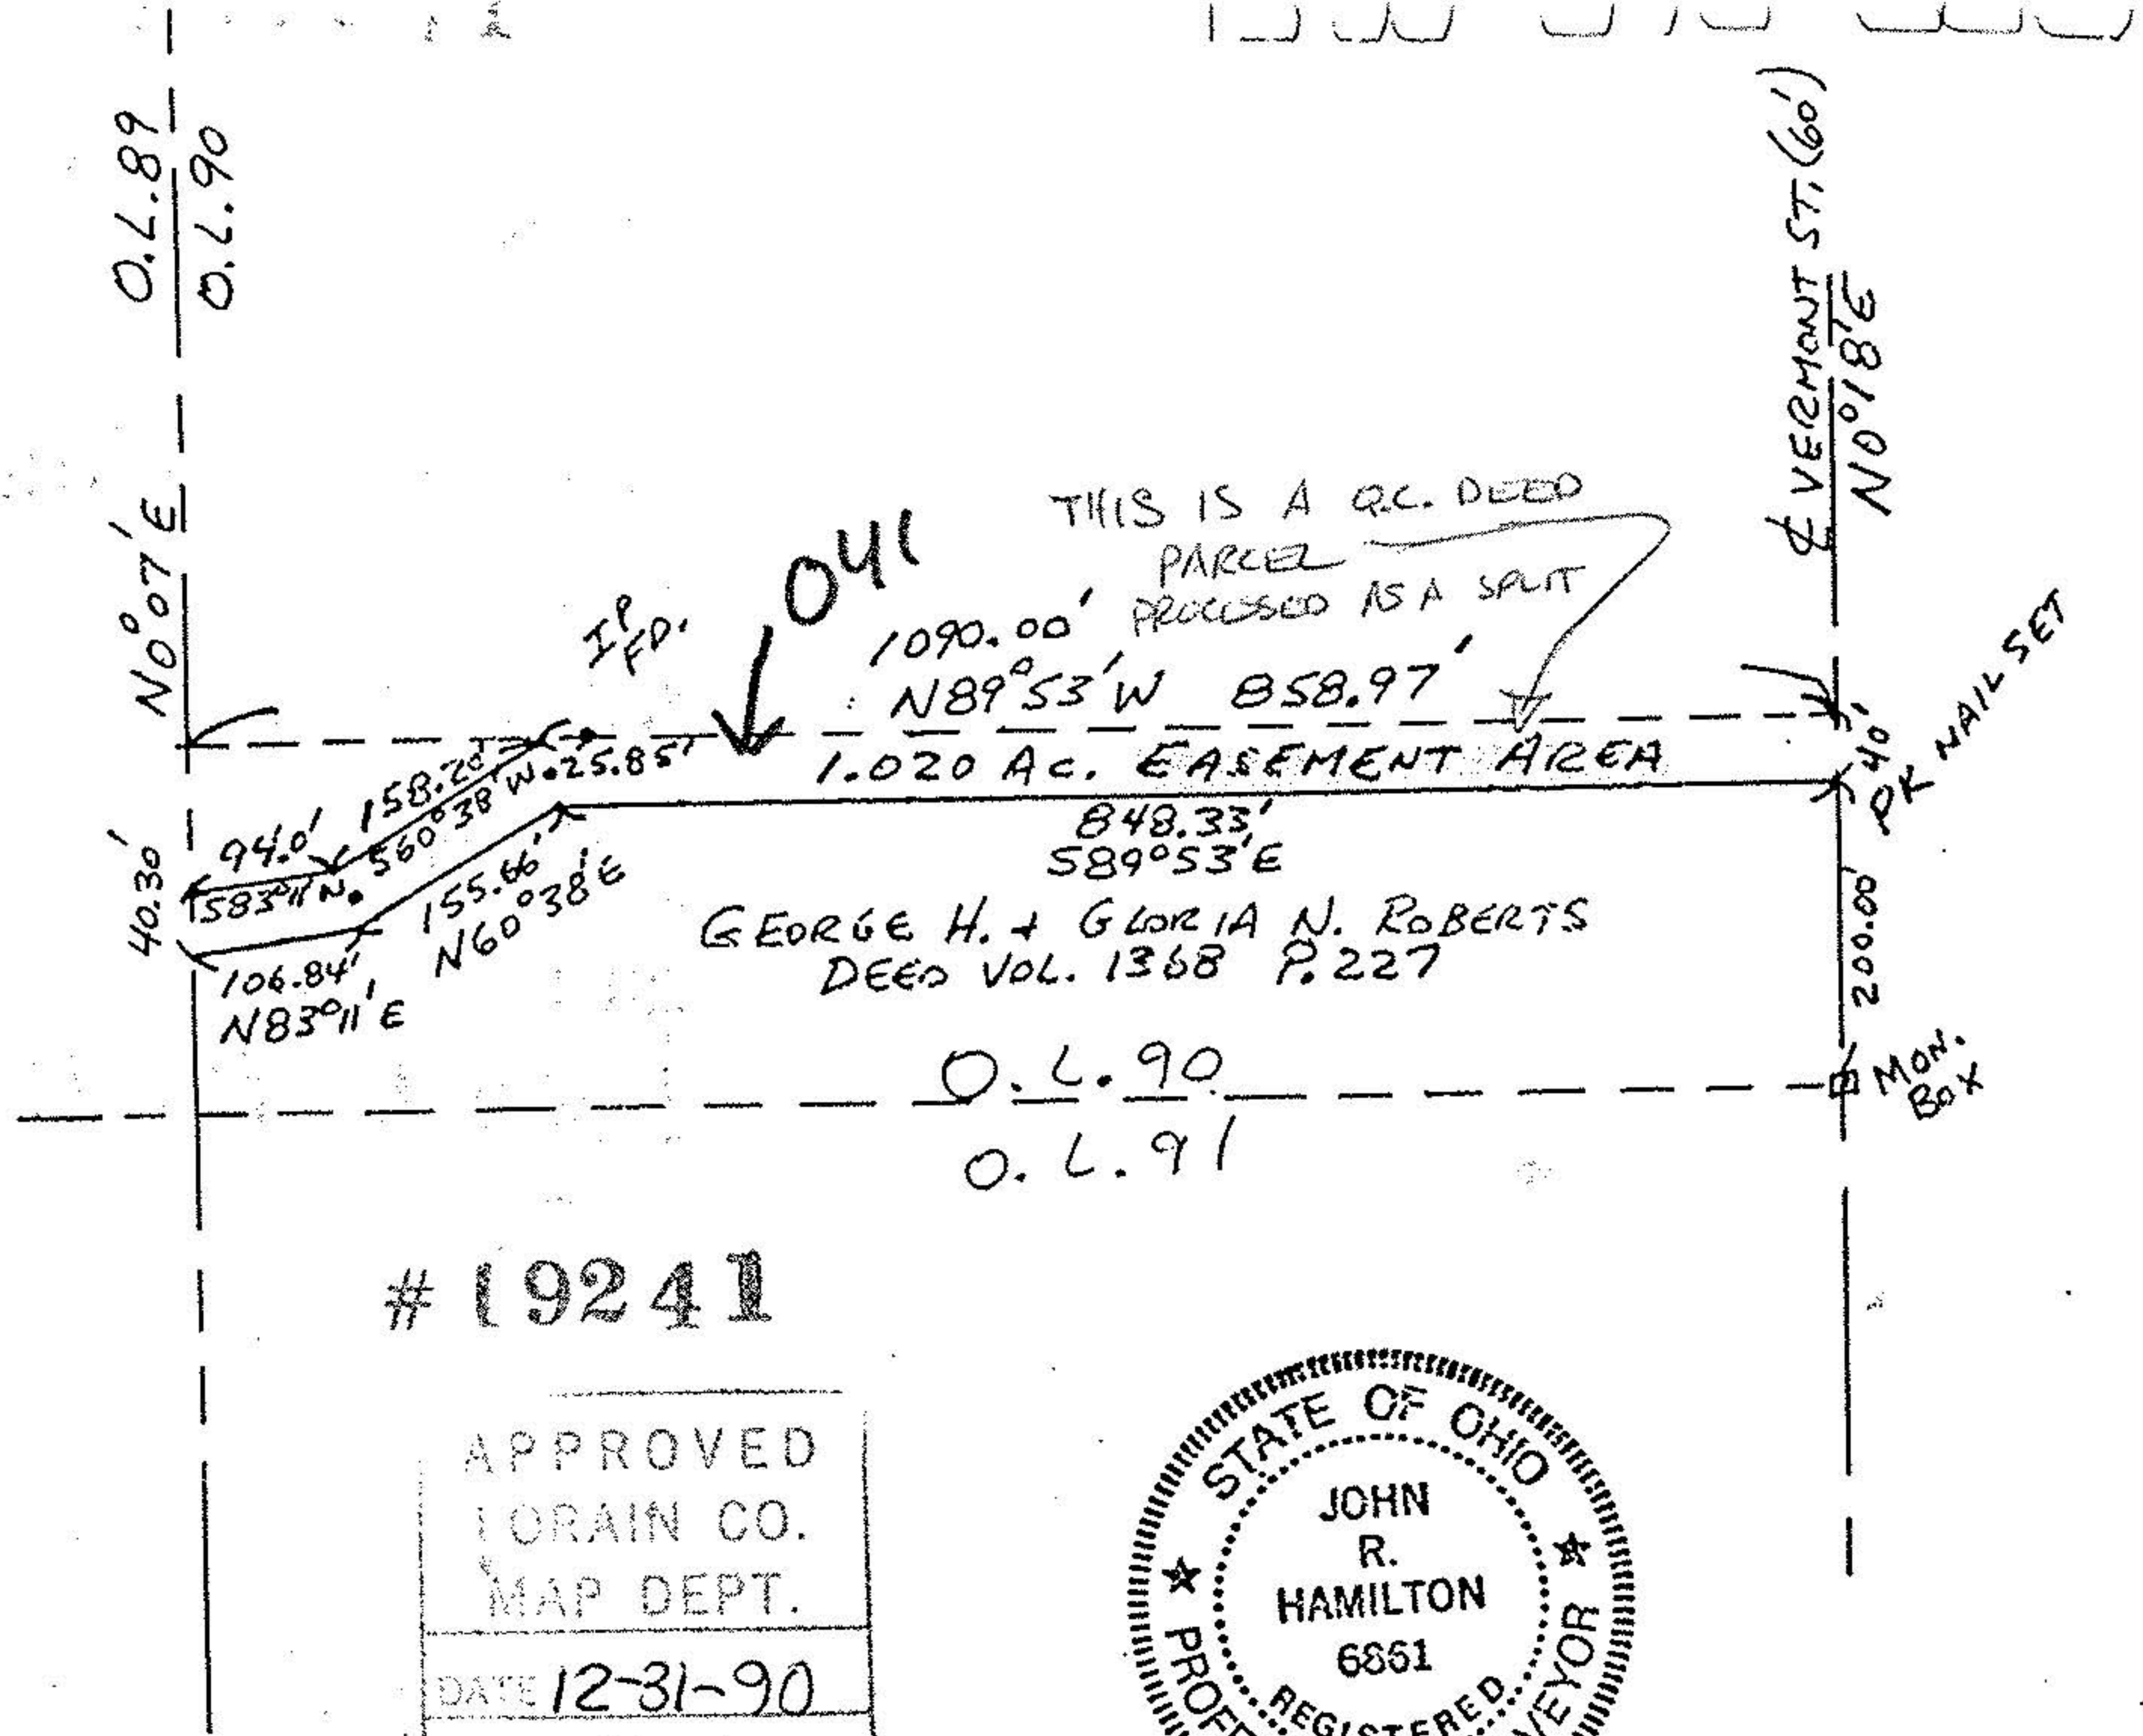

COPY

MAP OF SURVEY FOR GEORGE ROBERTS  
O.L. 90 - LAGRANGE TWP. - LORAIN CO.  
5/90  
SCALE 1" = 200'  
JOHN R. HAMILTON - REG. SURV. # 6861