


19241

1500-090-000

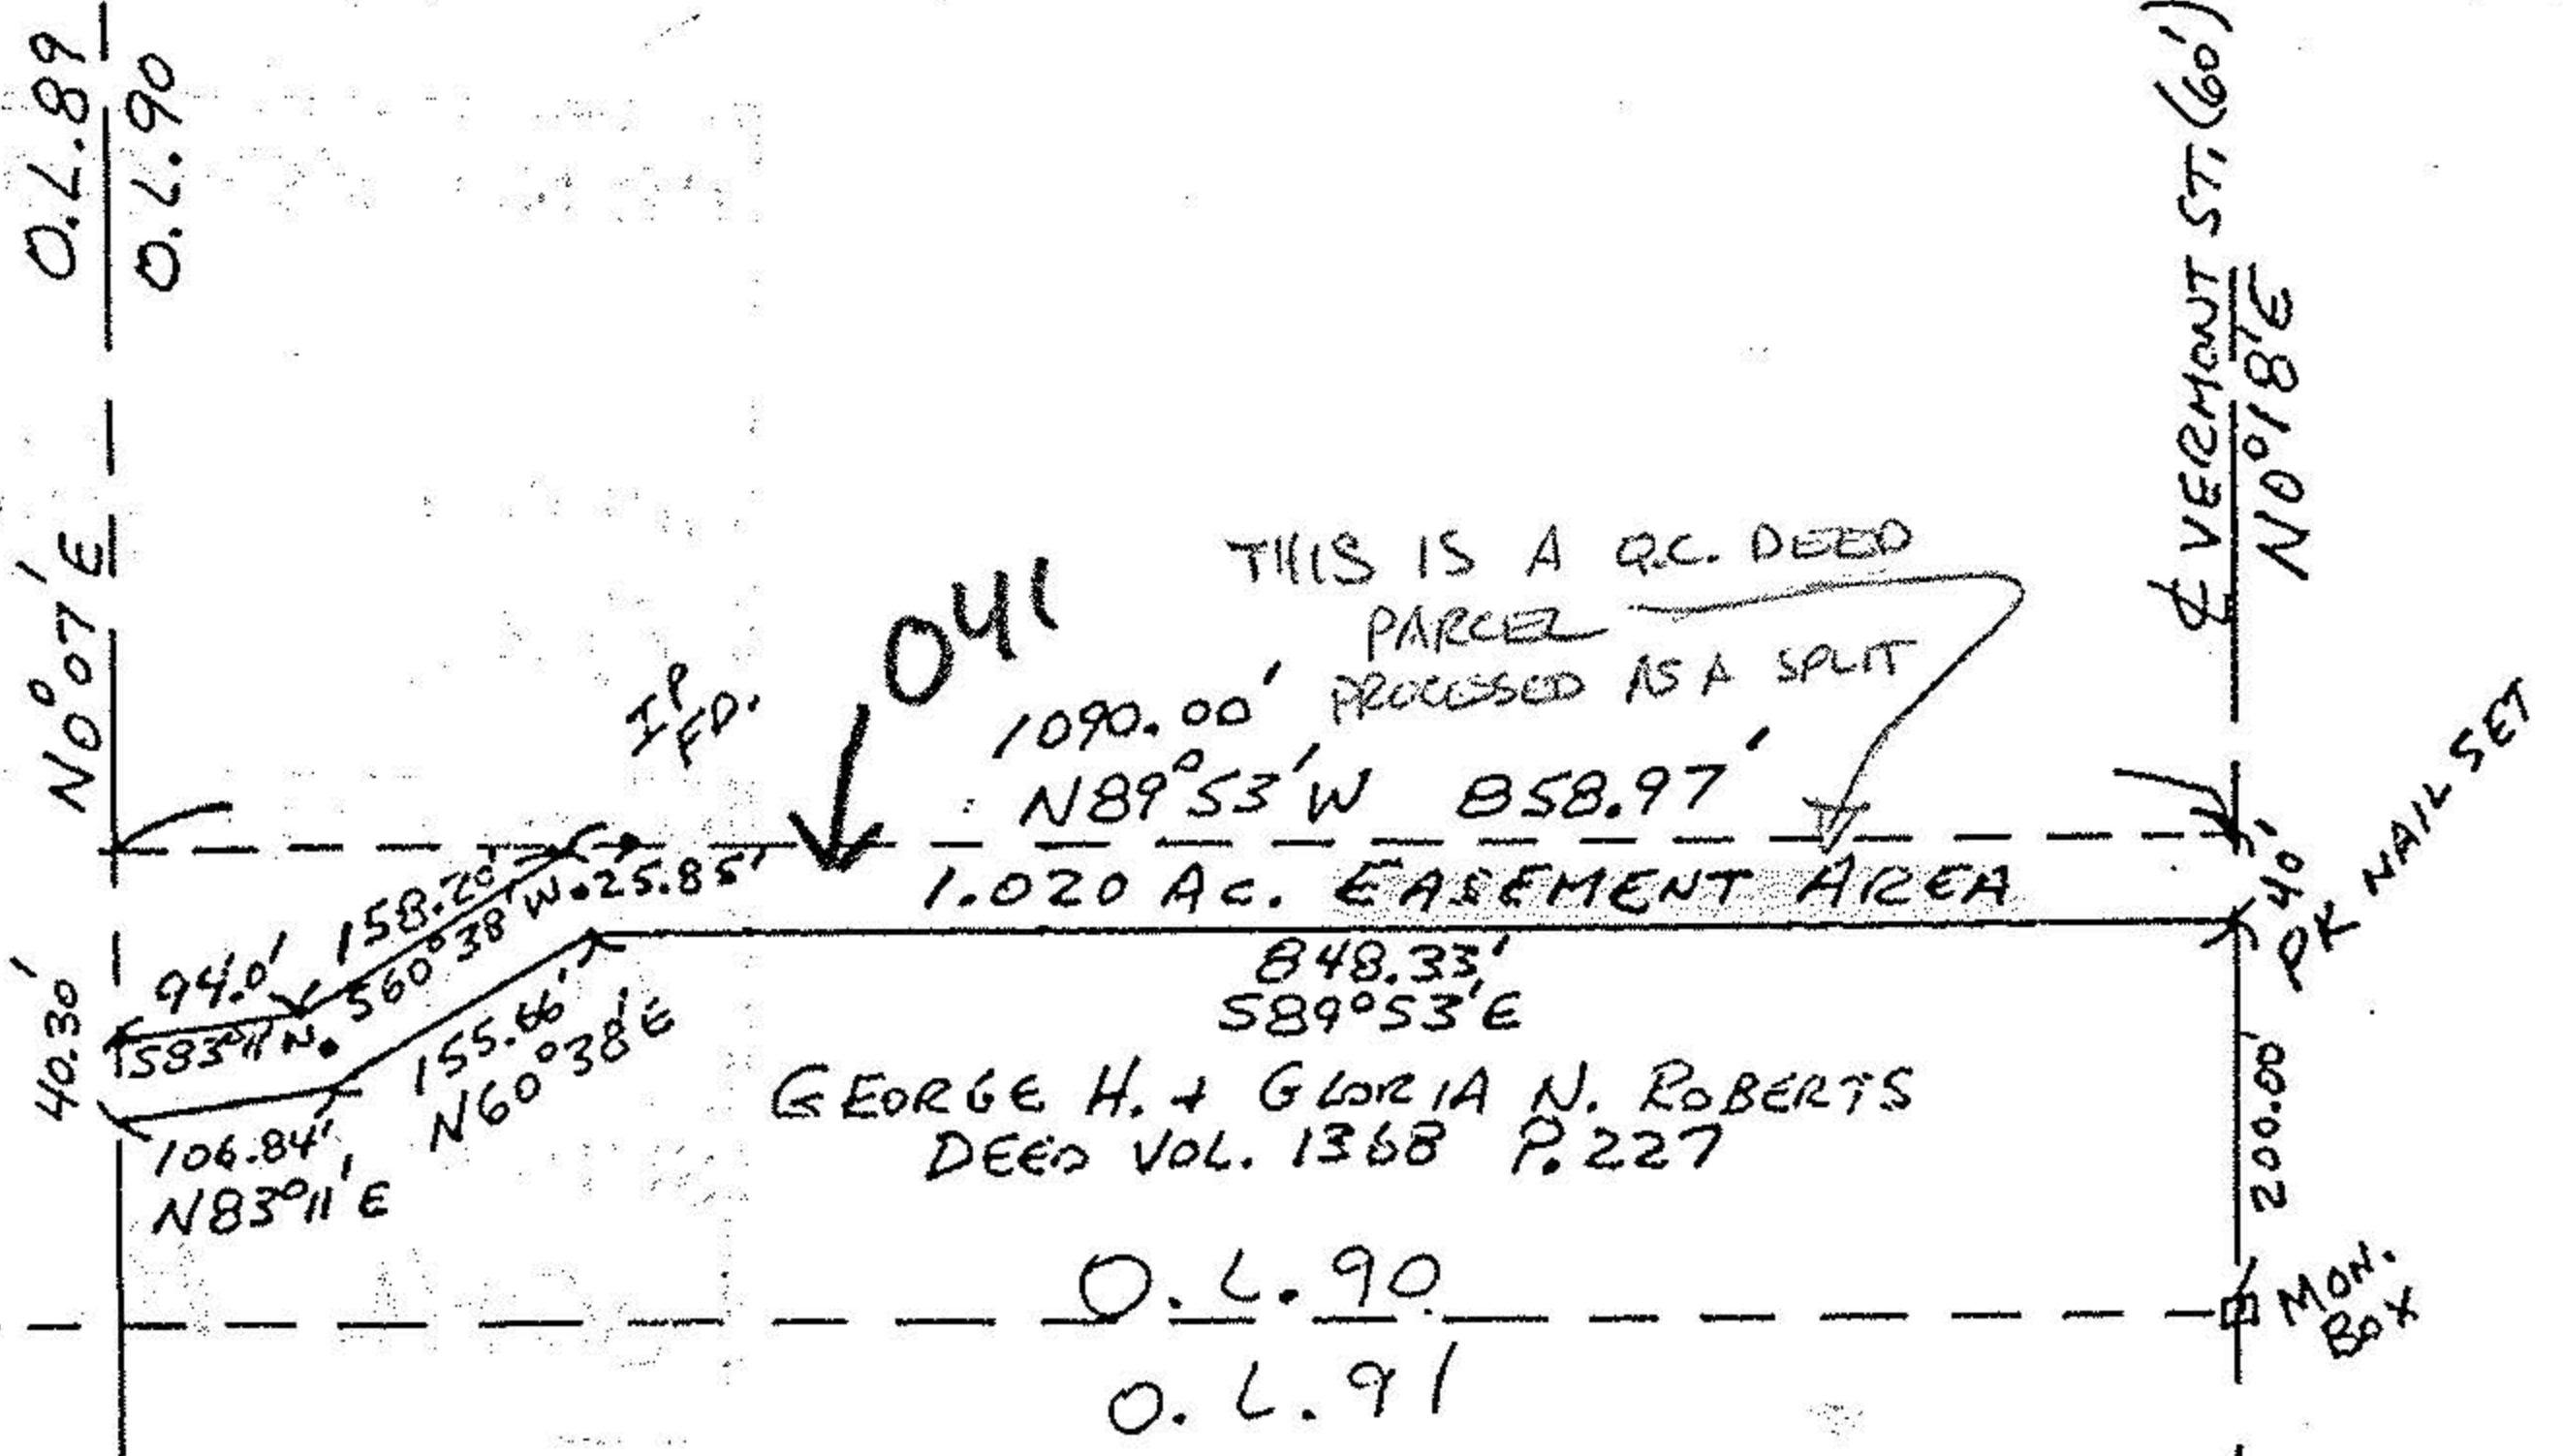

NORTH SCALE 1"=200'

19241

APPROVED
LORAIN CO.
MAP DEPT.
DATE 12-31-90
PAGE 15-H
BY CAROLYN FRANCIS
VOID AFTER #19241



COPY

MAP OF SURVEY FOR GEORGE ROBERTS
 O.L. 90 - LAGRANGE TWP. - LORAIN CO.
 5/90
 SCALE 1"=200'
 JOHN R. HAMILTON - REG. SURV. # 6861