


15-00-090-000

15-H

WILLIAM B. BARTON
Reg. Land Surveyor No. 4438
188 PARKWOOD AVENUE
AVON LAKE, OHIO 44012
TELEPHONE (216) 933-6662

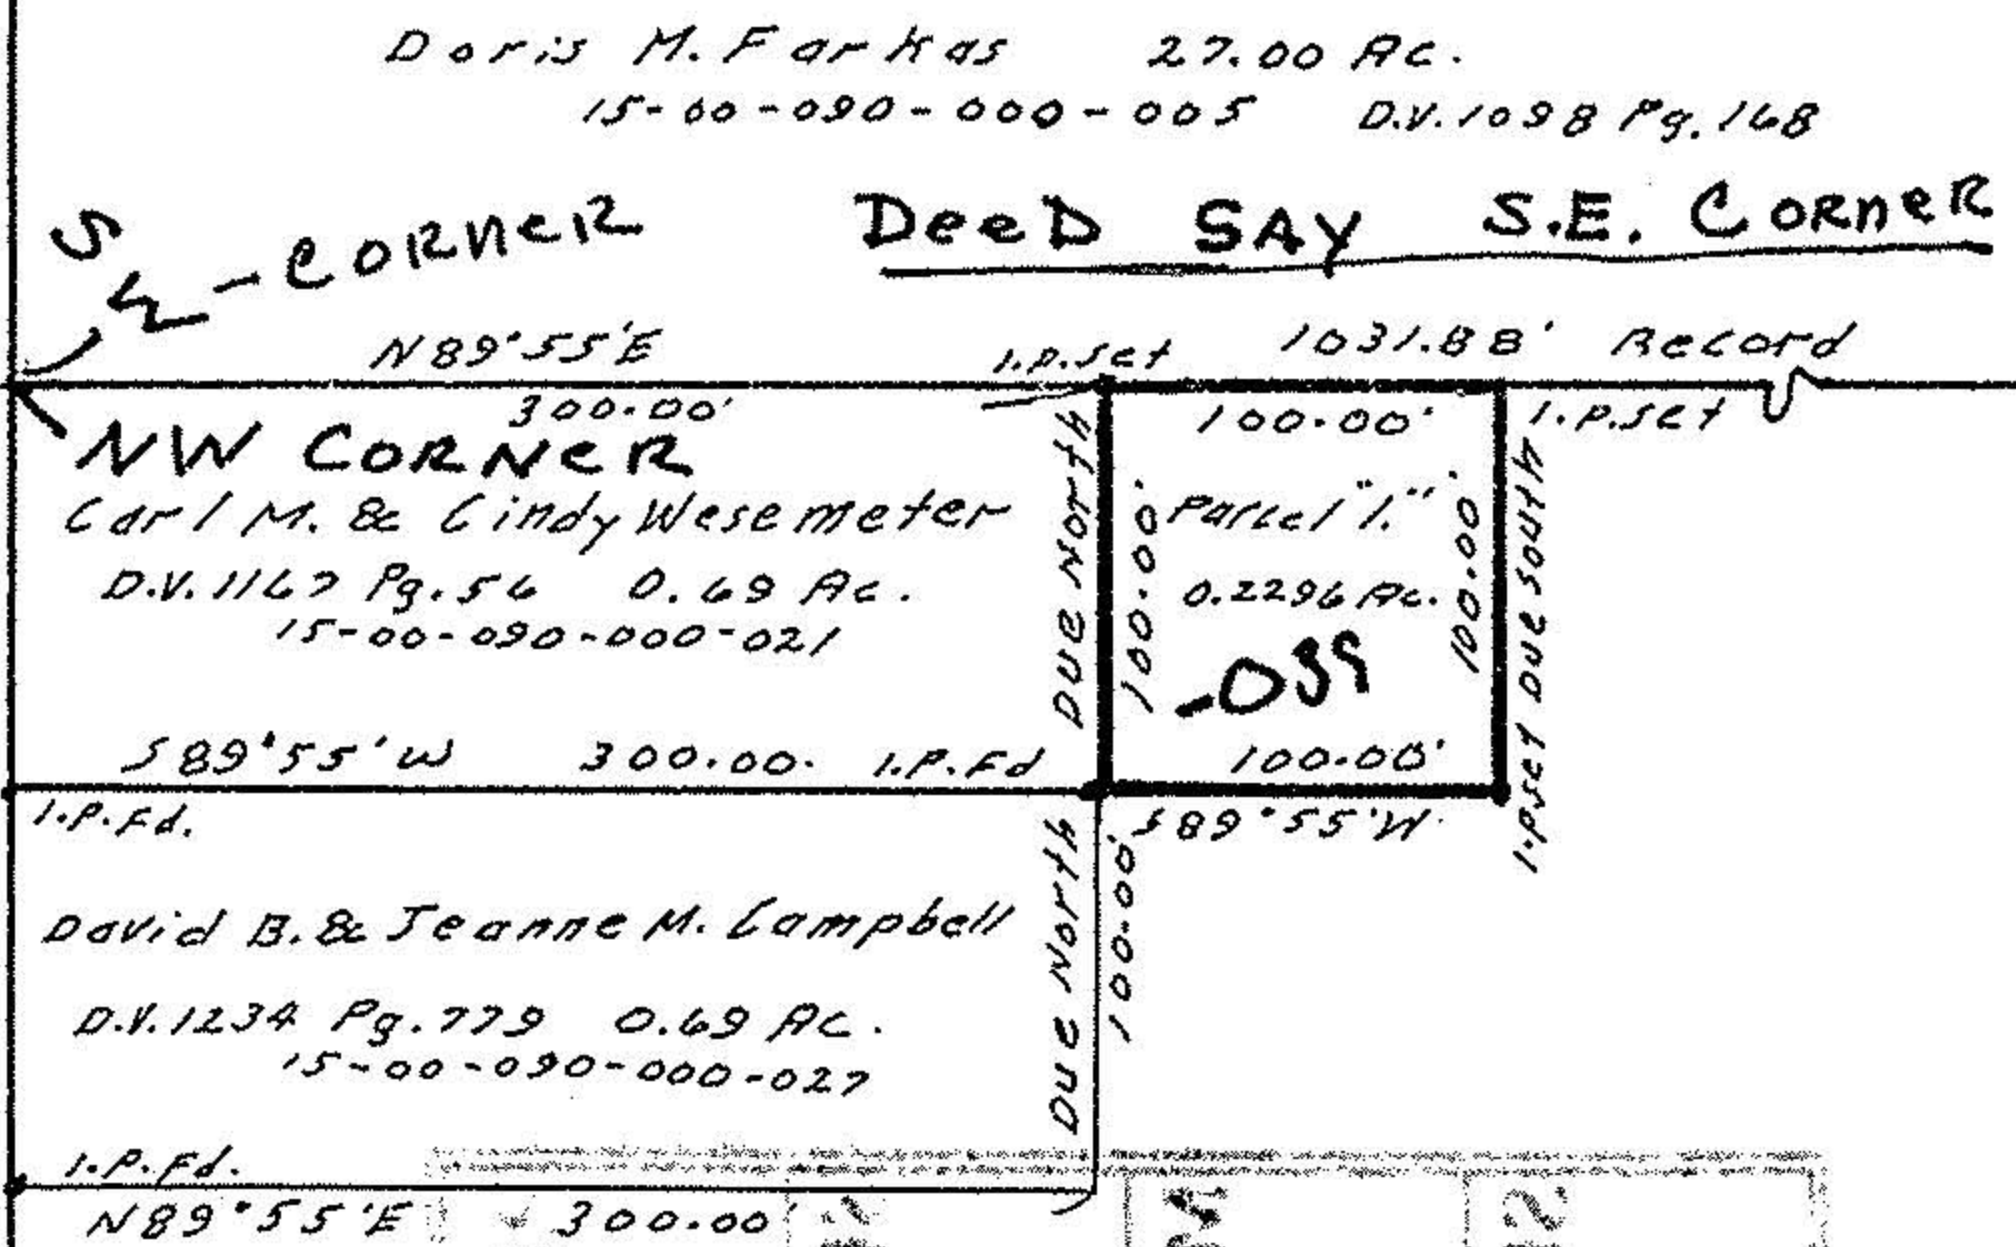

SURVEY
of
Part of Original Lot No. 90,
LaGrange Twp., Lorain Co., Ohio.
Scale 1"=100' Feb. 27, 1988.

