


Map of part of Lot 2 Russia Twp. Lorain Co. Ohio
 Scale 1" = 100'
 April 8, 1986
 By Arnold F. Koepp Reg. Surveyor No. 4306

Lot 1 RUSSIA TWP
 Lot 2 RUSSIA TWP

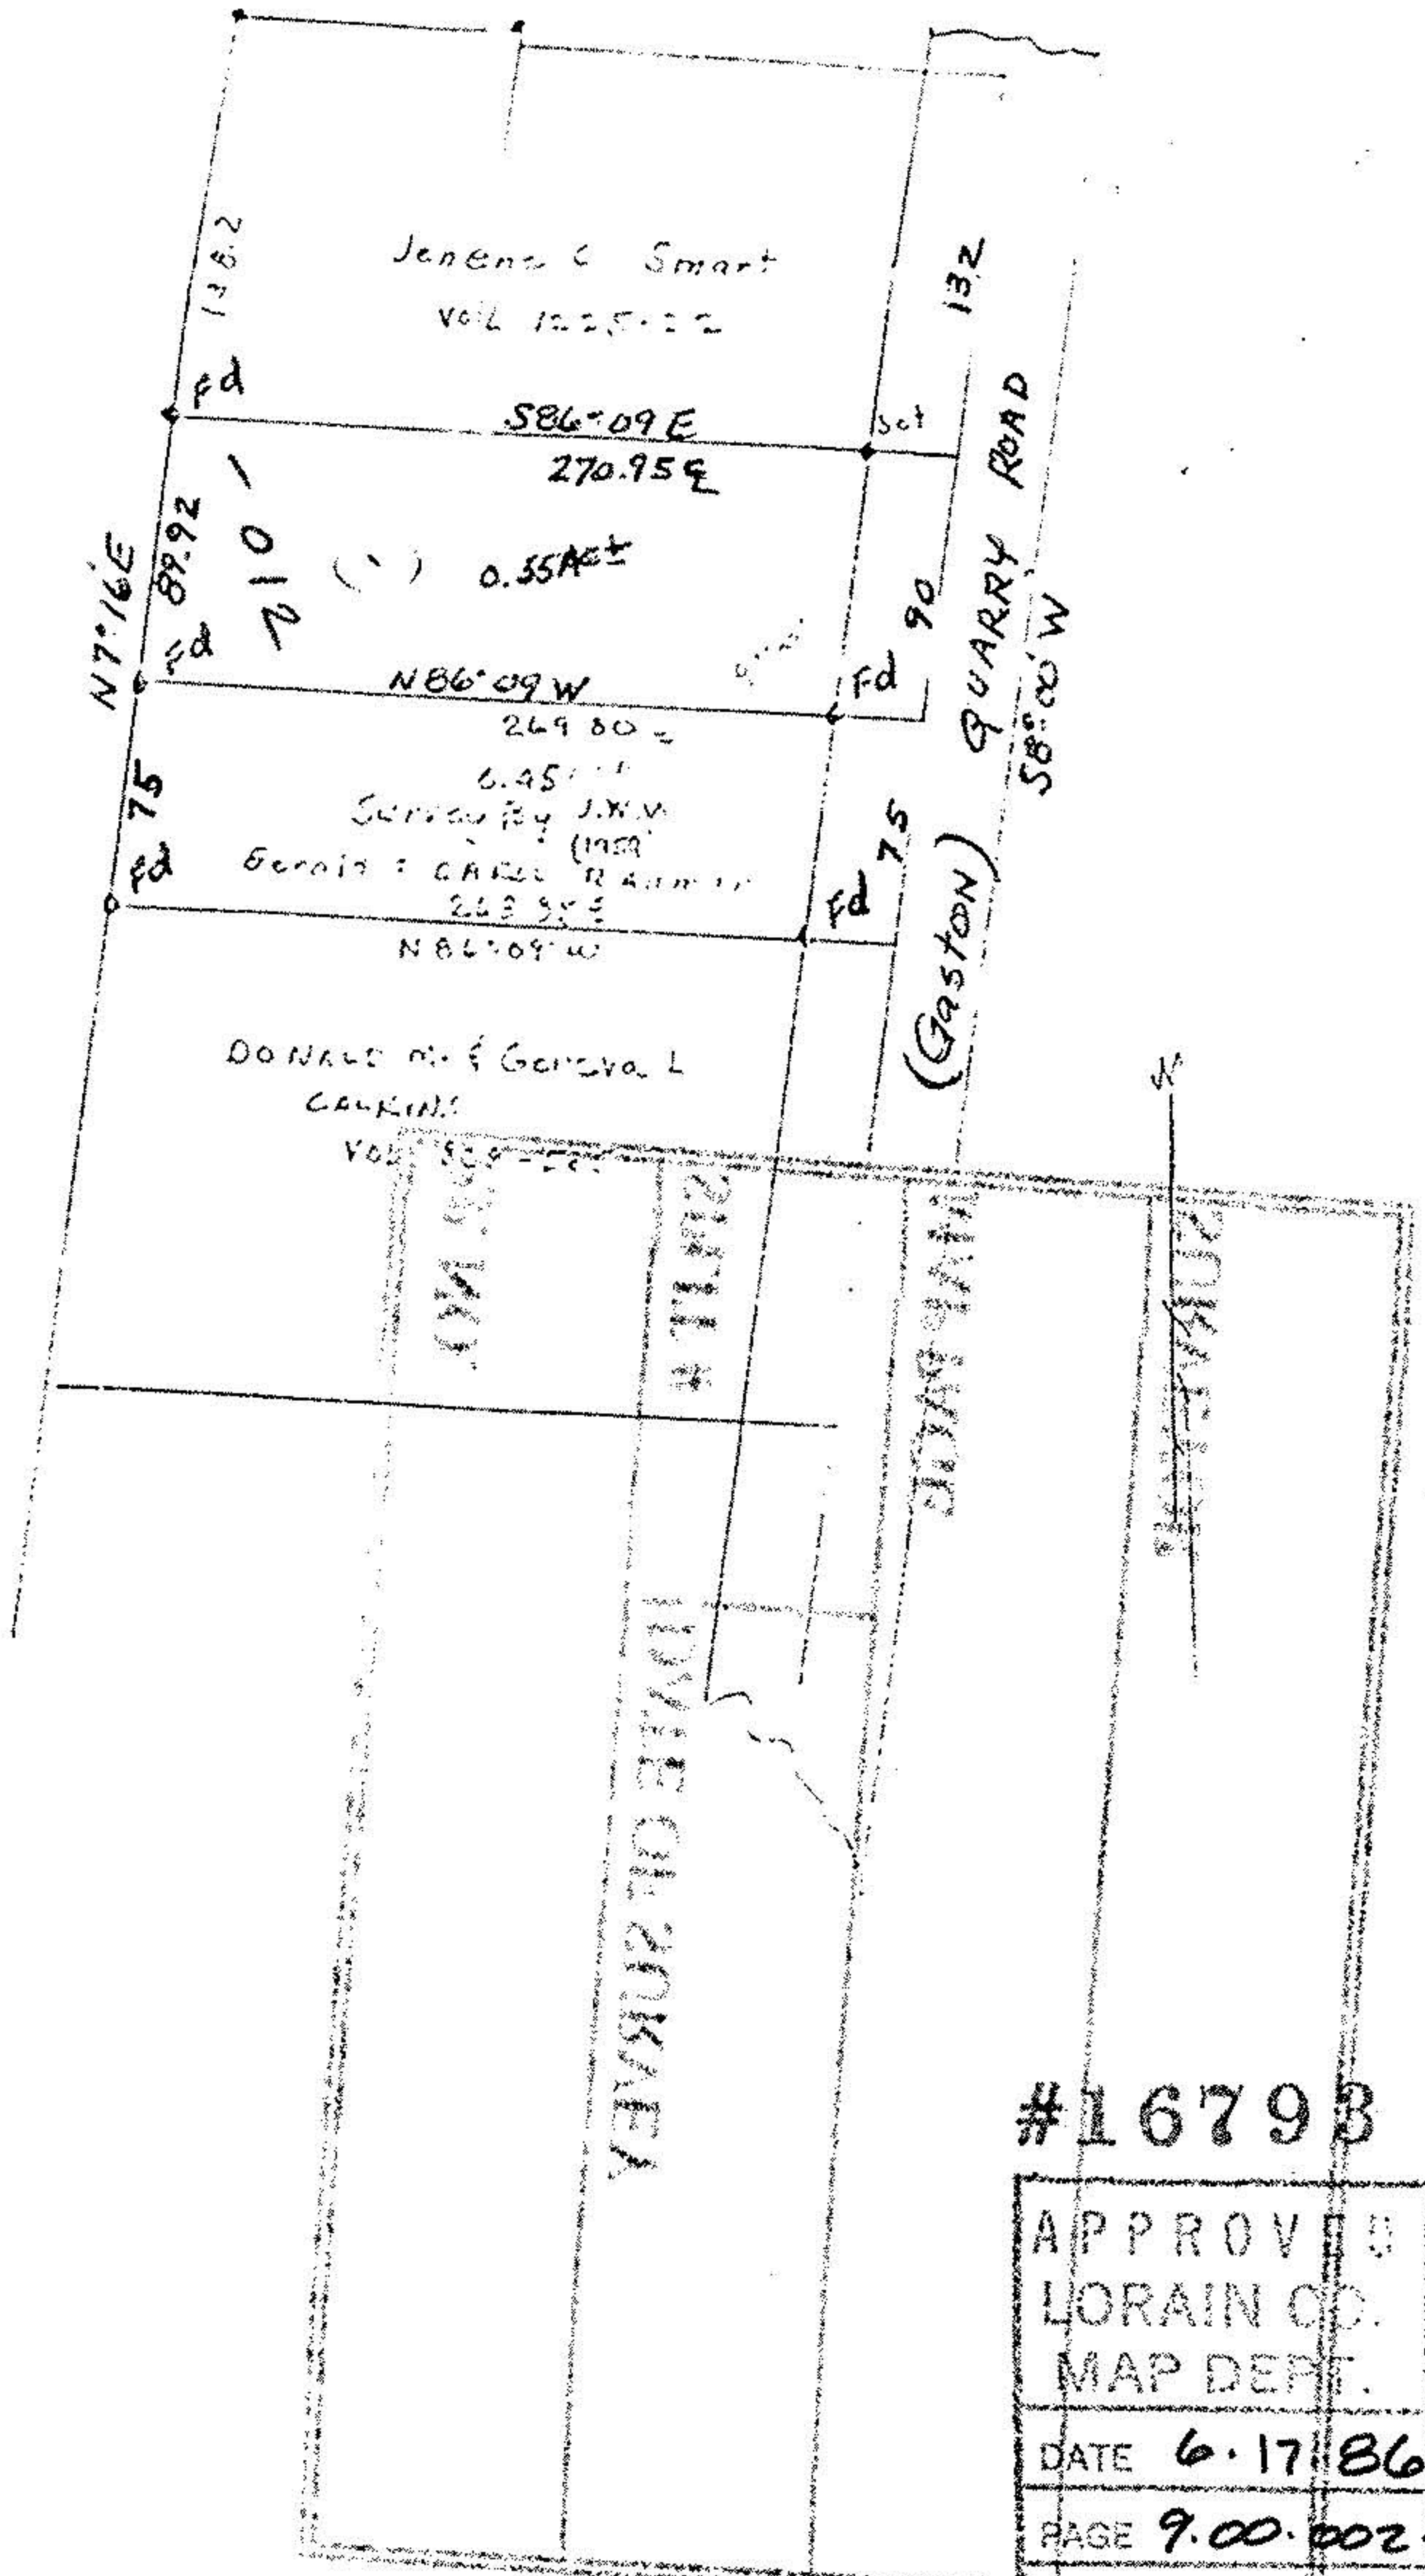

DONALD M. & GERVA L
 CARLINS

Jenens C Smart
 Vol 1225-22

Survey By J.M.M.
 (1983)
 Gerald & Gervia L
 Carlins

#16793

APPROVED
LORAIN CO.
MAP DEPT.
DATE 6.17.86
PAGE 9.00.002
BY T. McMain
VOID AFTER

9-00-002-A

09-00-002-000

A