


09-00-009-000

#17168

9-D

WILLIAM B. BARTON  
Reg. Land Surveyor No. 4438  
188 PARKWOOD AVENUE  
AVON LAKE, OHIO 44012  
TELEPHONE (216) 933-6662

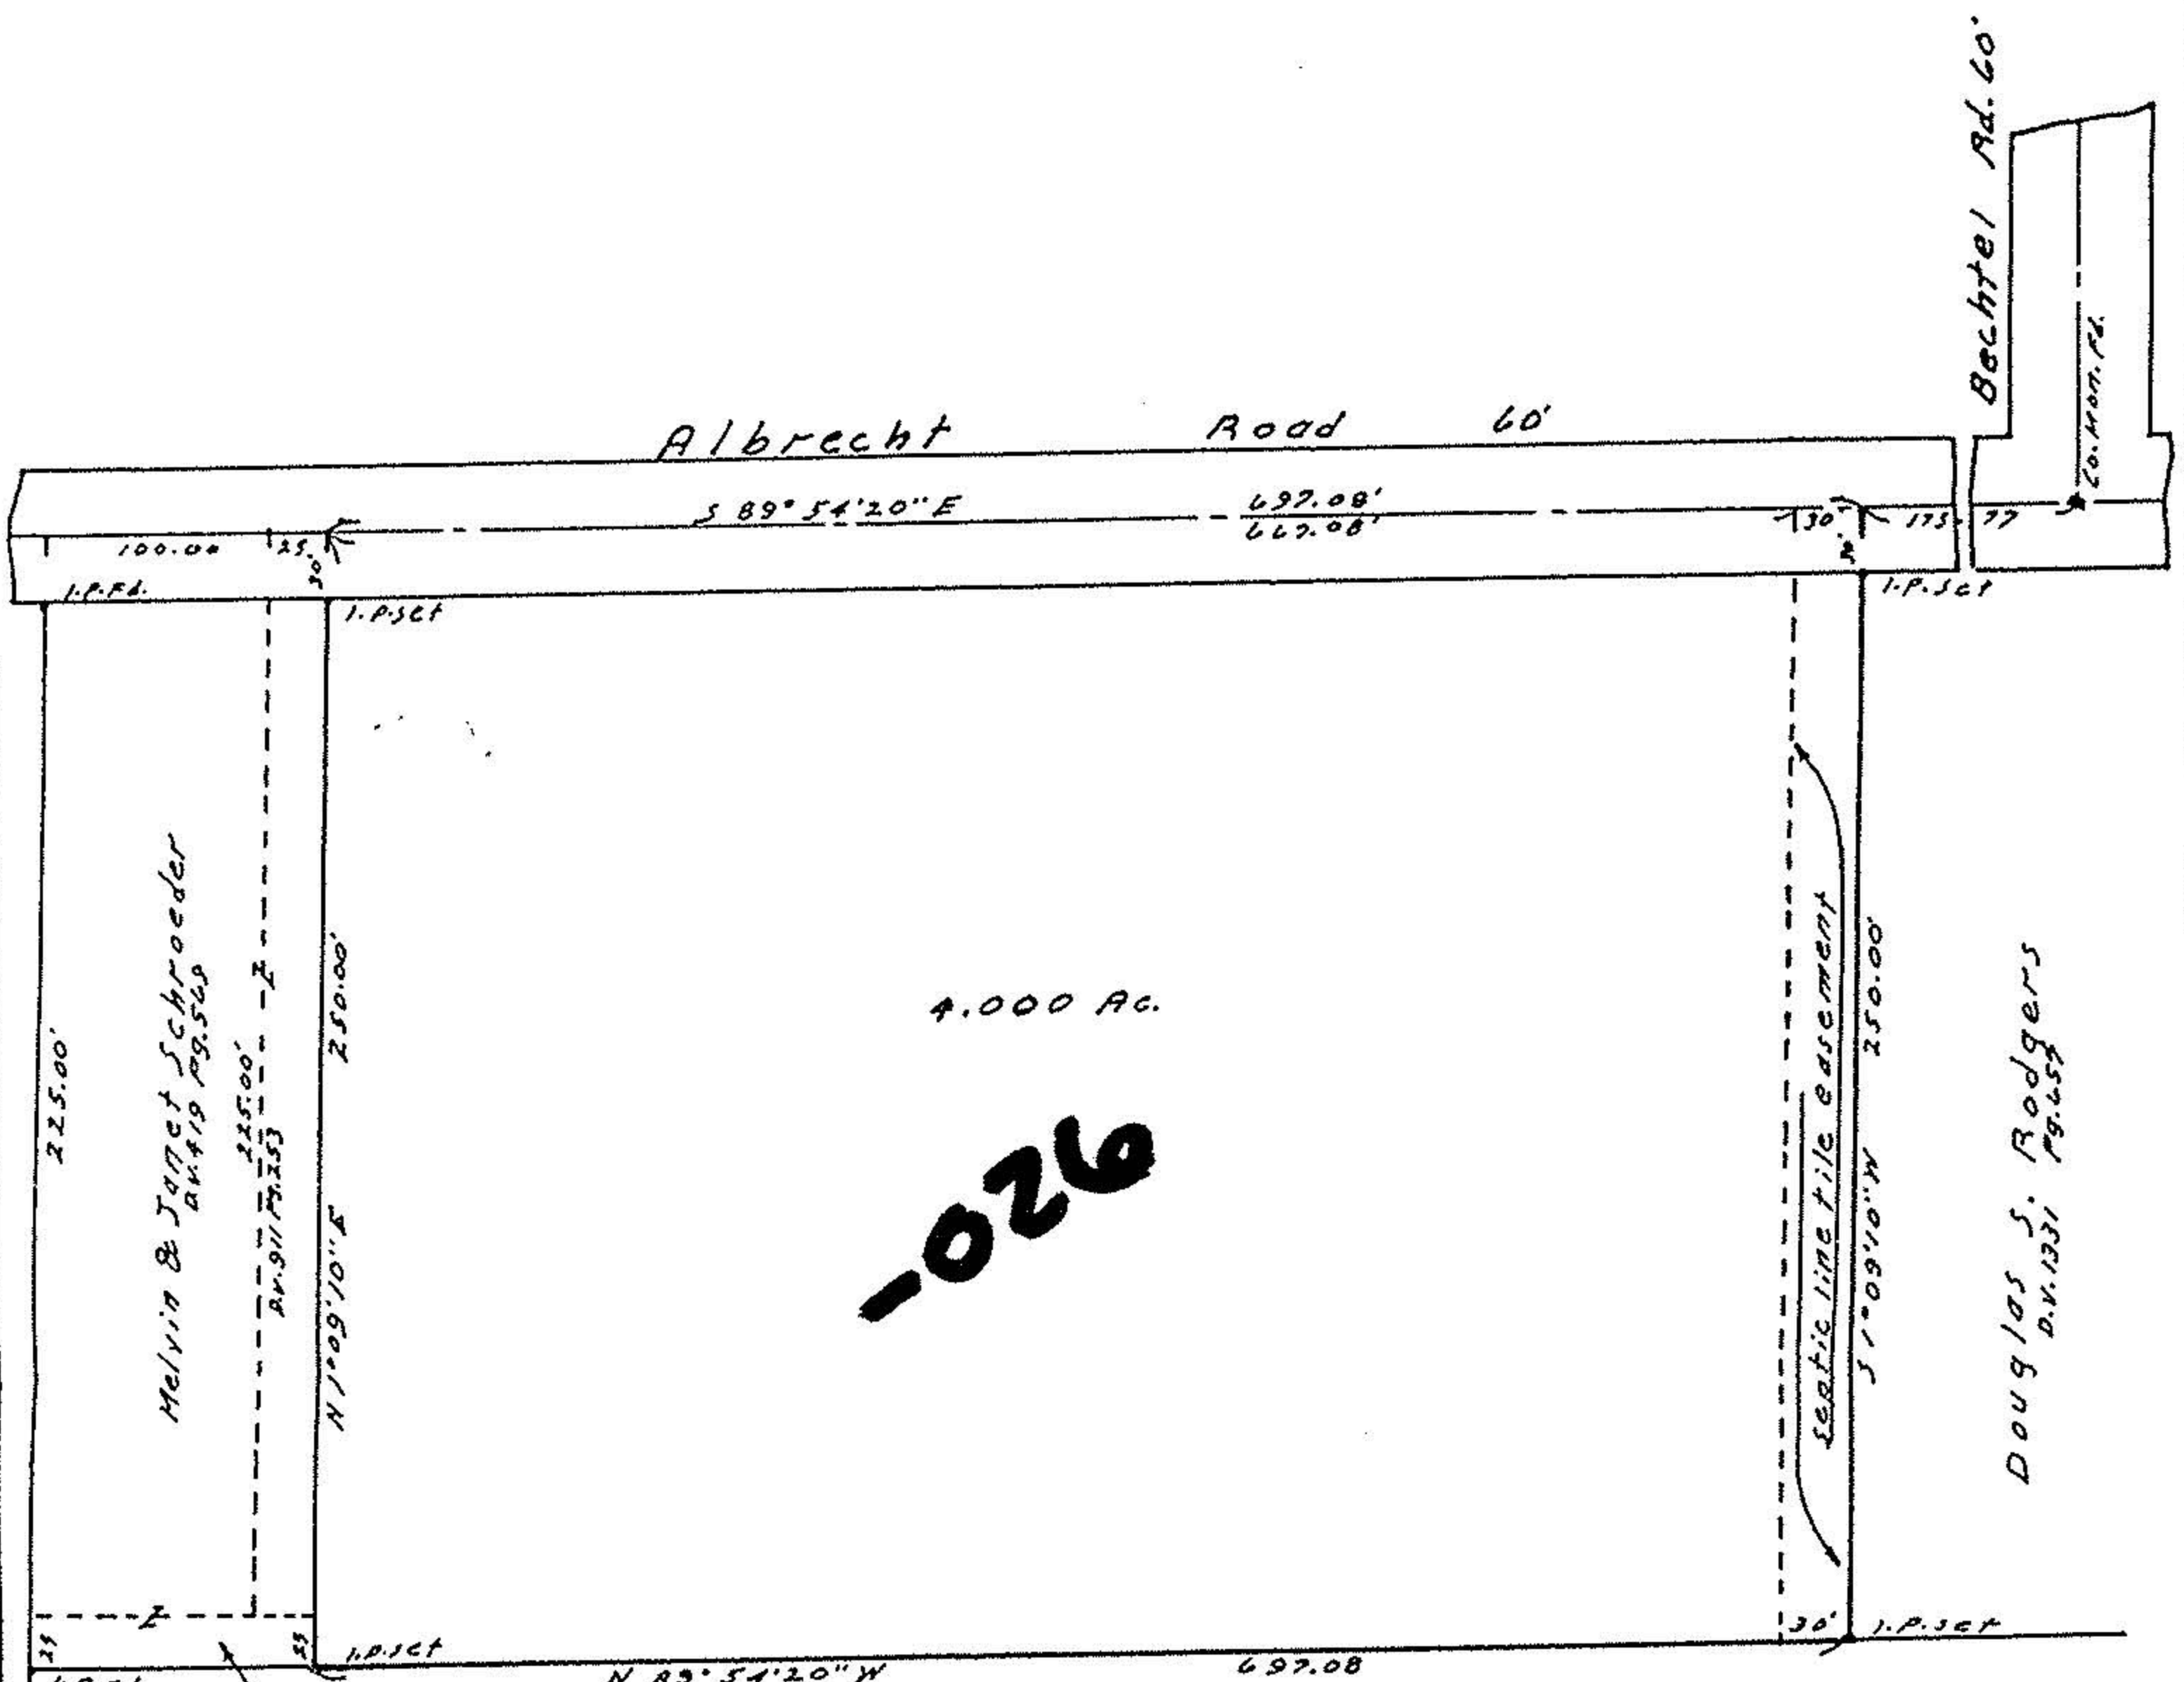

4.000 AC.

920-

D.V. 1306  
Pg. 292

Lorain County Regional Airport  
D.V. 935 Pg. 423

SURVEY

of  
Part of Original Lot No. 9 of Russia  
Township, Lorain County, Ohio.  
Scale 1"=100'      October 30, 1986

#17168

APPROVED LORAIN CO. MAP DEPT.	
DATE 12-22-86	
PAGE 9-D	
BY T. McMain	
VOID AFTER	

