


TOWNSHIP, VILLAGE, CITY CARLISLE LOT 101 TRACT  
SUBDIVISION \_\_\_\_\_ SUBLOT # \_\_\_\_\_

PROPERTY OWNER RAY WENSINK to Smith 5542

#5542 10-00-009-101

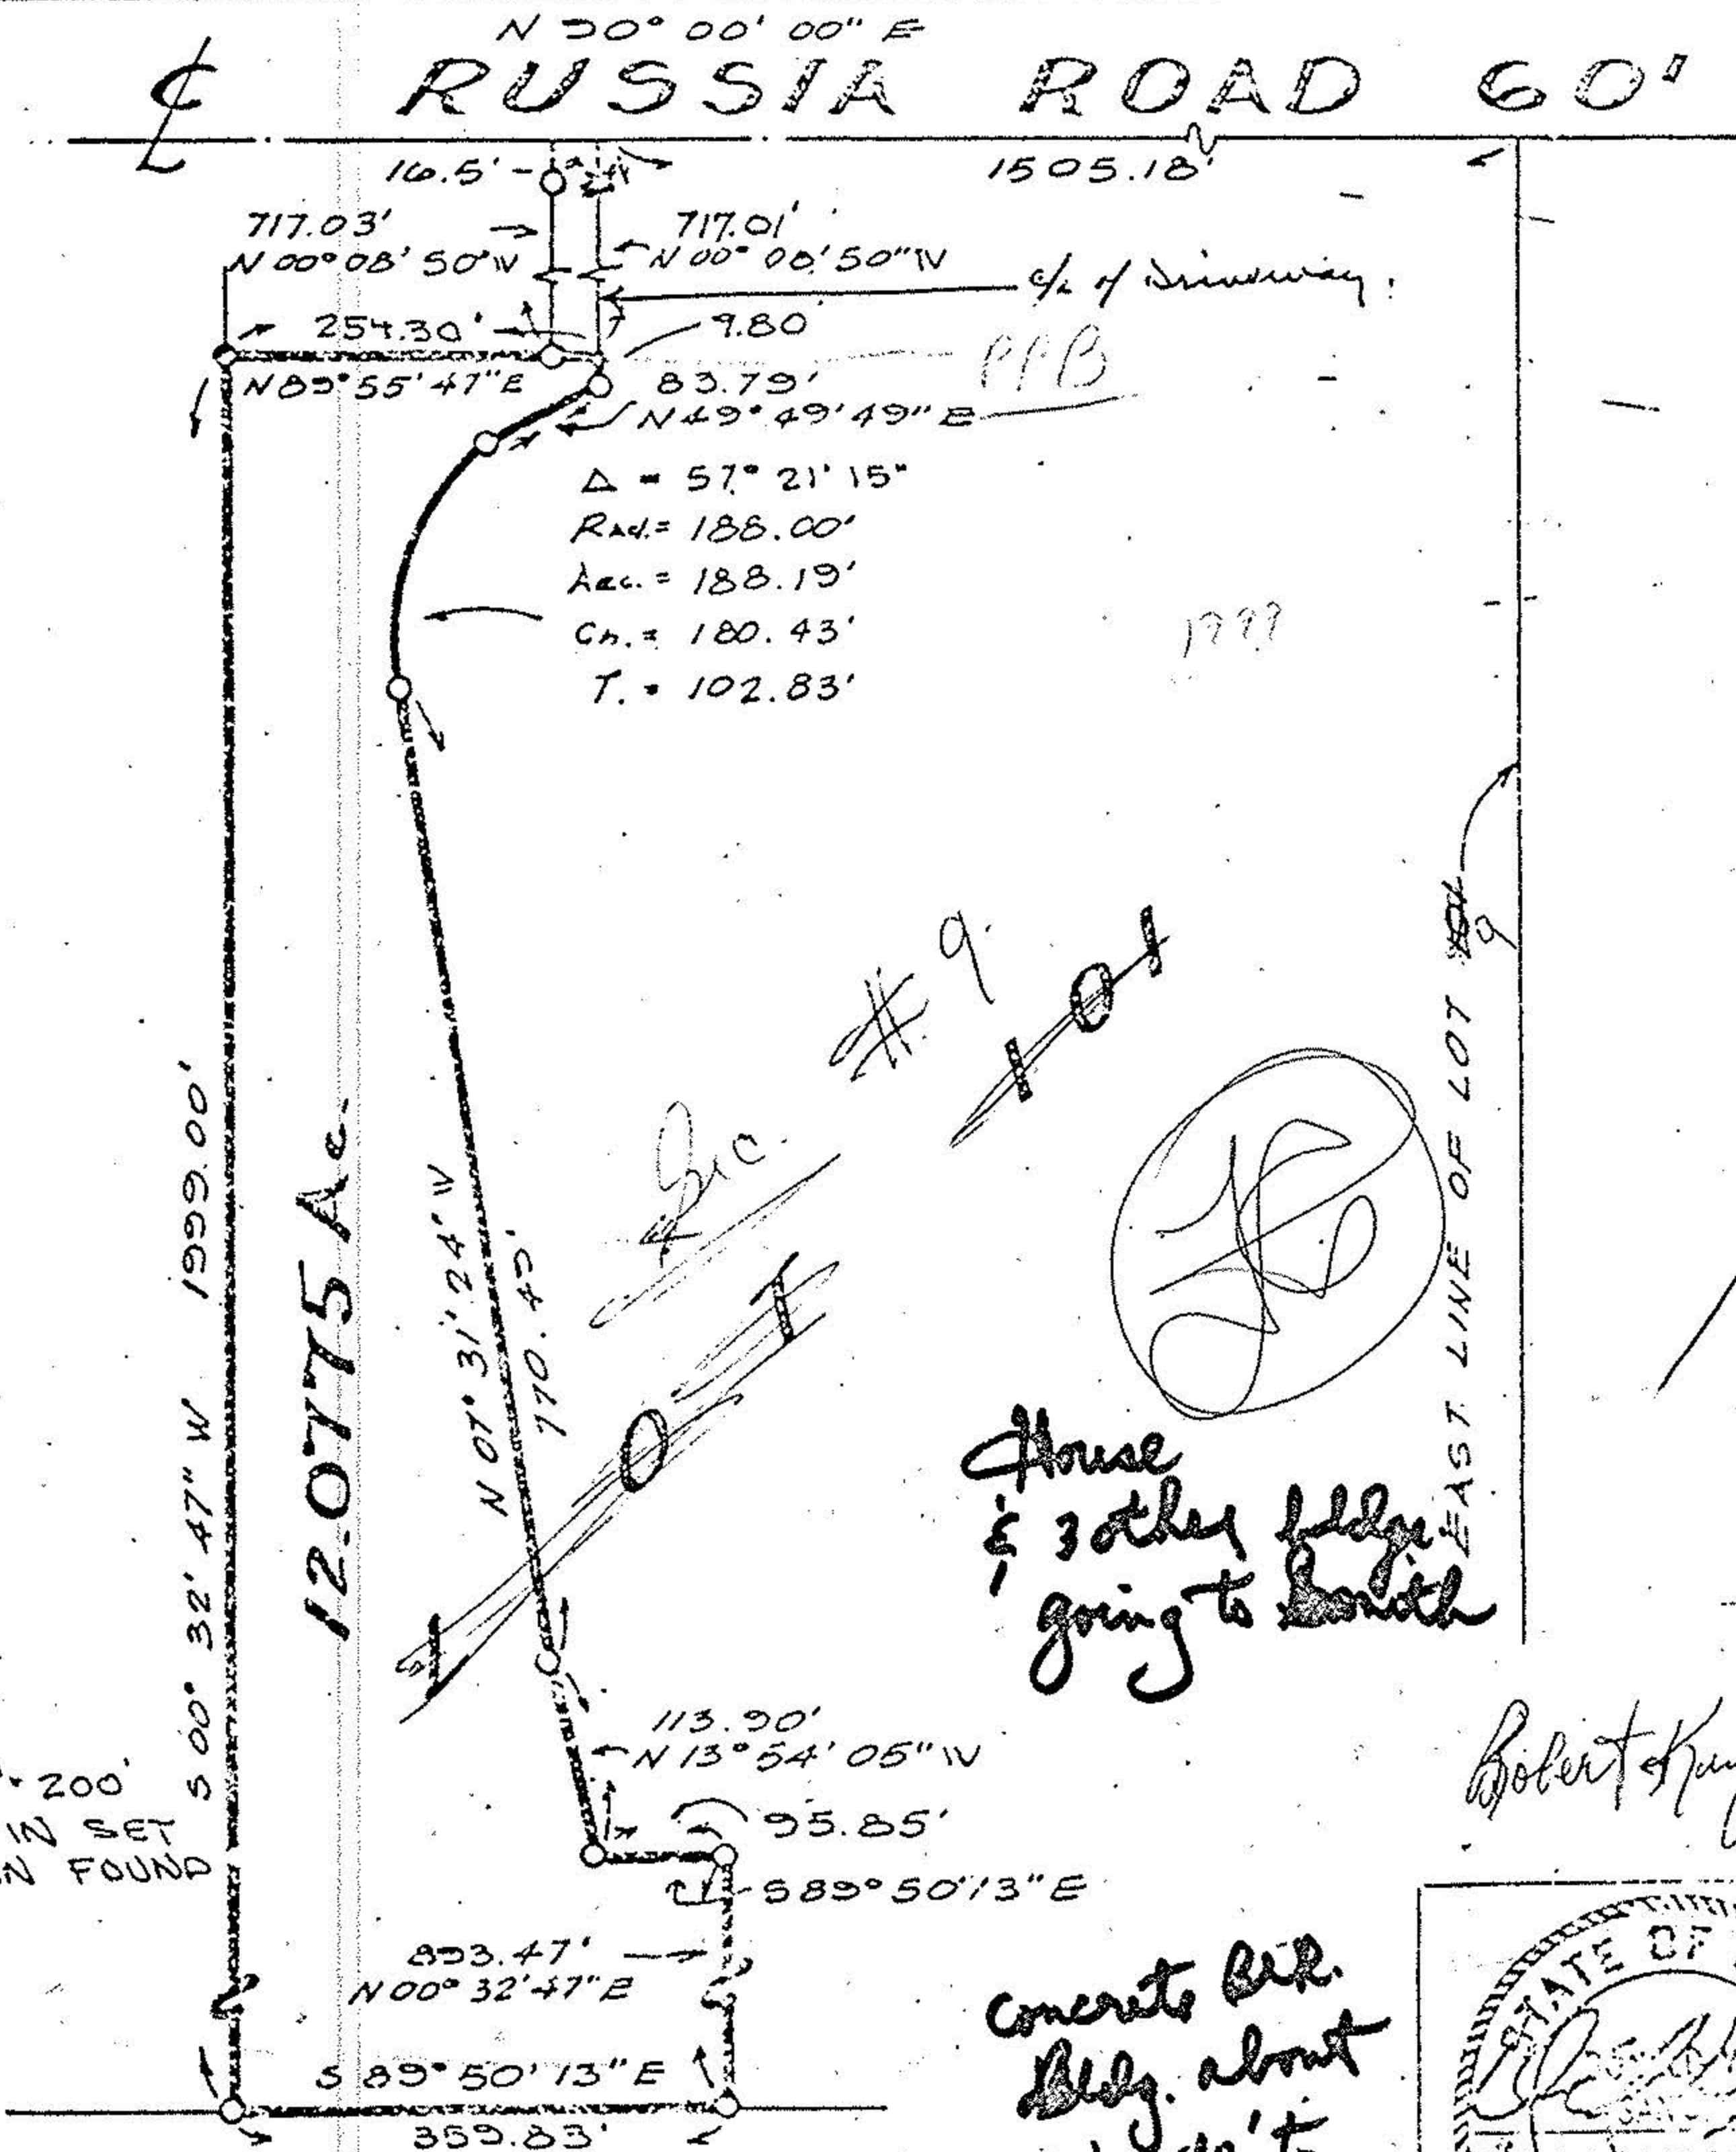

SCALE = 1" = 200'  
○ IRON PIN SET  
● IRON PIN FOUND

**SAMUEL ASSOCIATES**  
ENGINEERS SURVEYORS

**Concrete Bldg. about 30' x 60' to Bacon**

