




#11012

10-00-008-D

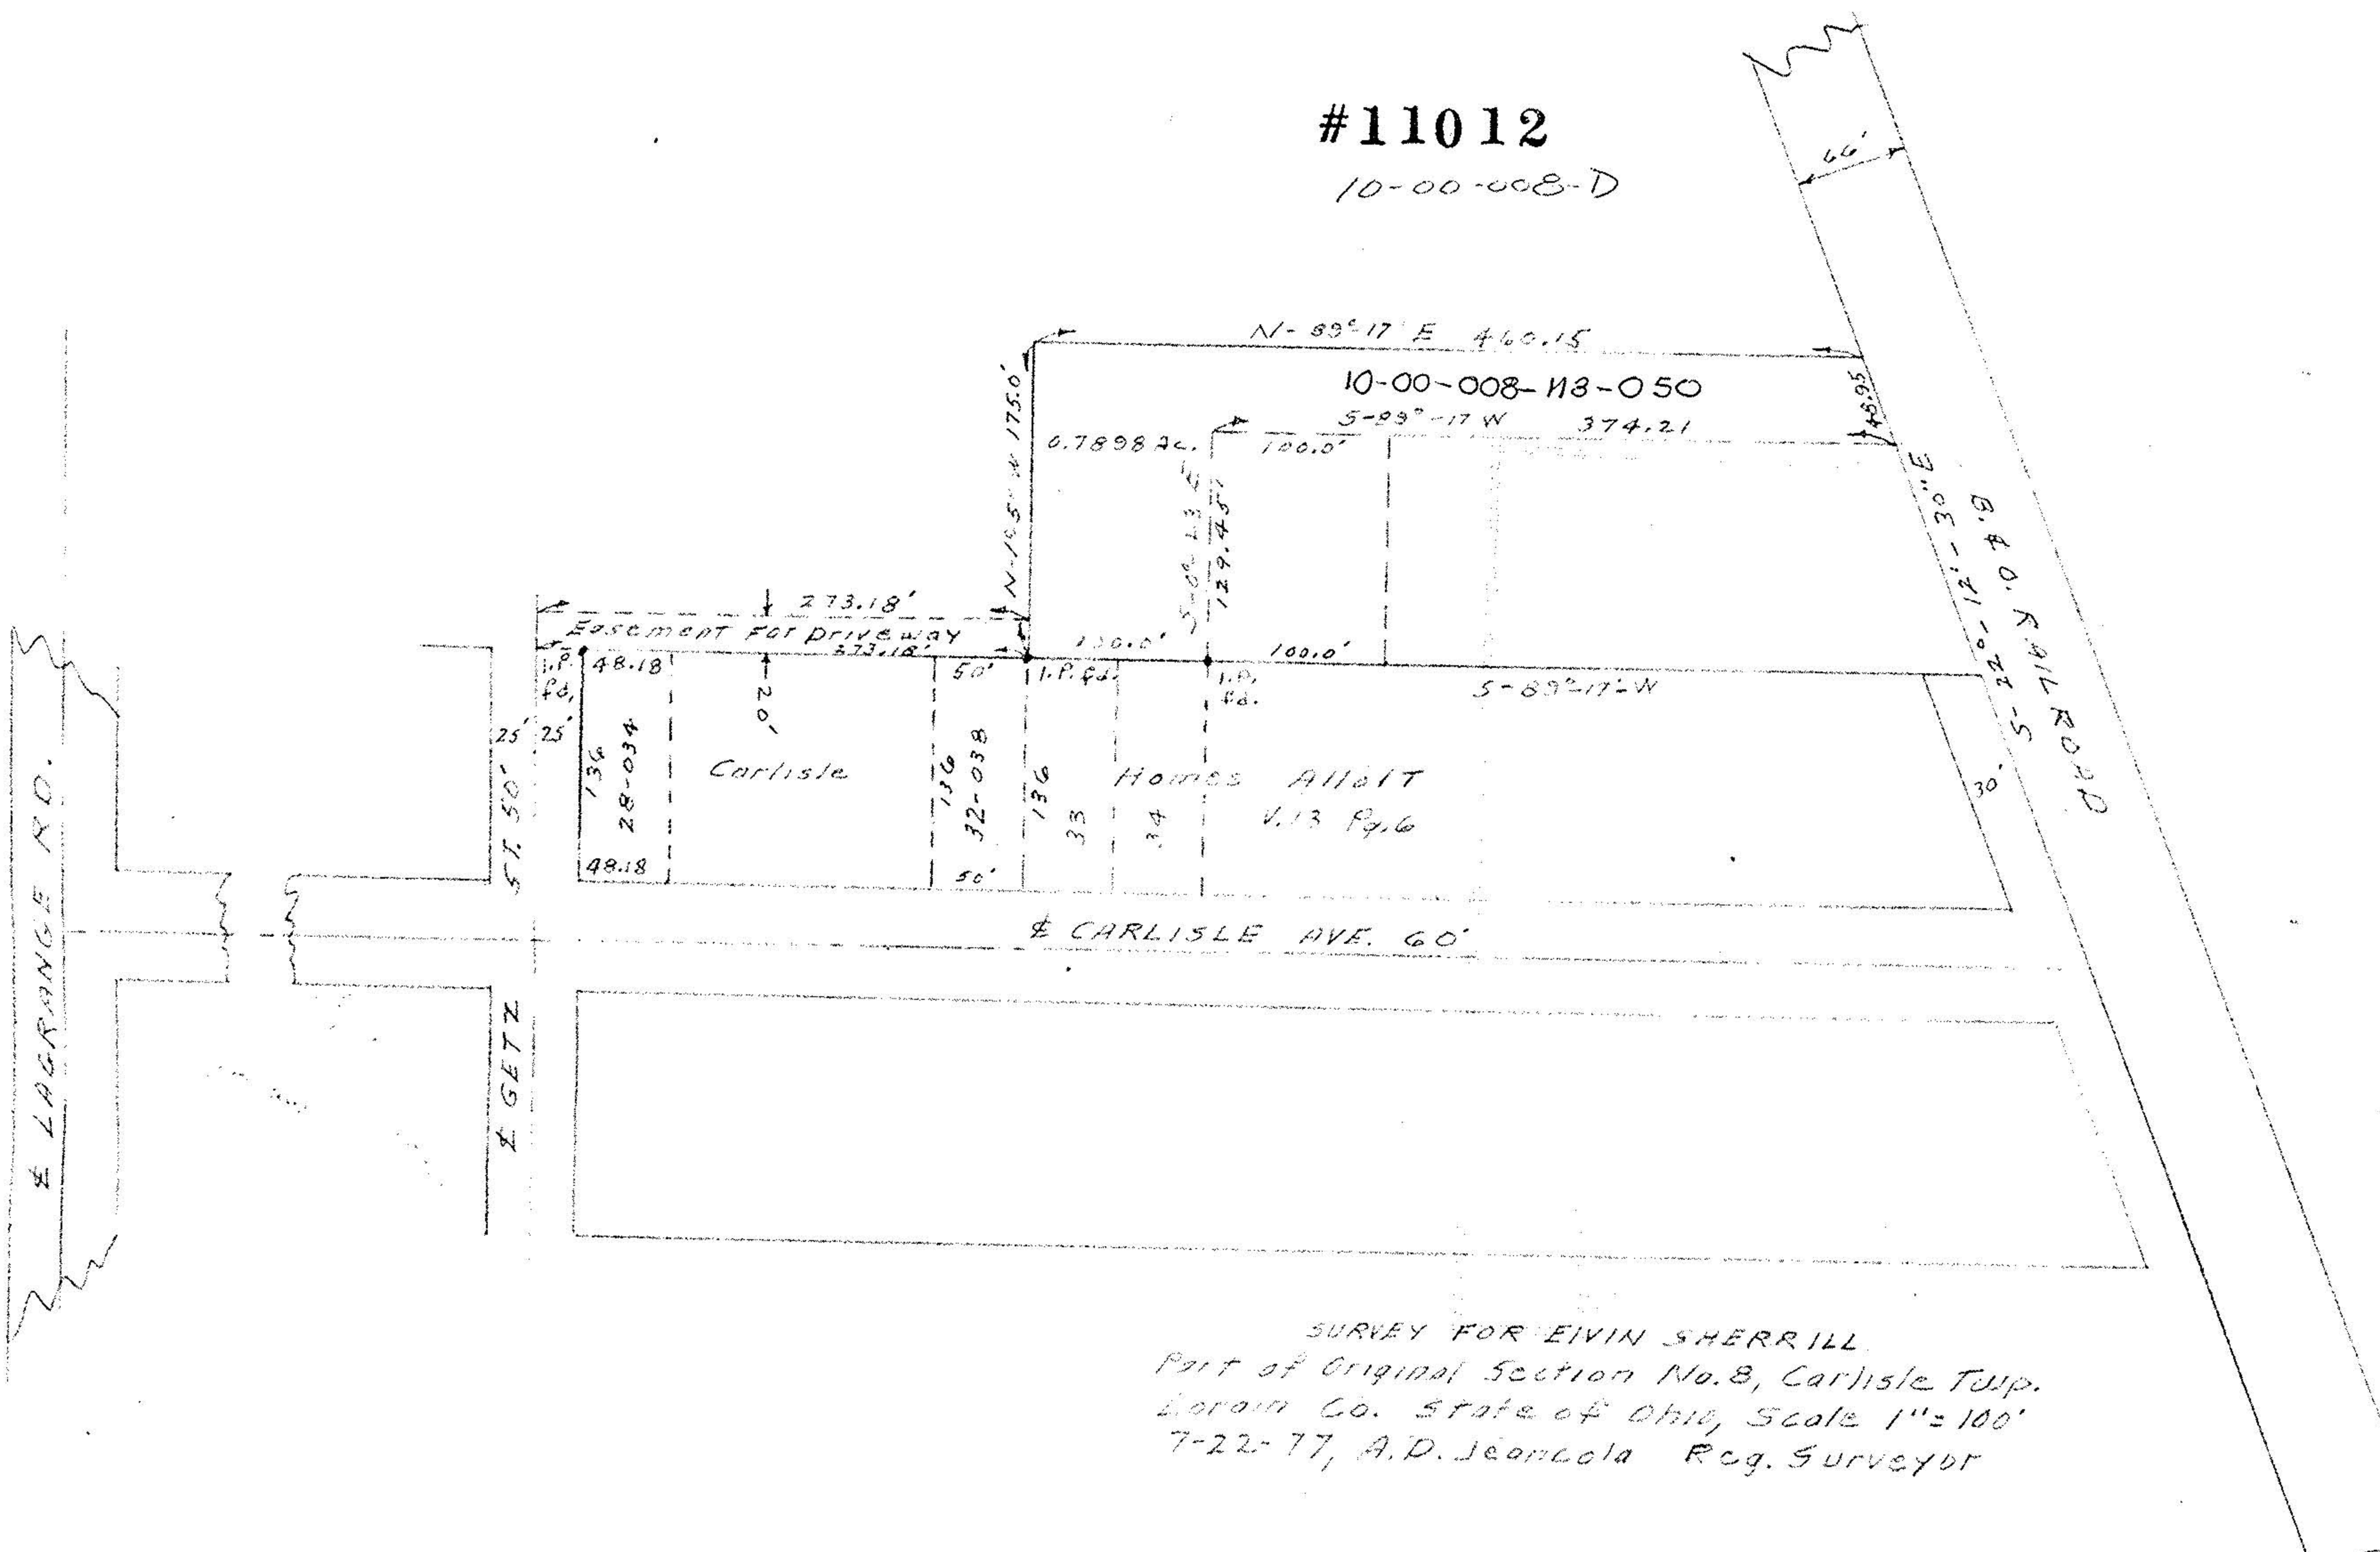

SURVEY FOR EIVIN SHERRILL
 Part of Original Section No. 8, Carlisle Twp.
 Lorain Co. State of Ohio, Scale 1"=100'
 7-22-77, A.D. Leopolda Reg. Surveyor