
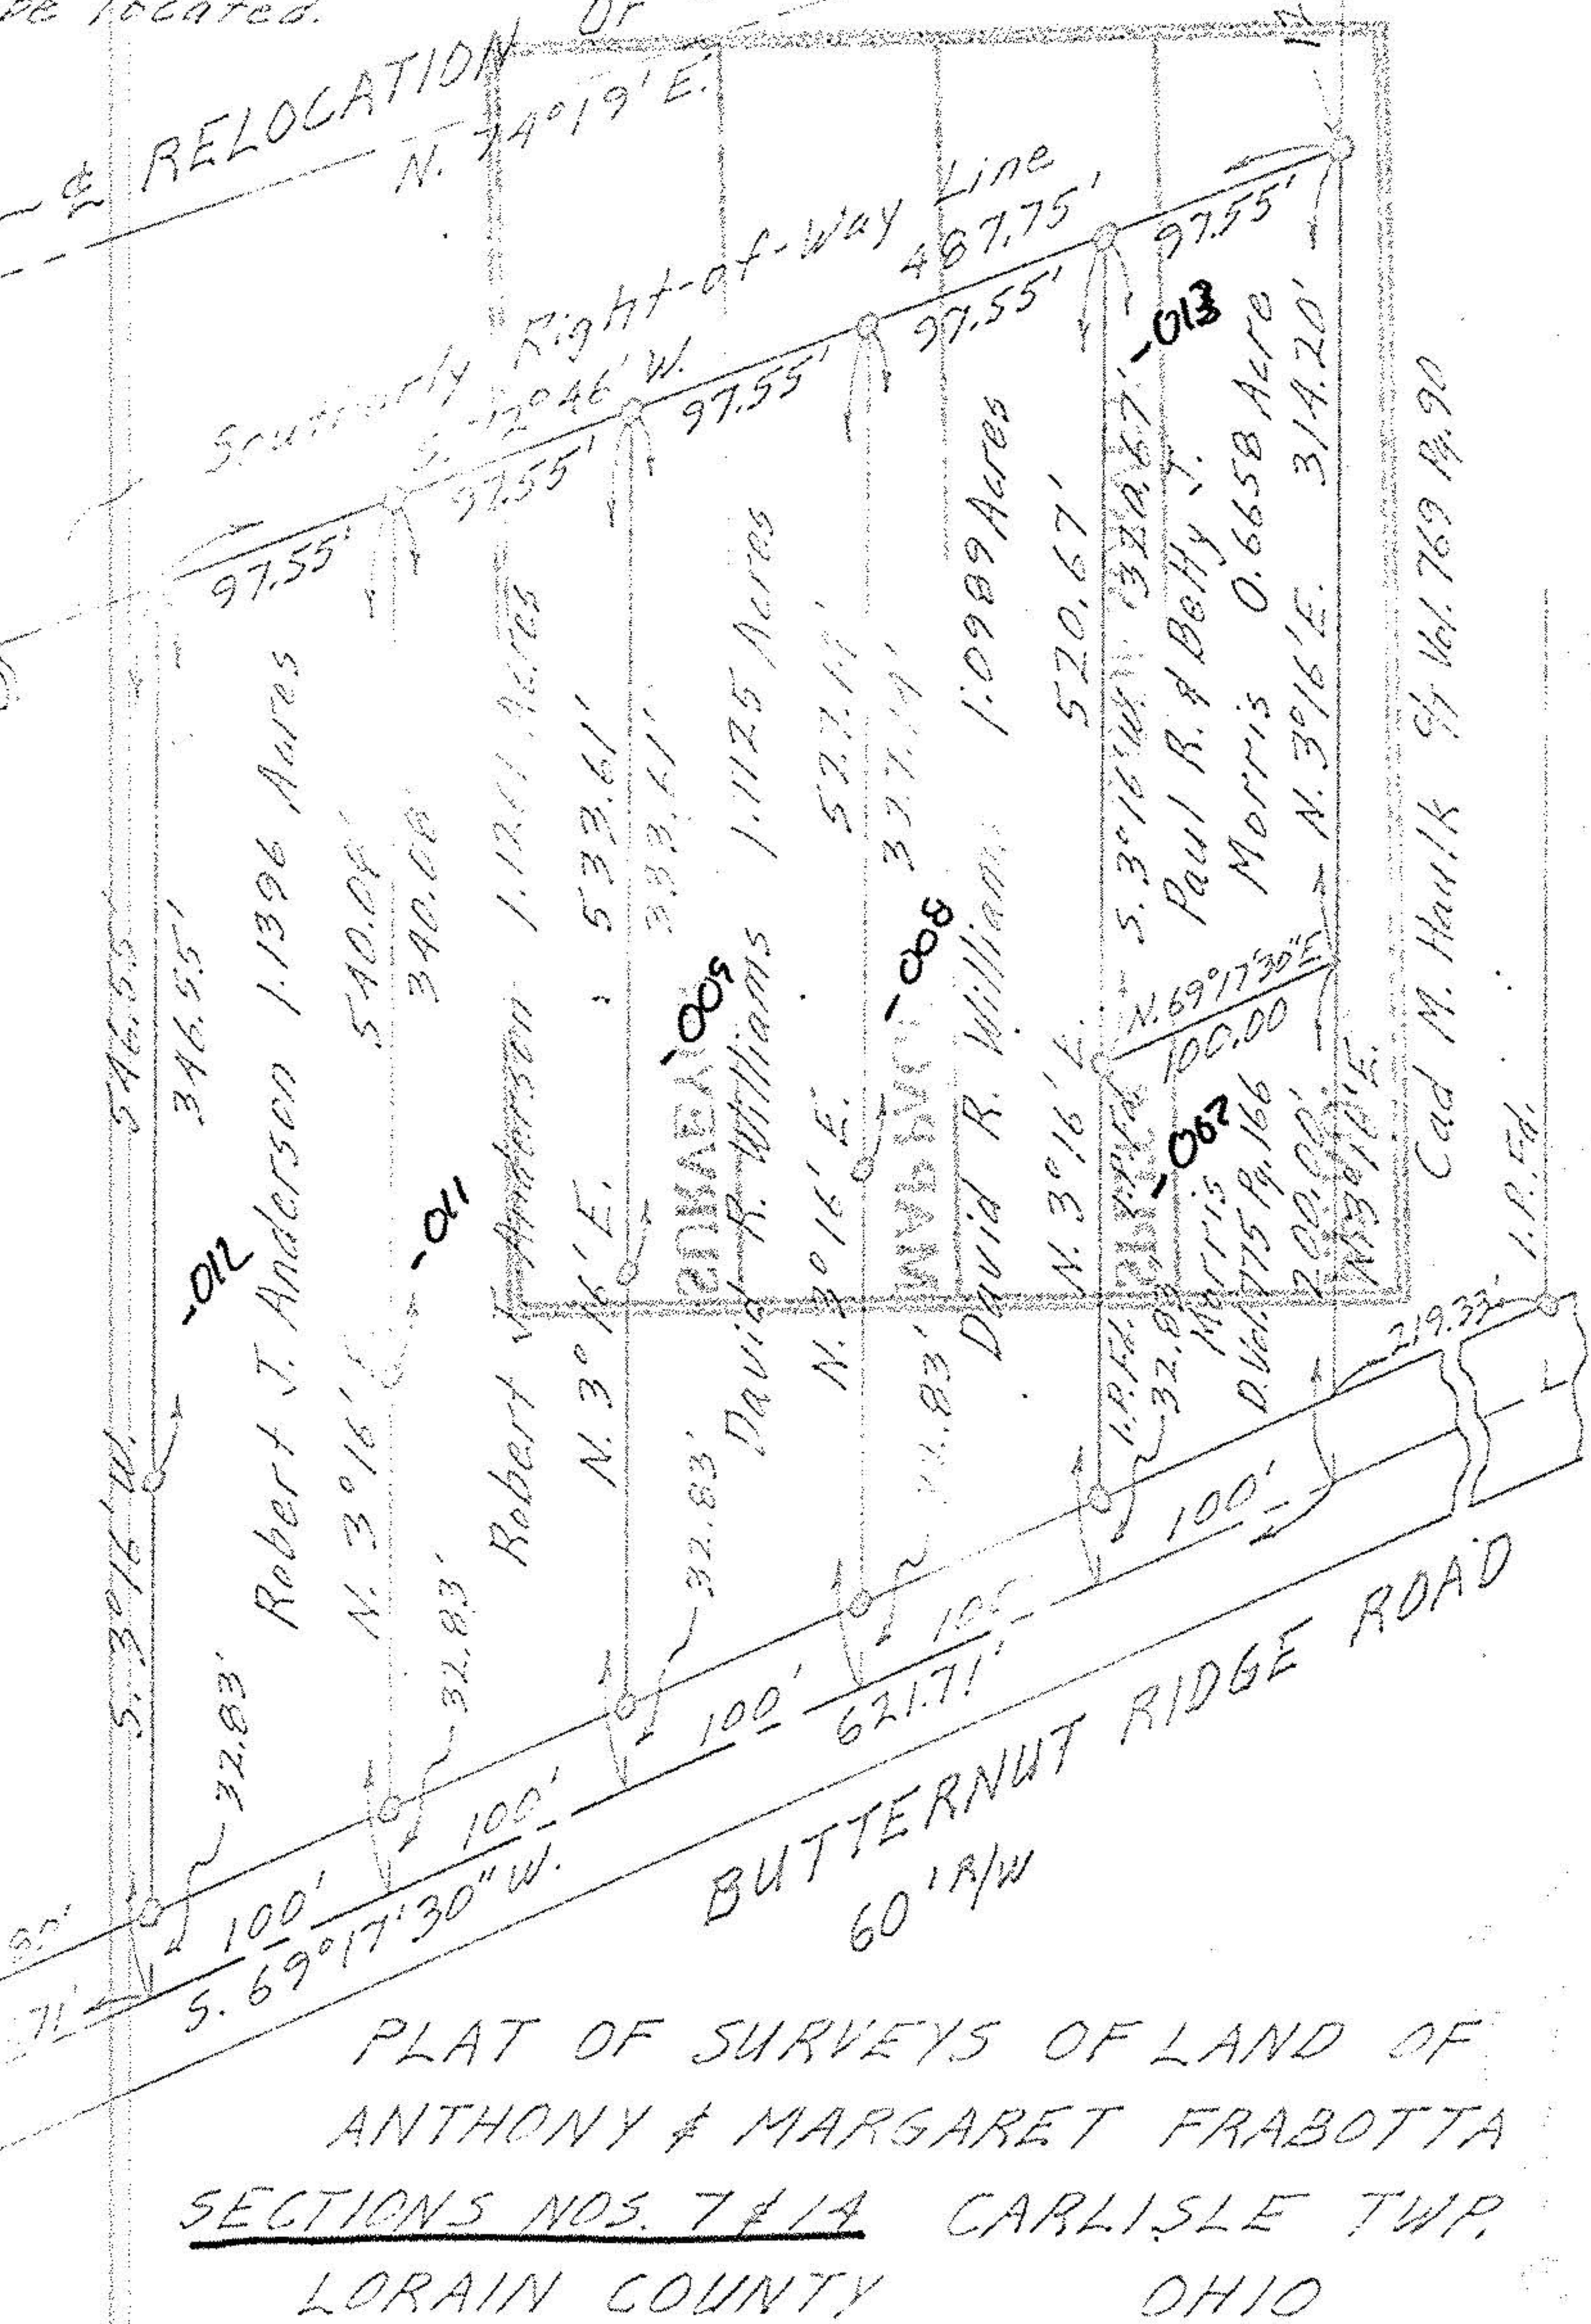
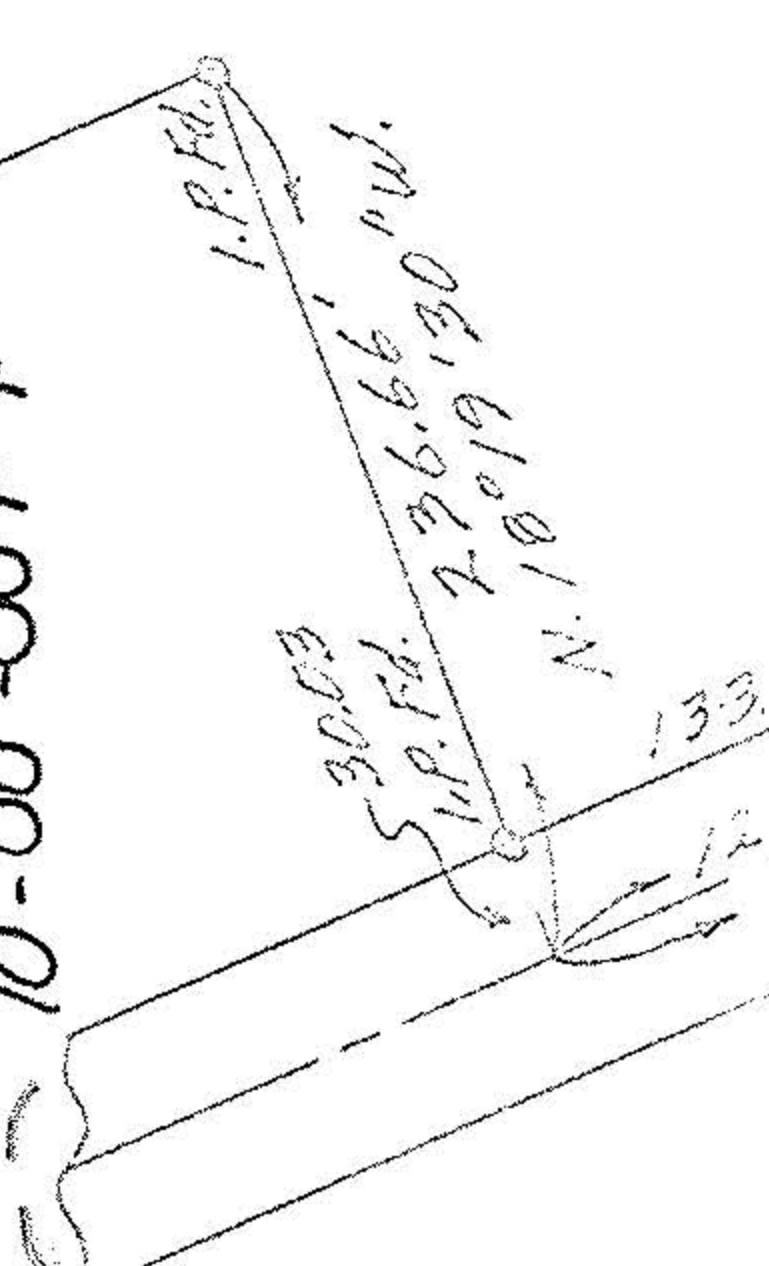
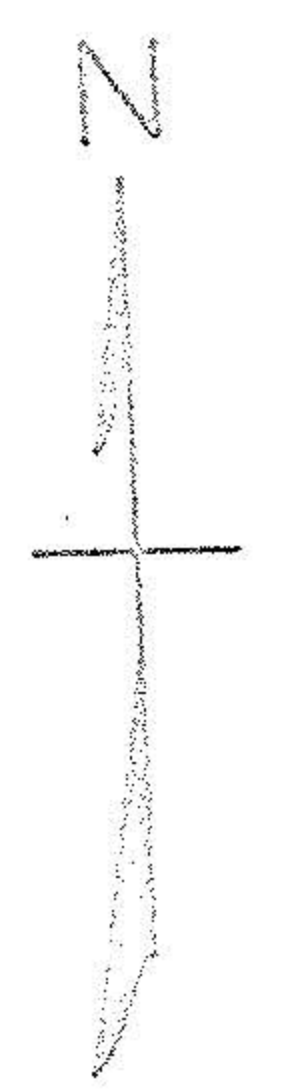


10-00-007-F

10-00-007-105-

address contained herein
dividing line between
sections 7 & 14 cannot
be located.

RELOCATION OF STATE ROUTE 10

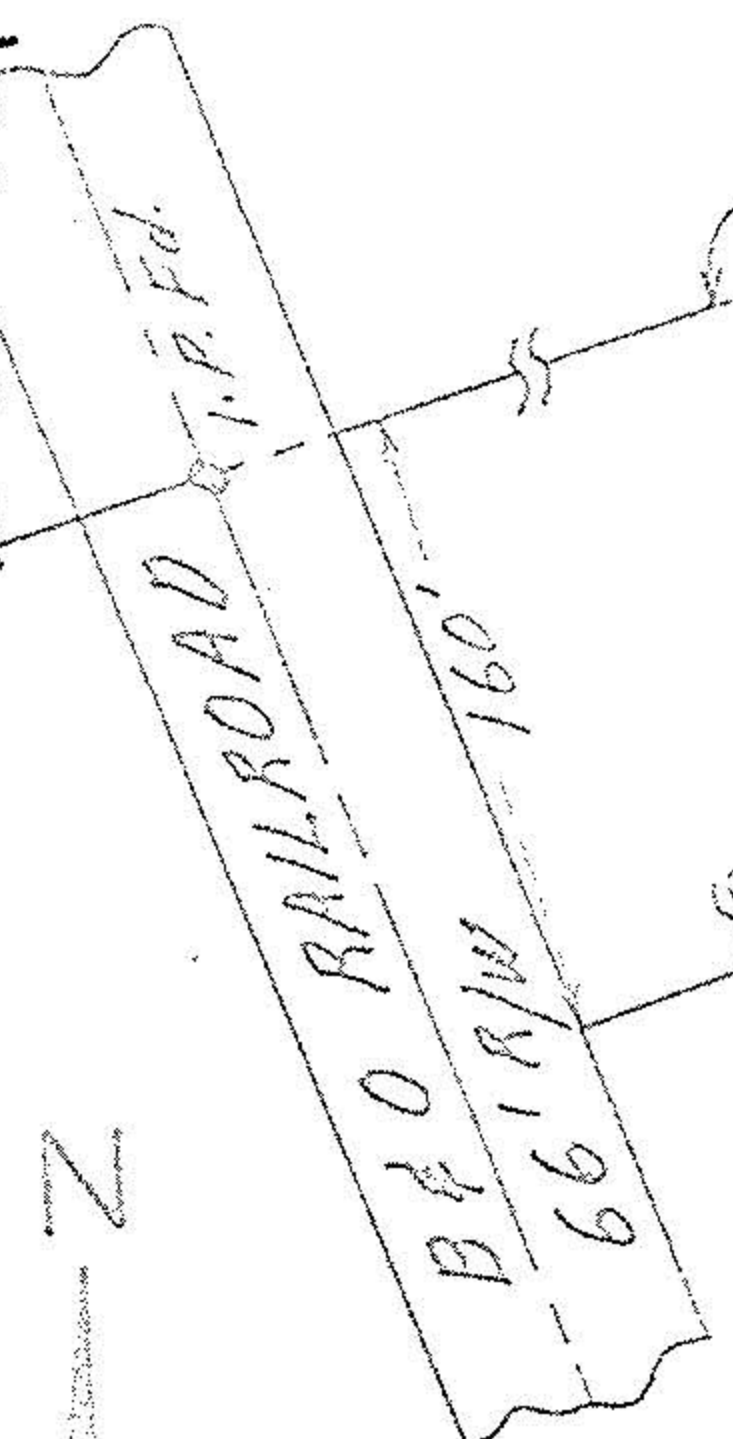

PLAT OF SURVEYS OF LAND OF
ANTHONY & MARGARET FRABOTTA
SECTIONS NOS. 7 & 14 CARLISLE TWP.
LORAIN COUNTY OHIO

SCALE: 1" = 100' OCT. 3-6, 1967

Gary F. Penfound Reg. Surveyor

Cad M. Hauk 94 Vol. 769 P. 90

I.P.Fd.