


CARDINAL SURVEYS  
 PLAT OF SURVEY  
 PREPARED FOR ROBERT ROBINSON

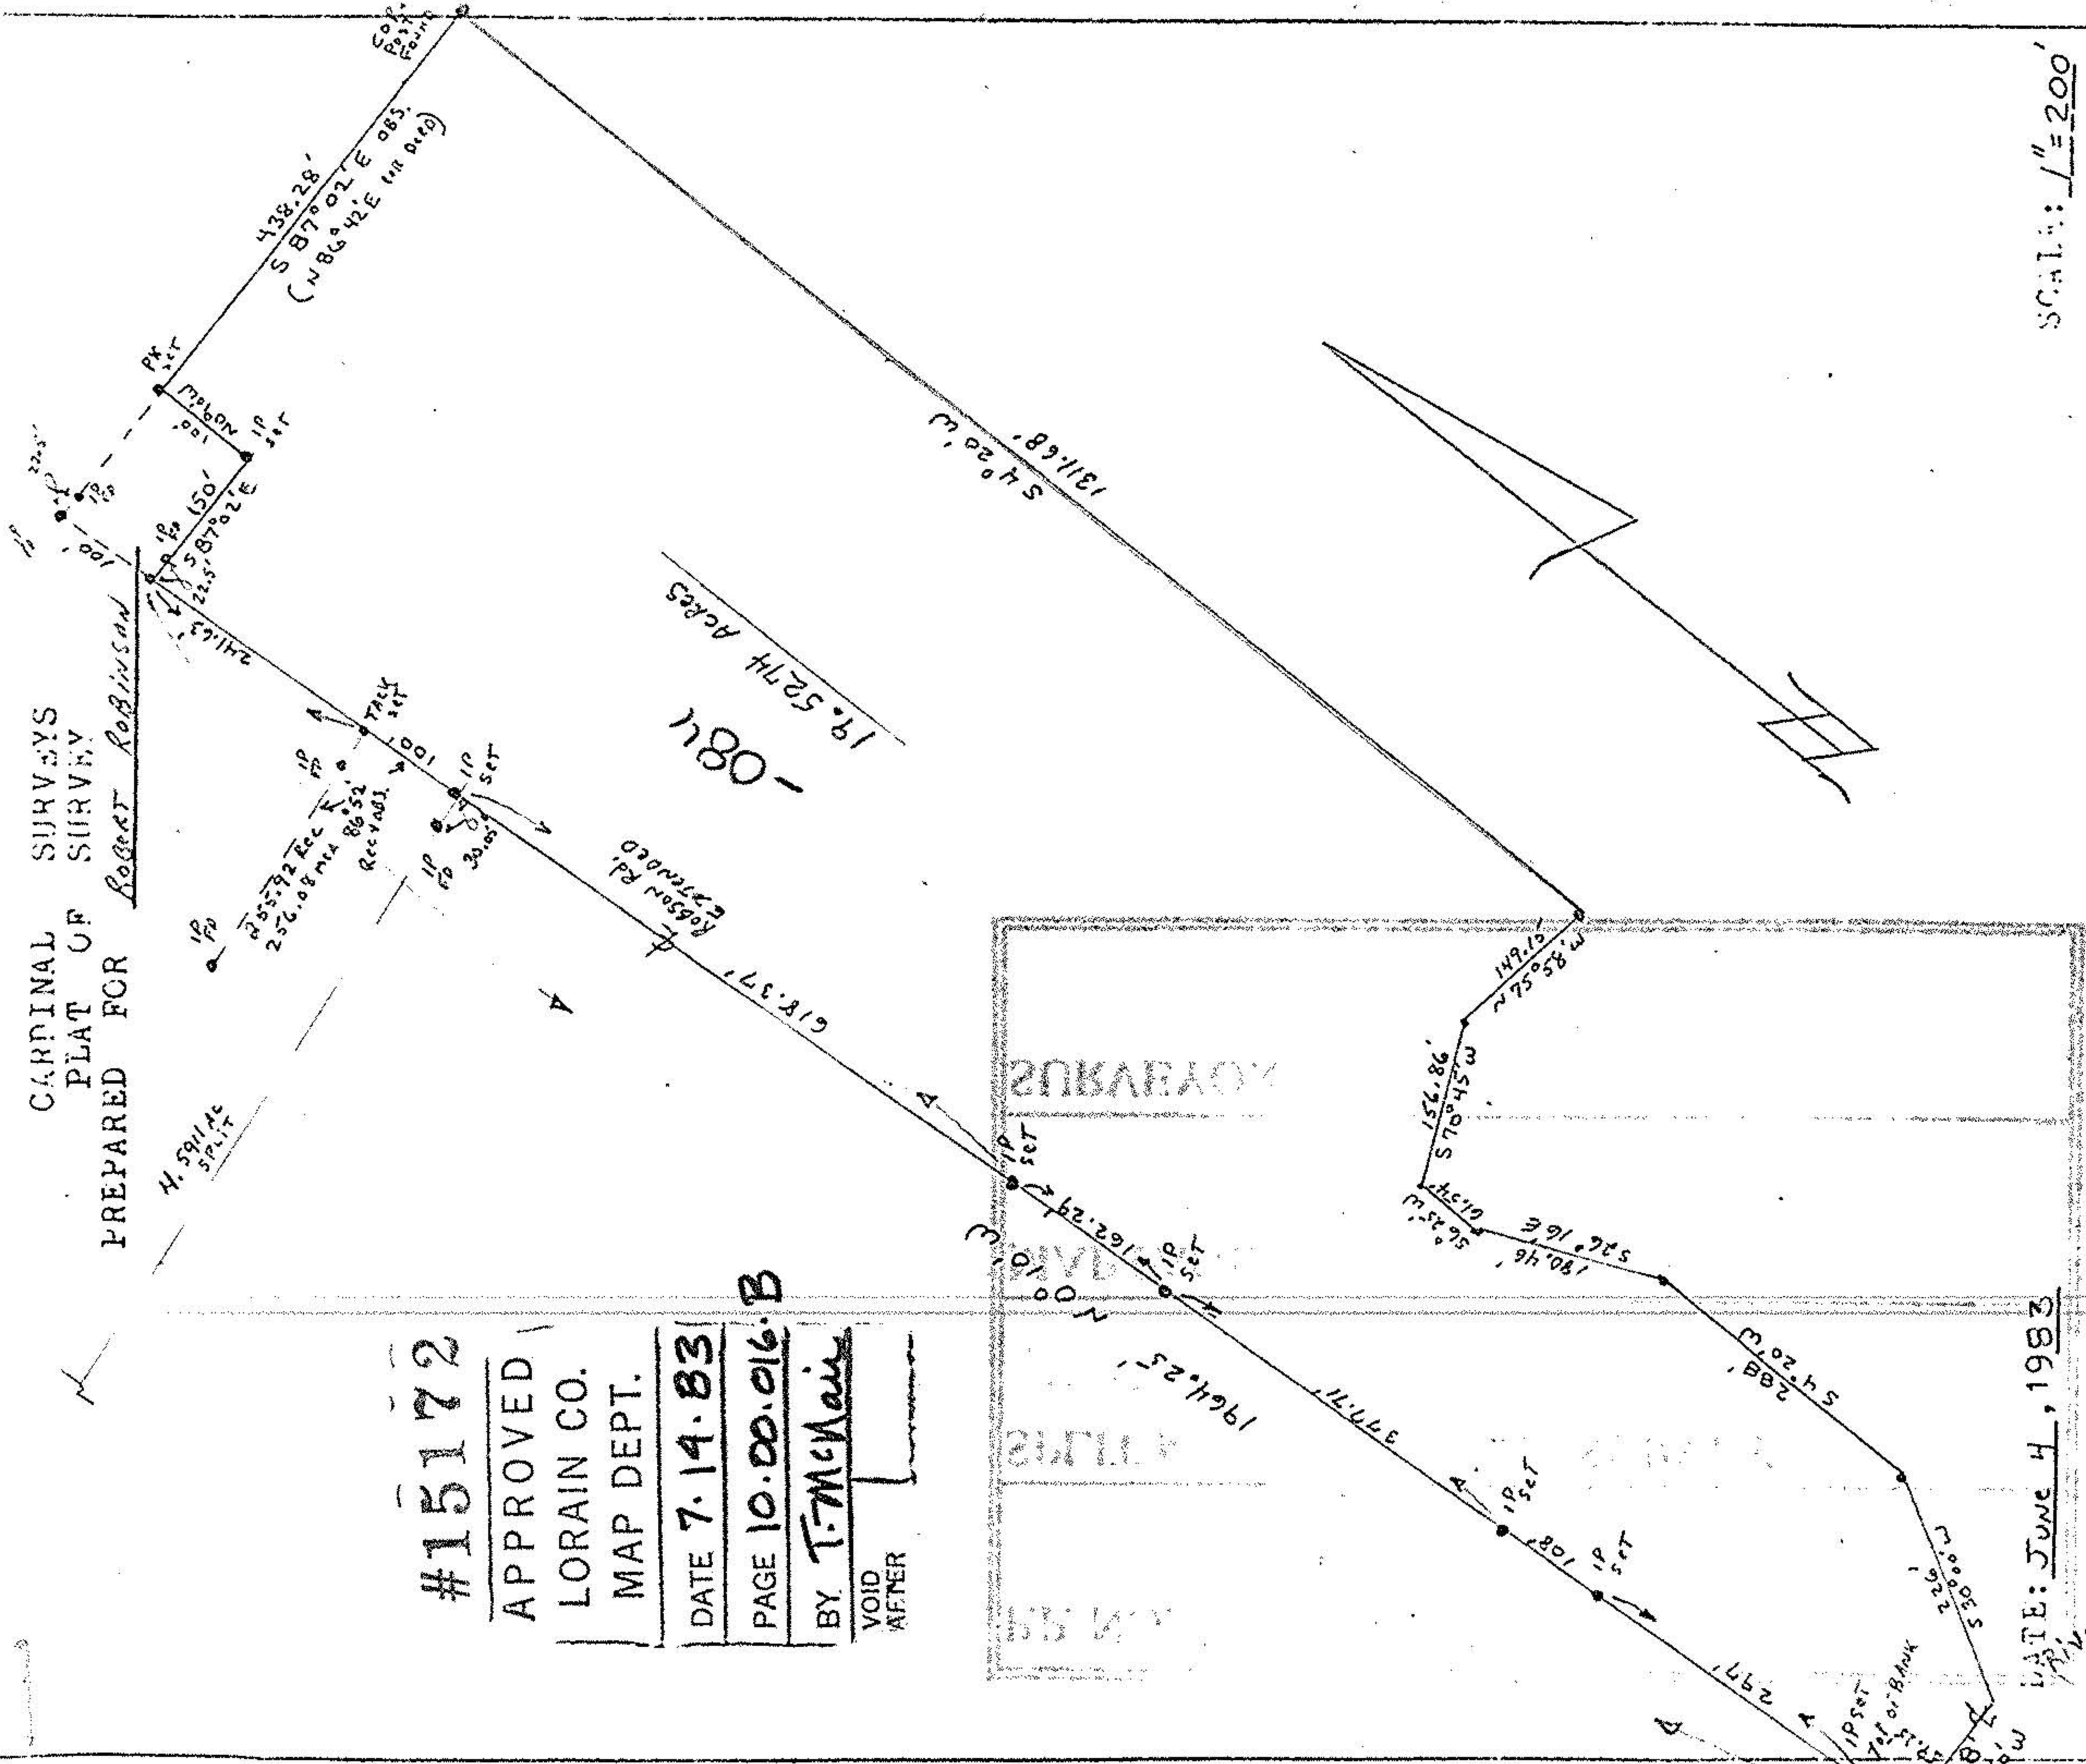

SCALE: 1" = 200'

#15172


APPROVED  
 LORAIN CO.  
 MAP DEPT.

DATE 7.14.83

PAGE 10.00.016.B

BY T. McMain

VOID  
 AFTER

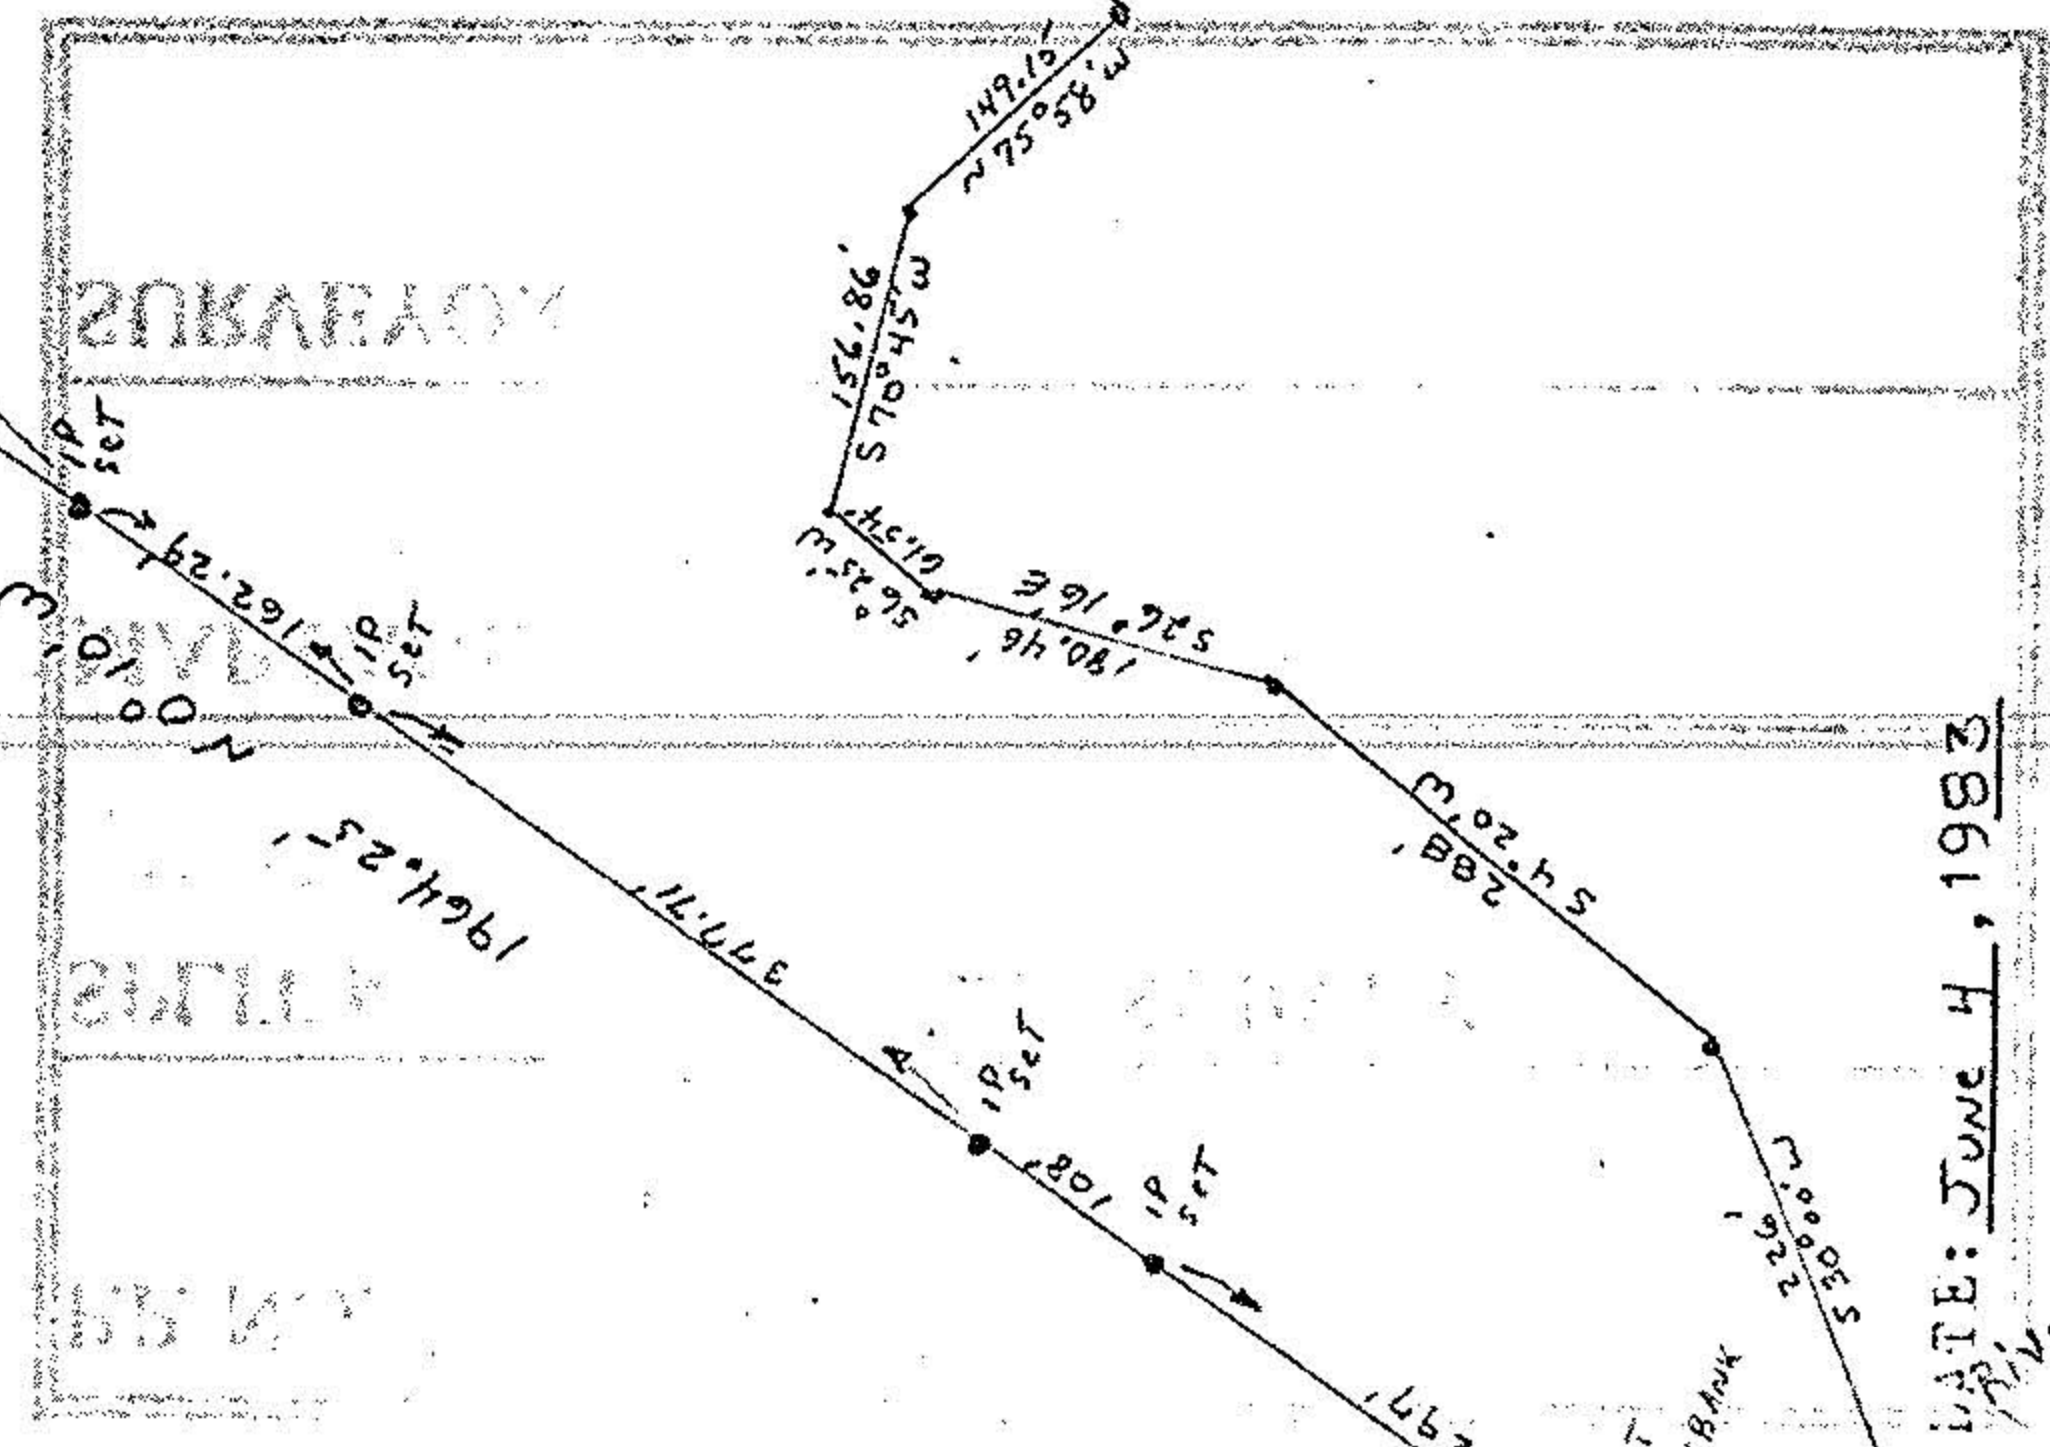

DATE: JUNE 4, 1983

10-00-016-000

#15172

10-00-016-B

SPLIT # 15172