



KLEINOEDER-SCHMIDT

and ASSOCIATES

ENGINEERS — SURVEYORS — CONSULTANTS IN LAND PLANNING

ELYRIA · NORWALK · MEDINA

OHIO

10-E SURVEY

Sublot(s) _____


Subd'n _____

Township CARLISLE Tract _____
 Orig. Lot(s) _____ Sec. 20
 County of LORAIN State of Ohio
 Corporation _____

MAY 20 1977

SEC. NO. 11

SEC. NO. 20

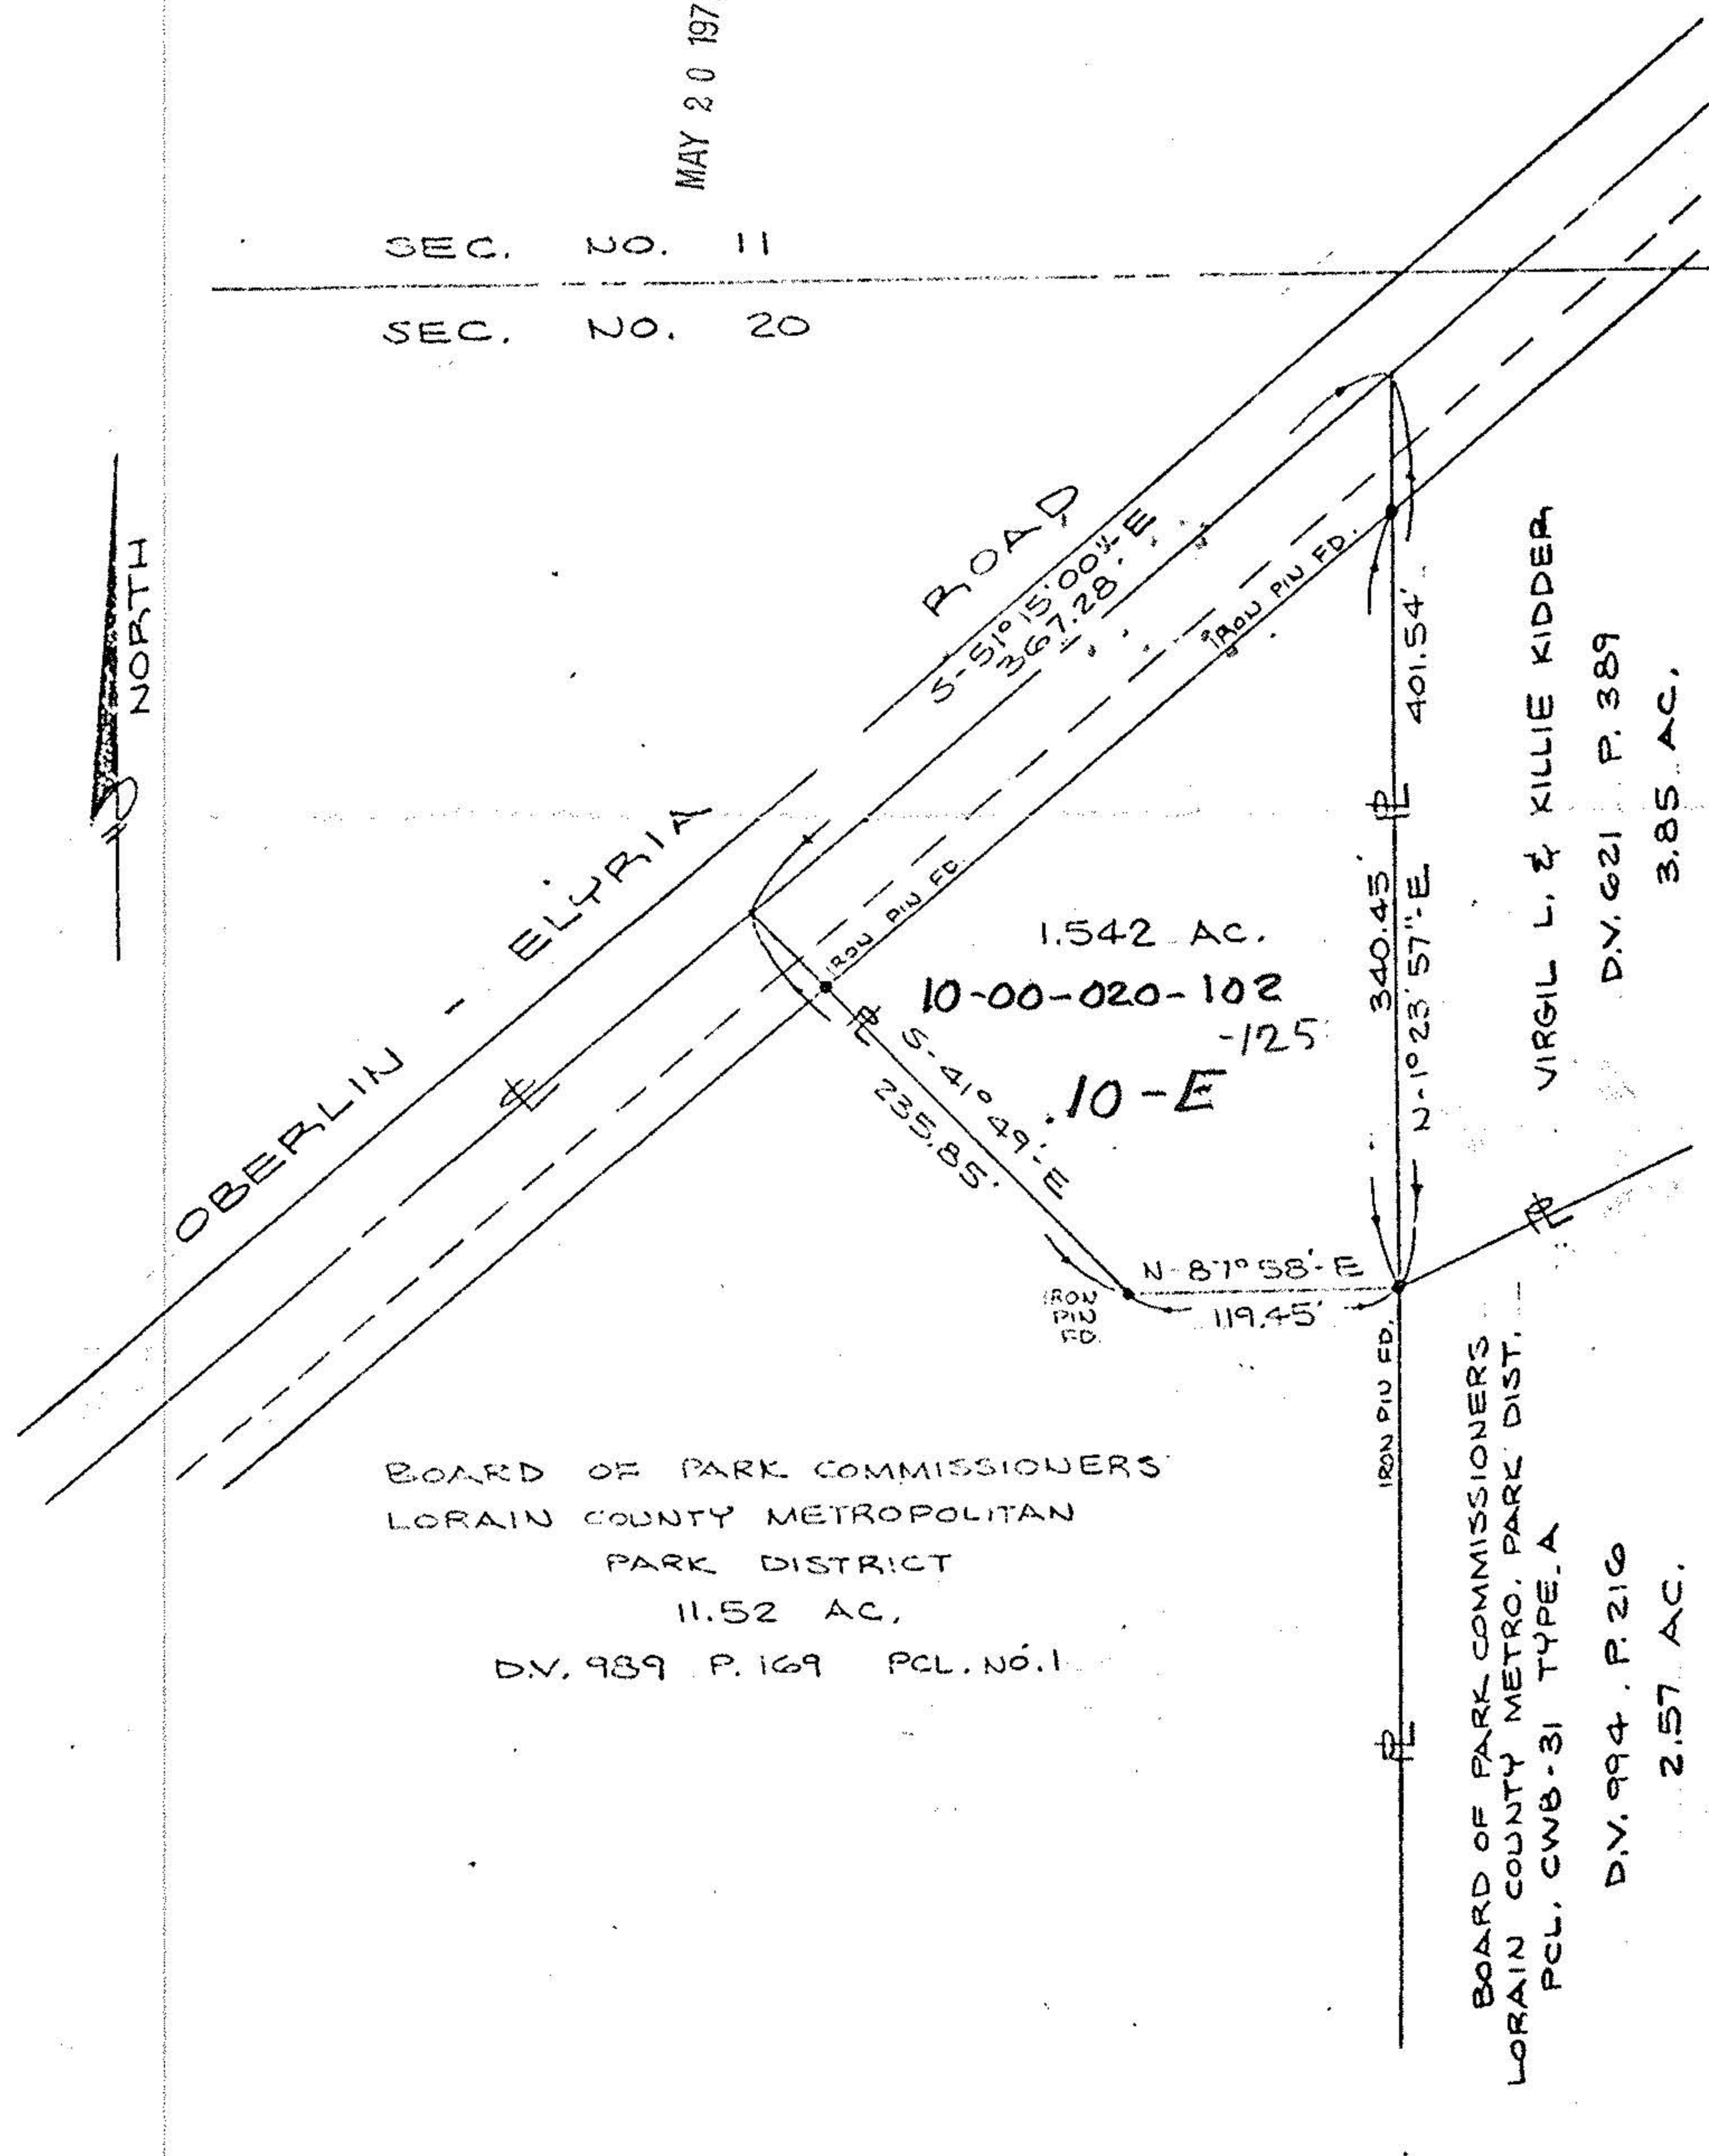

Prepared for: _____ 070-09-01

Scale: 1" = 100' | Date: MAR. 14, 1977 | Dr. by: *ES.* | Job No: 68-221

070-00-01