
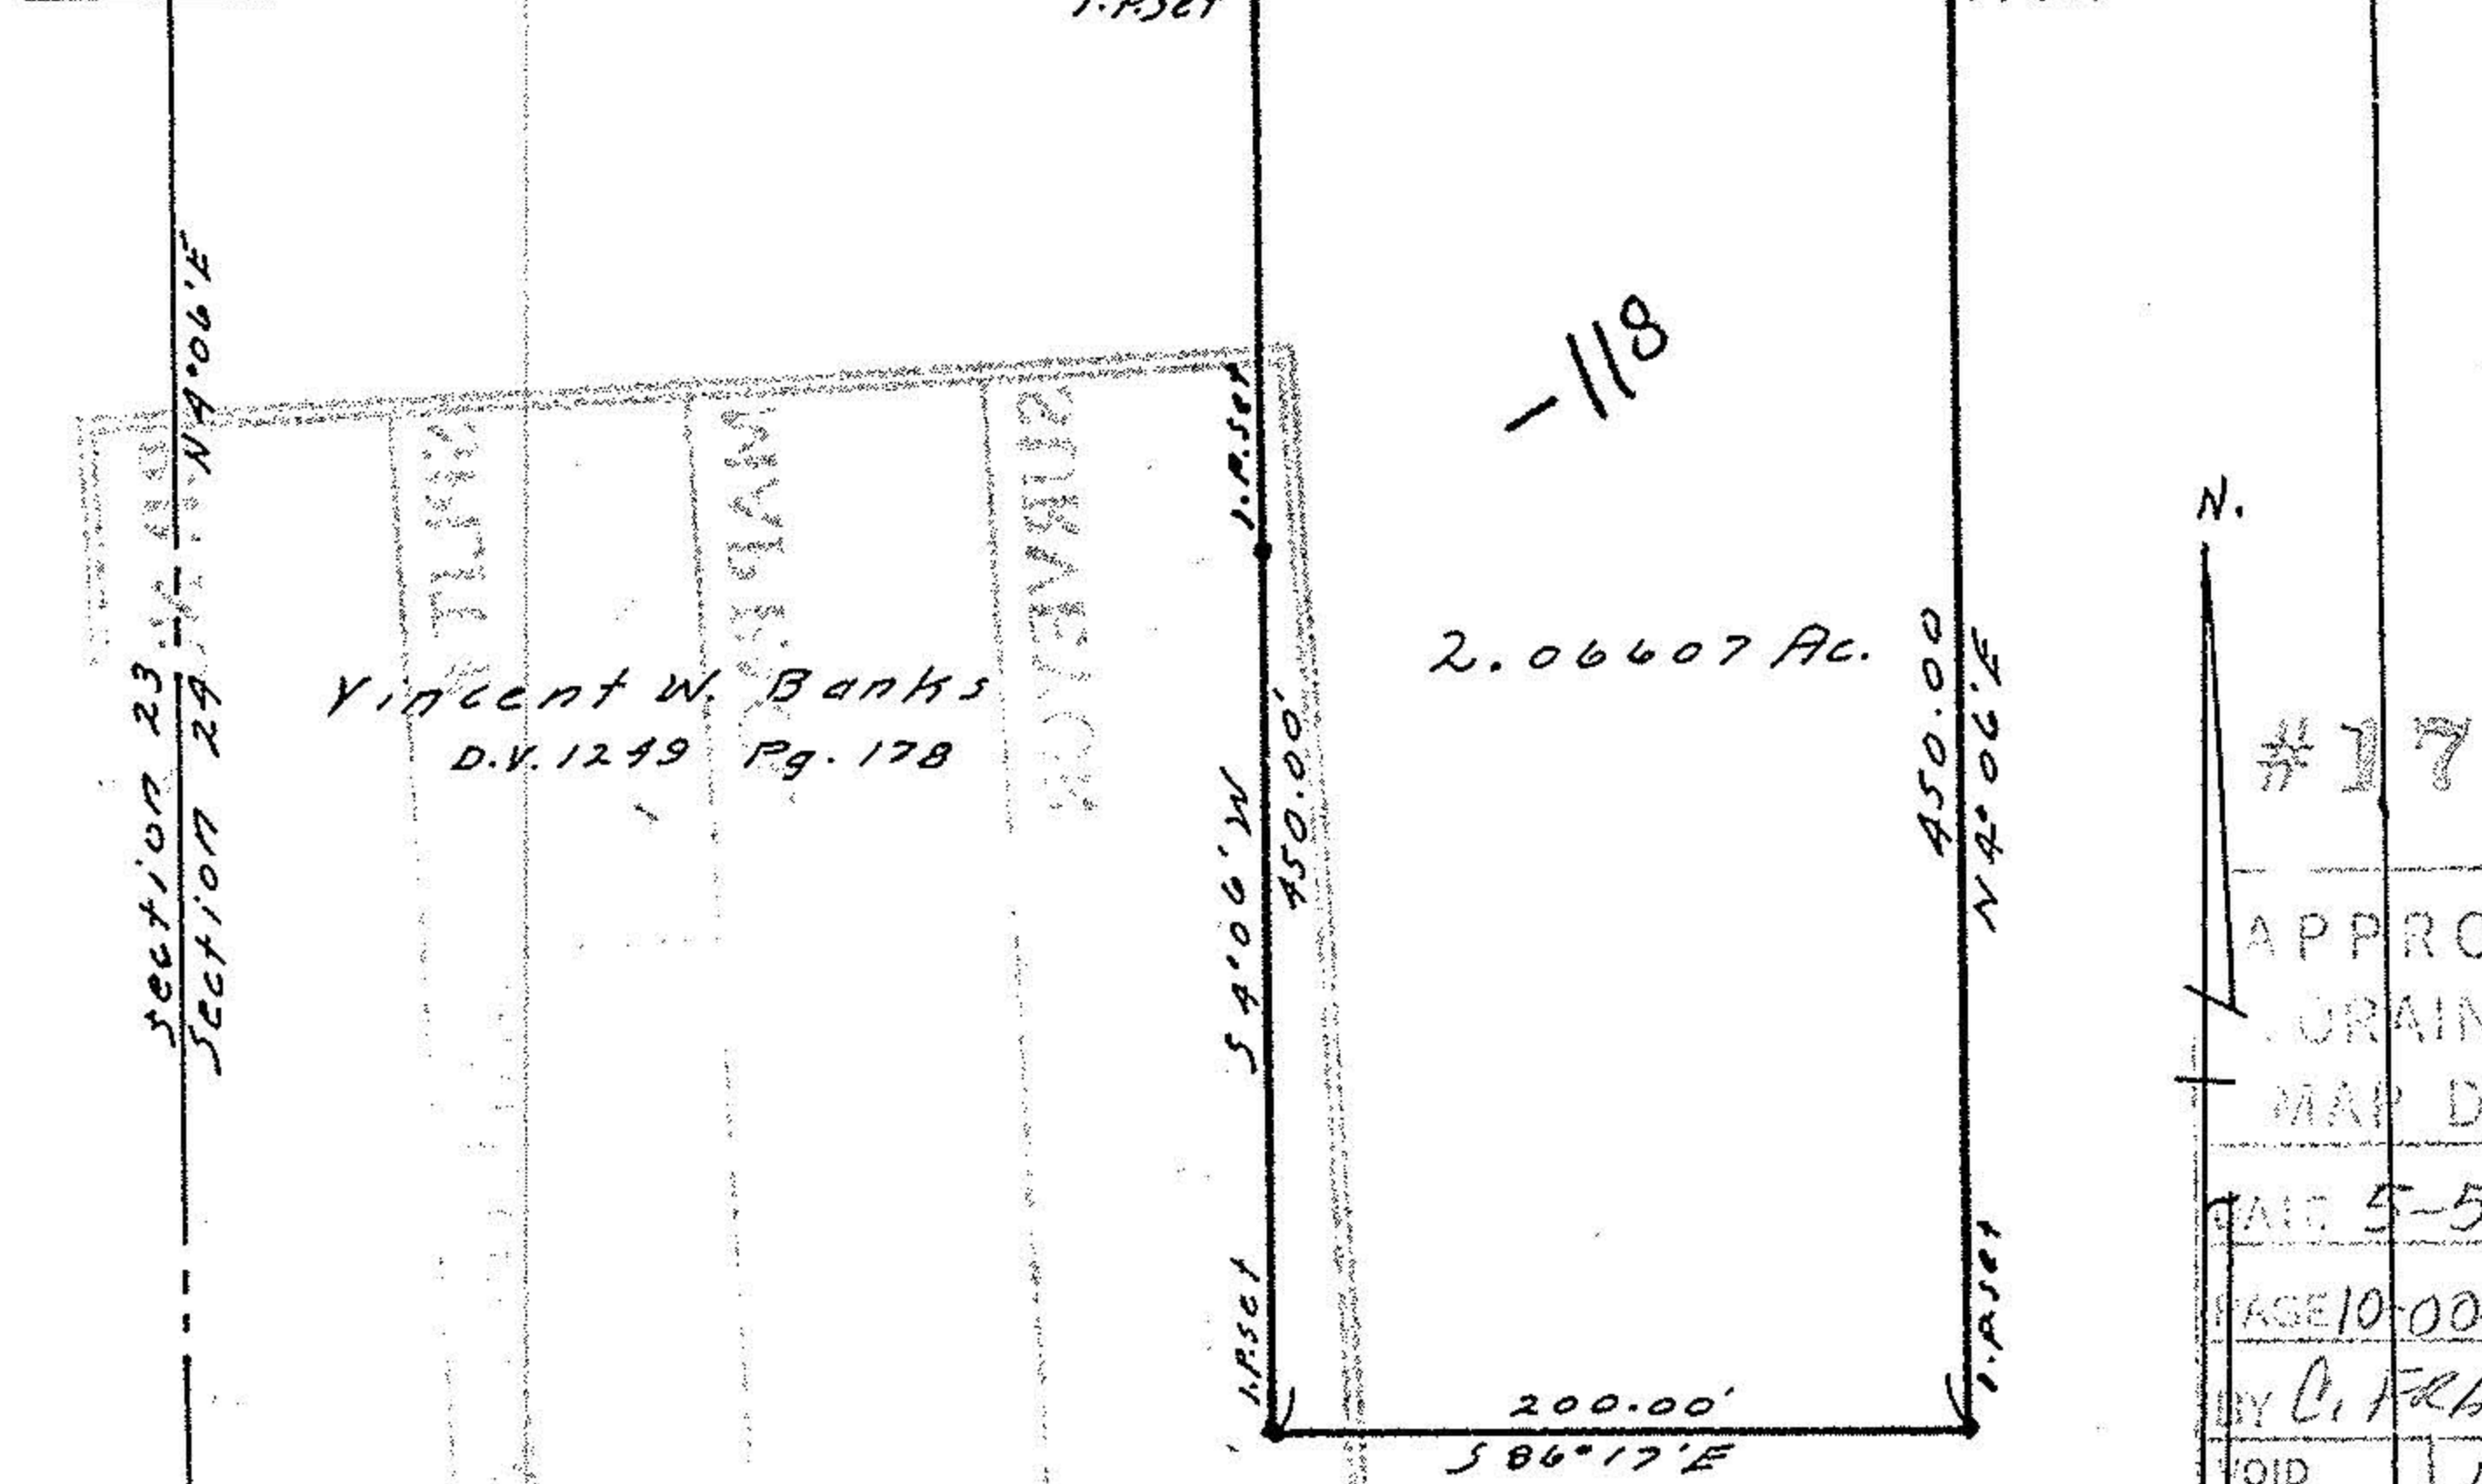


WILLIAM B. BARTON  
 Reg. Land Surveyor No. 4438  
 188 PARKWOOD AVENUE  
 AVON LAKE, OHIO 44012  
 TELEPHONE (216) 933-6662

BANKS RD.

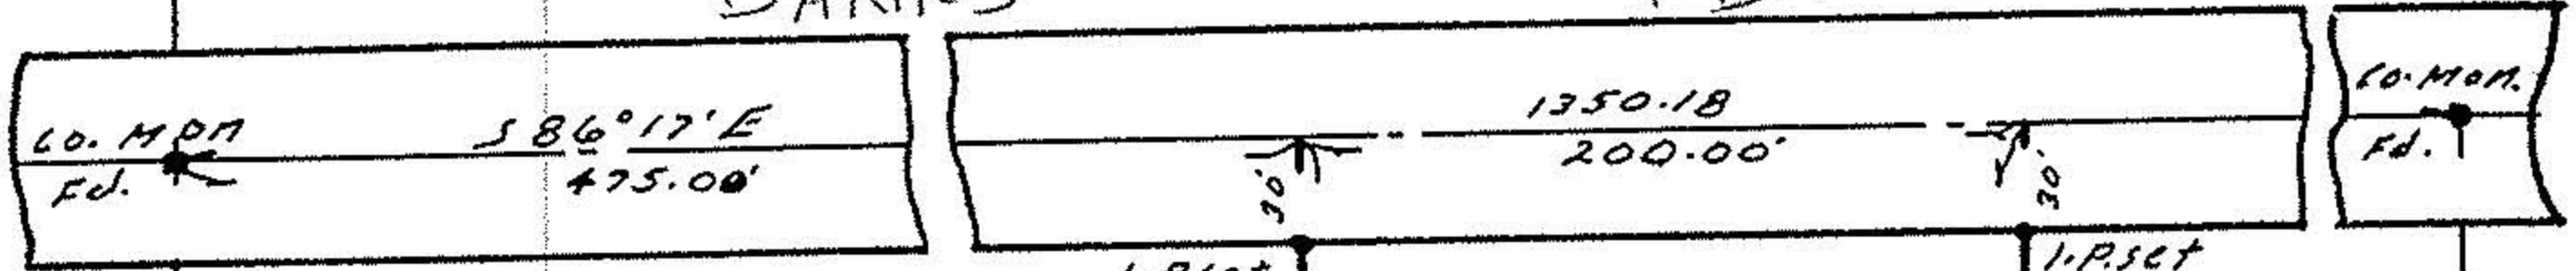

Vincent W. Banks  
 D.V. 1249 Pg. 178

N.

#17413

APPROVED	
GRAIN CO.	
MAP DEPT.	
DATE 5-5-87	
FILE 10-00-024 A	
BY C. FRANKS	
VOID AFTER	17413

SURVEY  
 of  
 Part of Section No. 24, Carlisle  
 Township, Lorain County, Ohio.  
 Scale 1"=100', May 29, 1986.



10-00-024-000  
 #17413  
 10-00-024-A