




LAUNDON · SIMON · CAHL & ASSOC. INC
 CONSULTING ENGINEERS & SURVEYORS
 504 MIDDLE AVENUE ELYRIA, OHIO 44035

SURVEY FOR
BANKS MANUFACTURING CO.

10-00-024-000
 #17786
 10-00-024-A

Orig Lot	City of	Date 3-29-84 Scale 1"=150'
Orig Sec 24	Village of	Dwn. by R.G.S. Chkd. by
Tract	County of LORAIN	Job No. 84-1269 F.B.
Township of CARLISLE	State of OHIO	Printed

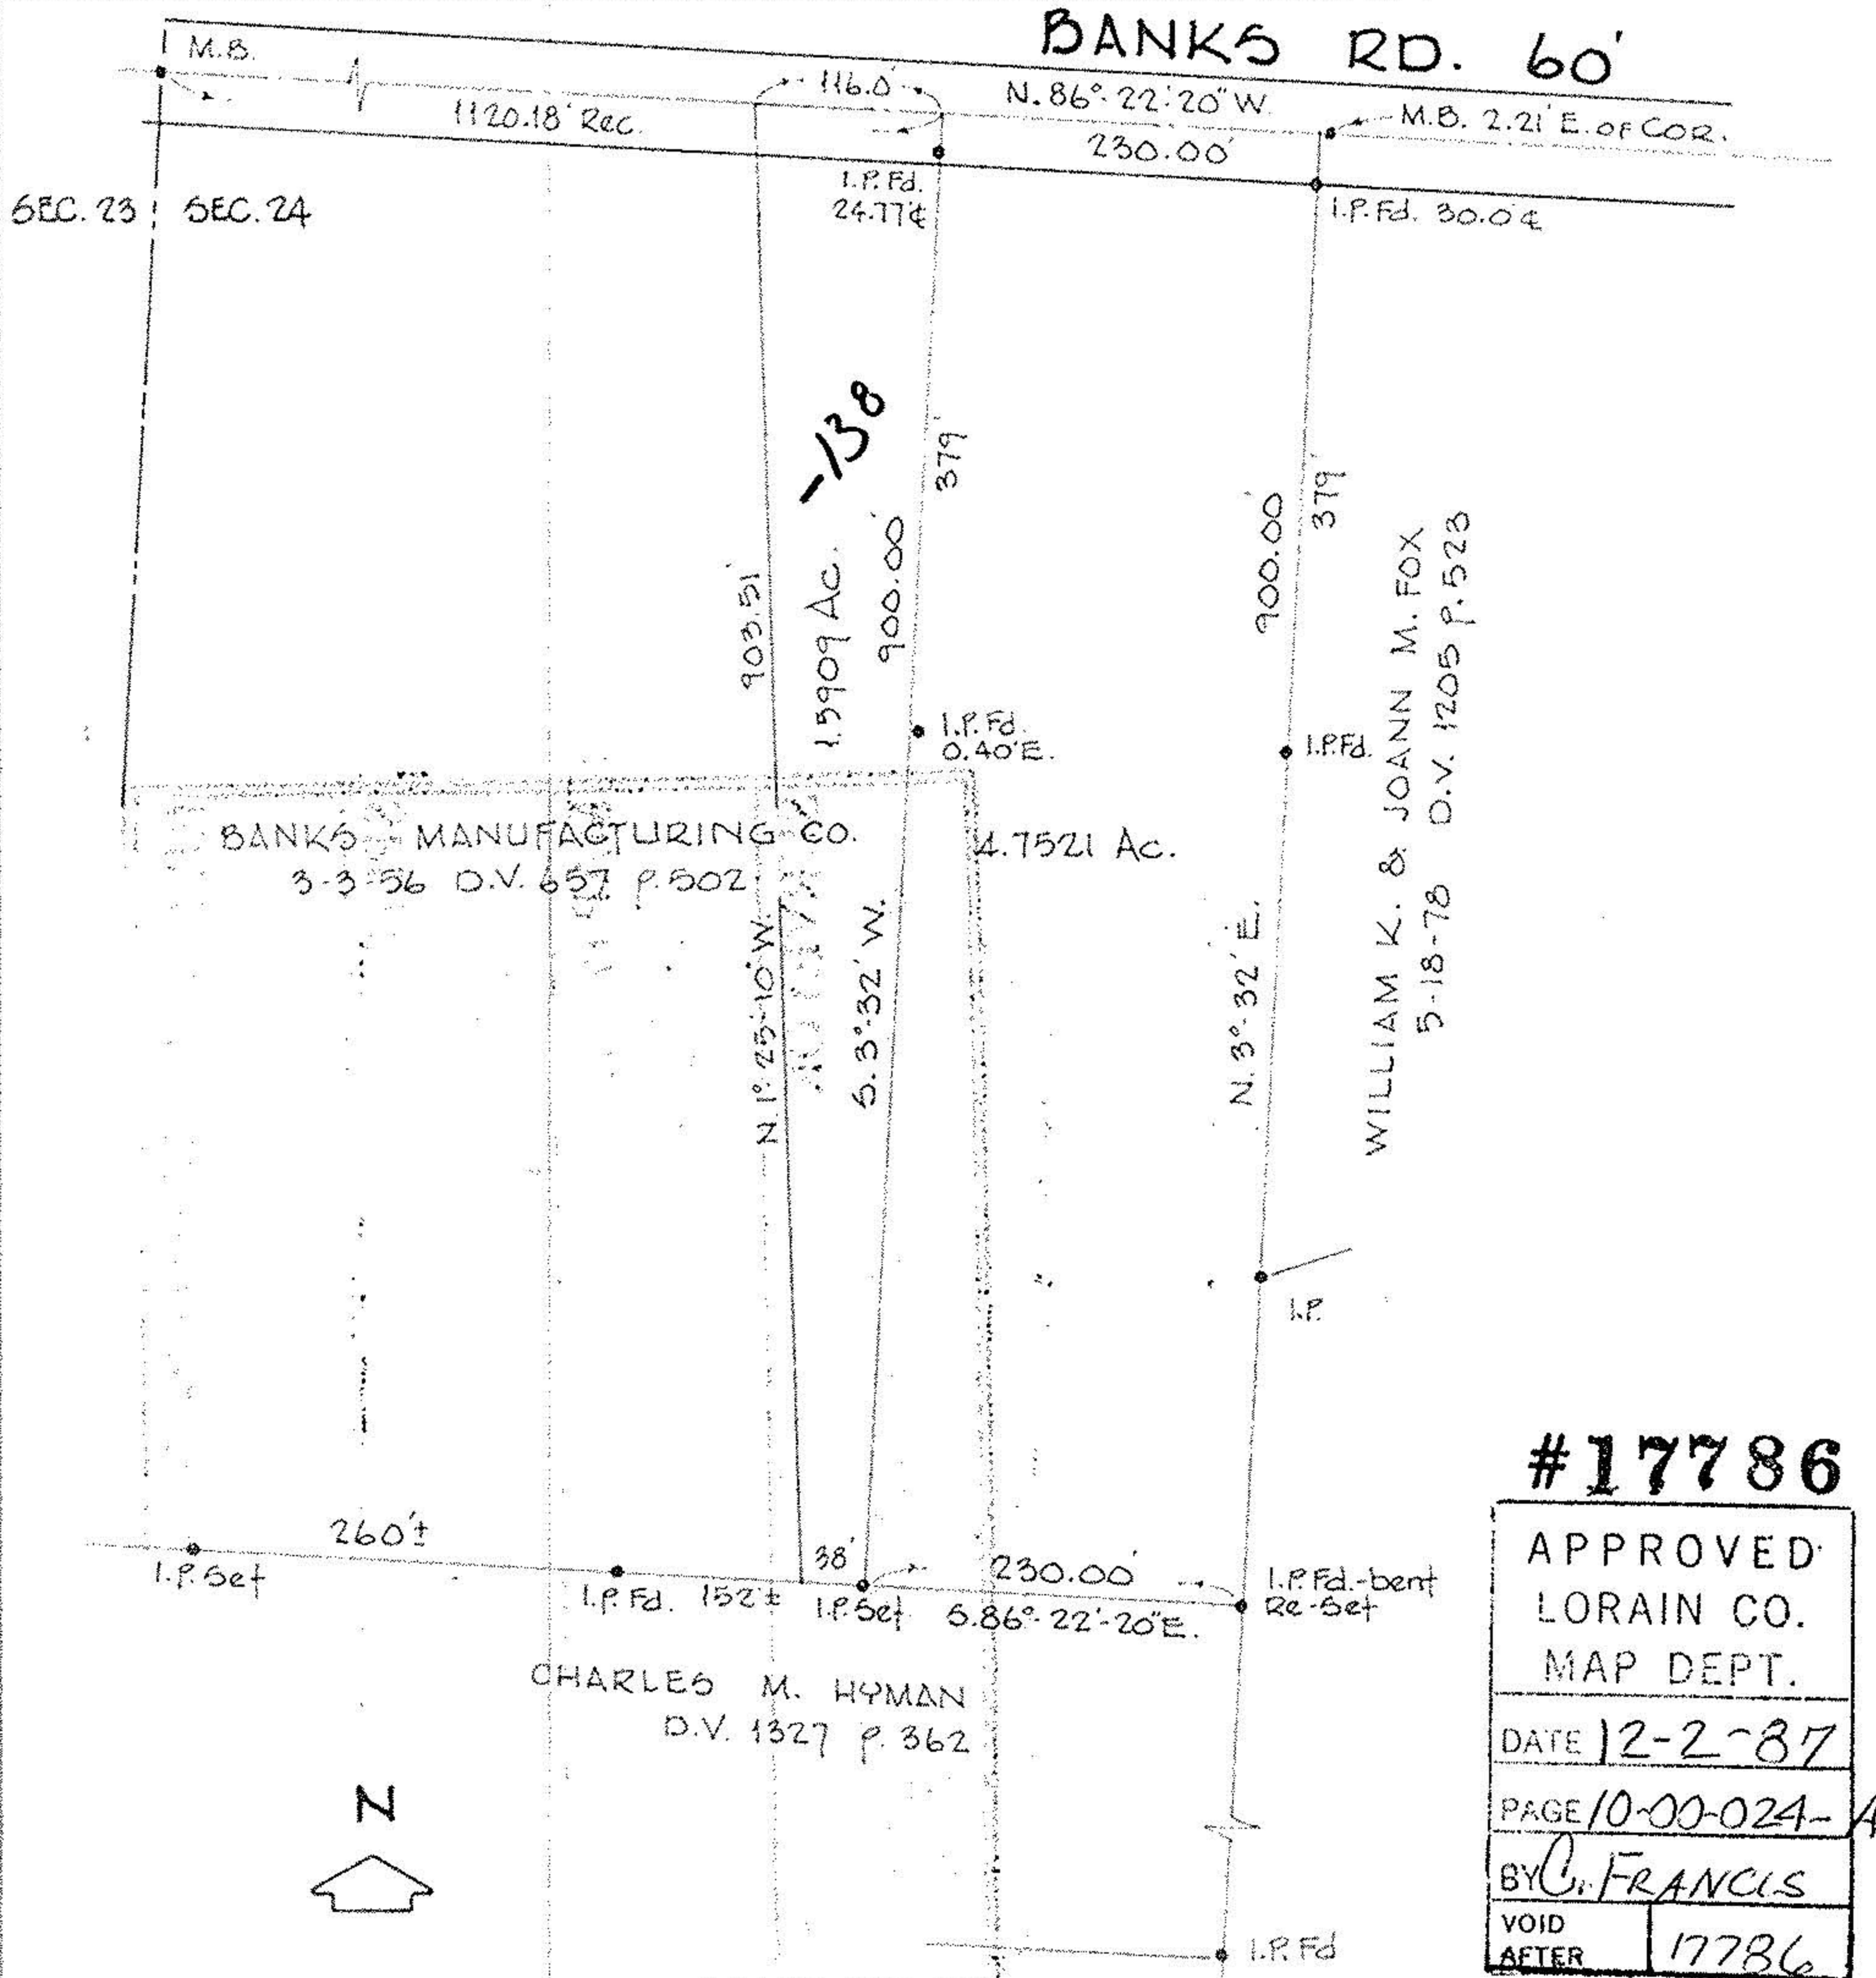

#17786

APPROVED	
LORAIN CO.	
MAP DEPT.	
DATE	12-2-87
PAGE	10-00-024-A
BY	C. FRANCIS
VOID AFTER	17786

REV. 11-19-87 15909 Pcl.

