


10-00-005-101-

10000

10-00-005-A

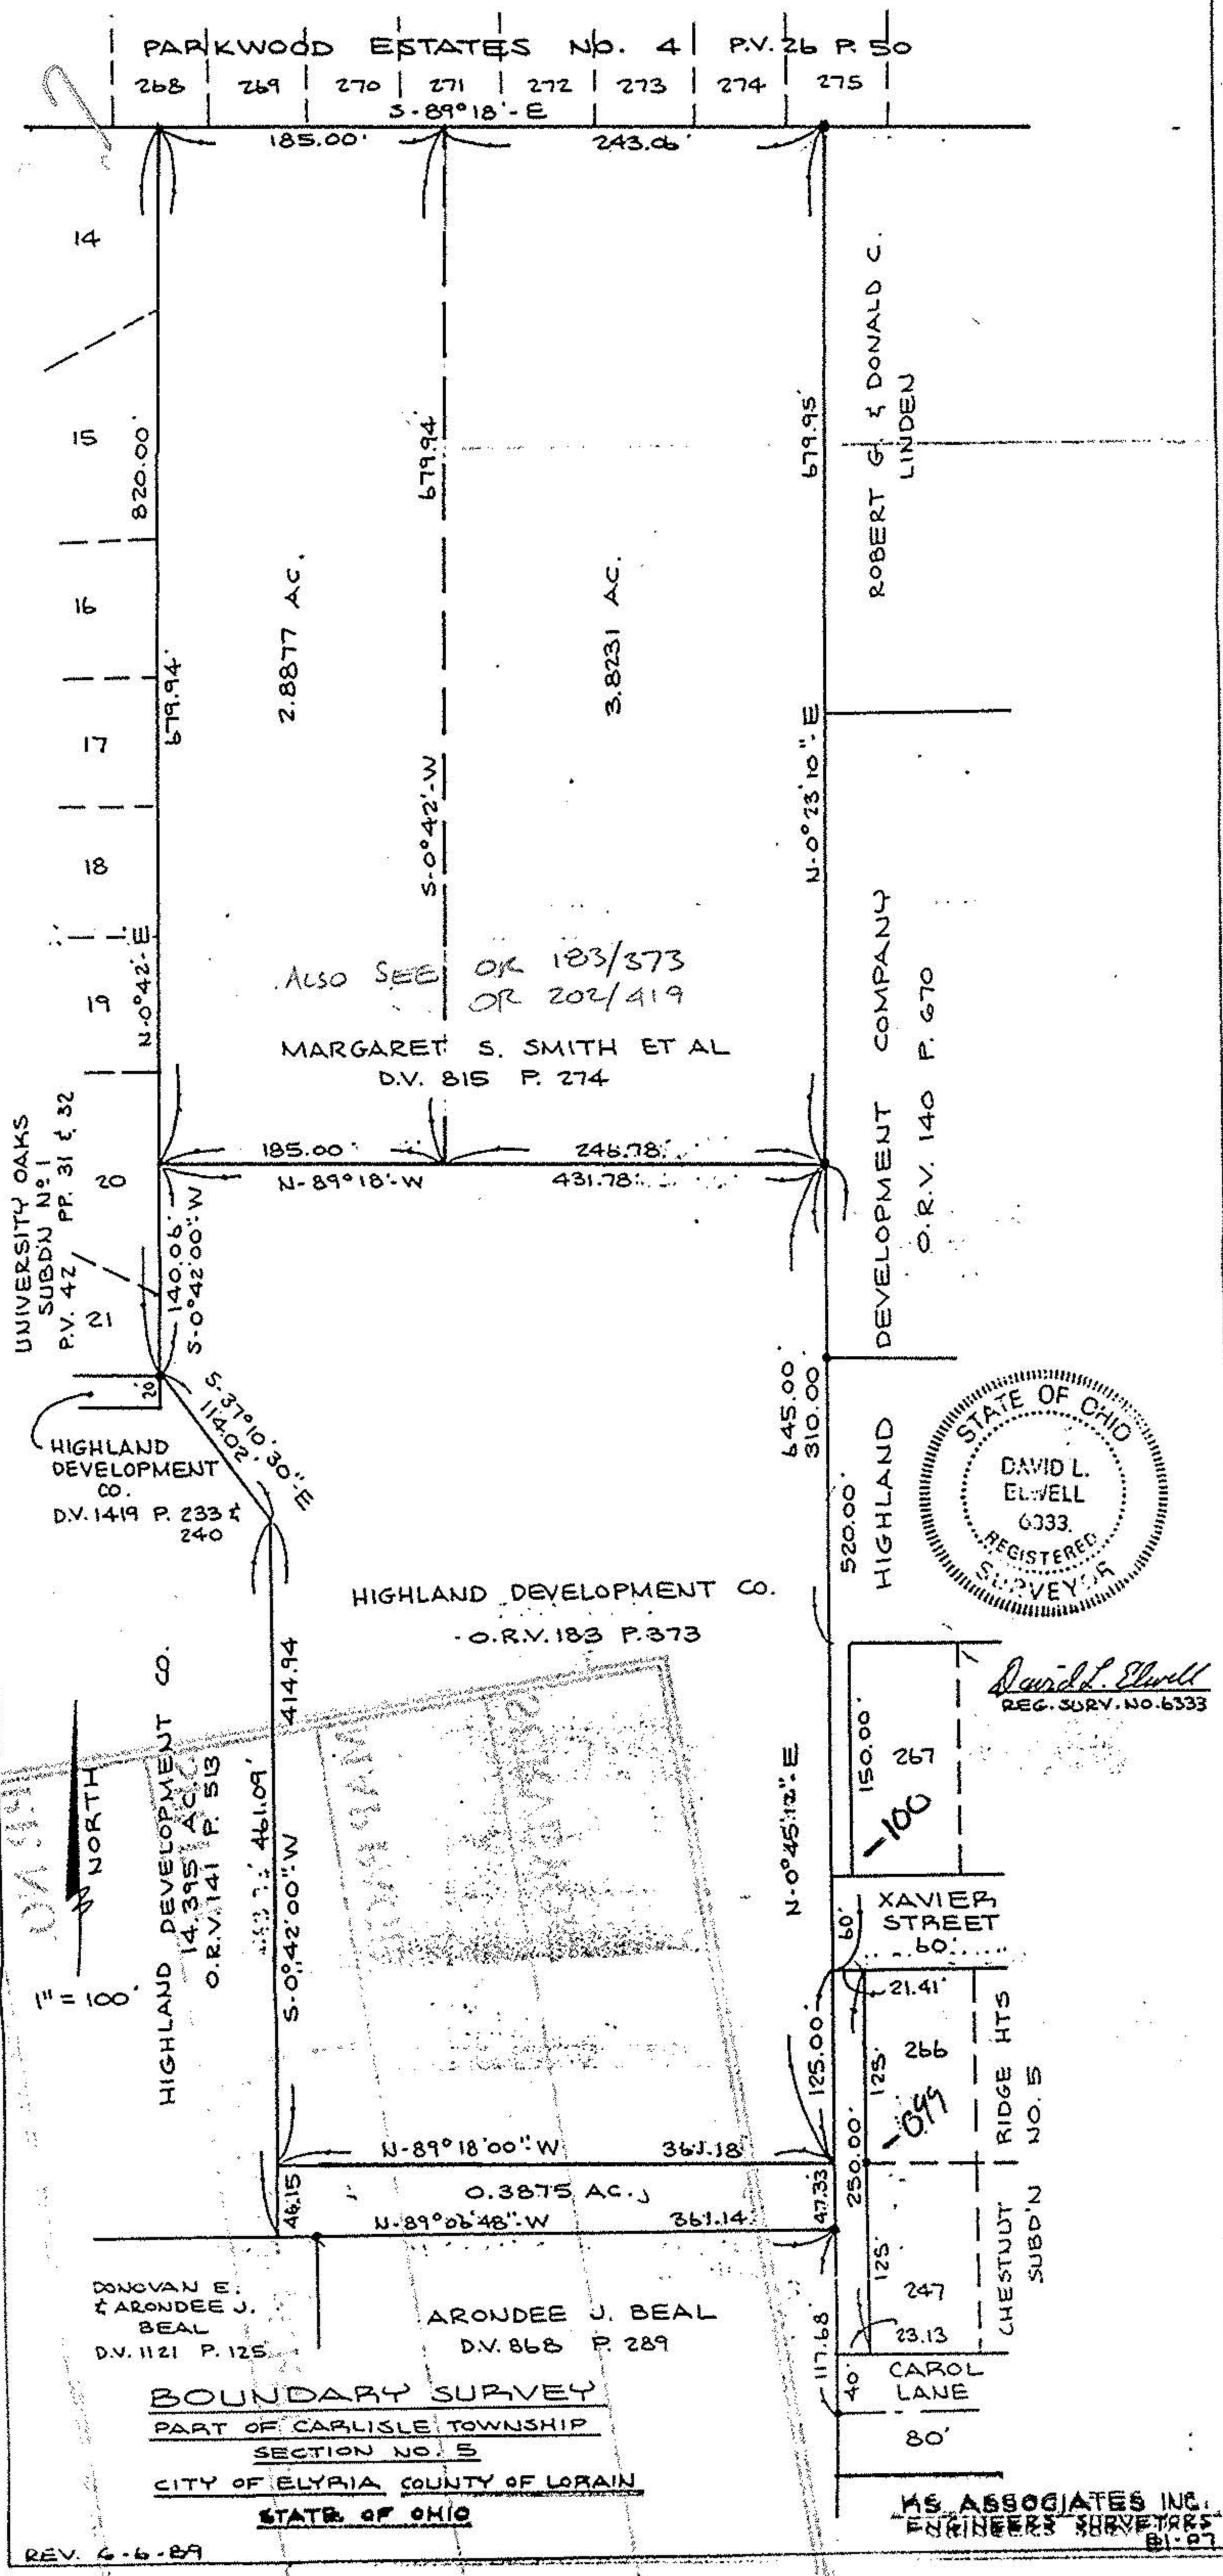

18878

APPROVED
 LORAIN CO.
 MAP DEPT.

DATE 3-14-90

PAGE 10-00-005-A

BY CAROLYN FRANCIS

VOY # 18878