

10-00-004-B

20064-A

10-00-004-129 - See Deed





LAUNDON • SIMON • CAHL & ASSOC., INC.
CONSULTING ENGINEERS & SURVEYORS
1100 MIDDLE AVE., ELYRIA, O. 44035

SURVEY FOR:
WADE E. & BONNIE E.
HETSLEER

Orig. Lot	City of ELYRIA	Date JUNE '92	Scale 1"=40'
Orig. Sec 4	Village of	Dwn. by R.G.S. CHkd. by R.C.	
Tract	County of LORAIN	Job No. 92-2193	F.B. 218/8
Township of CARLISLE	State of OHIO	Printed JUL 8 1992	

MAP-VOID-
DEED INFO
DIFFERENT
CHANGES MADE
BY SURVEYOR
OF 10-29-93
DEED
COLO. R. 654
282

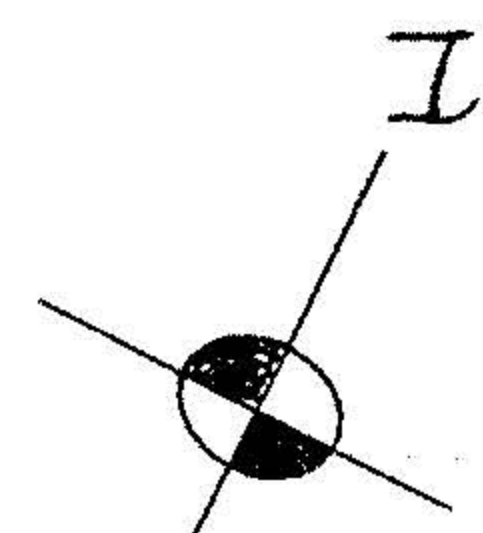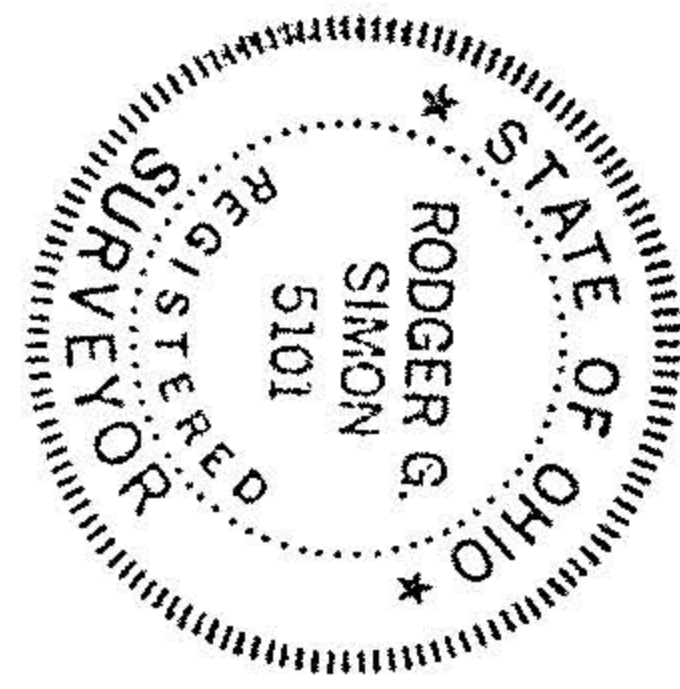

GEO. W. & IRMA R. LYNCH
V. 1136 P. 393 V. 1332 P. 108

EAST BRANCH OF
BLACK RIVER



- 022
404
Acres

PCL. No 33 RICHARD & VERA DEMBY TRS.
R.V. TRUST ORV. 243 P. 8

20064-A

MAP DEPT.
DATE 1-11-93
PAGE 10-00-004-B
BY CALOLYN FRANCIS
VOID AFTER # 20064-A

± FULLER RD.