



#22707

APPROVED
LORAIN CO.
MAP DEPT.
DATE 12-2-98
PAGE 12-E
BY J. Spick
NO. 22707

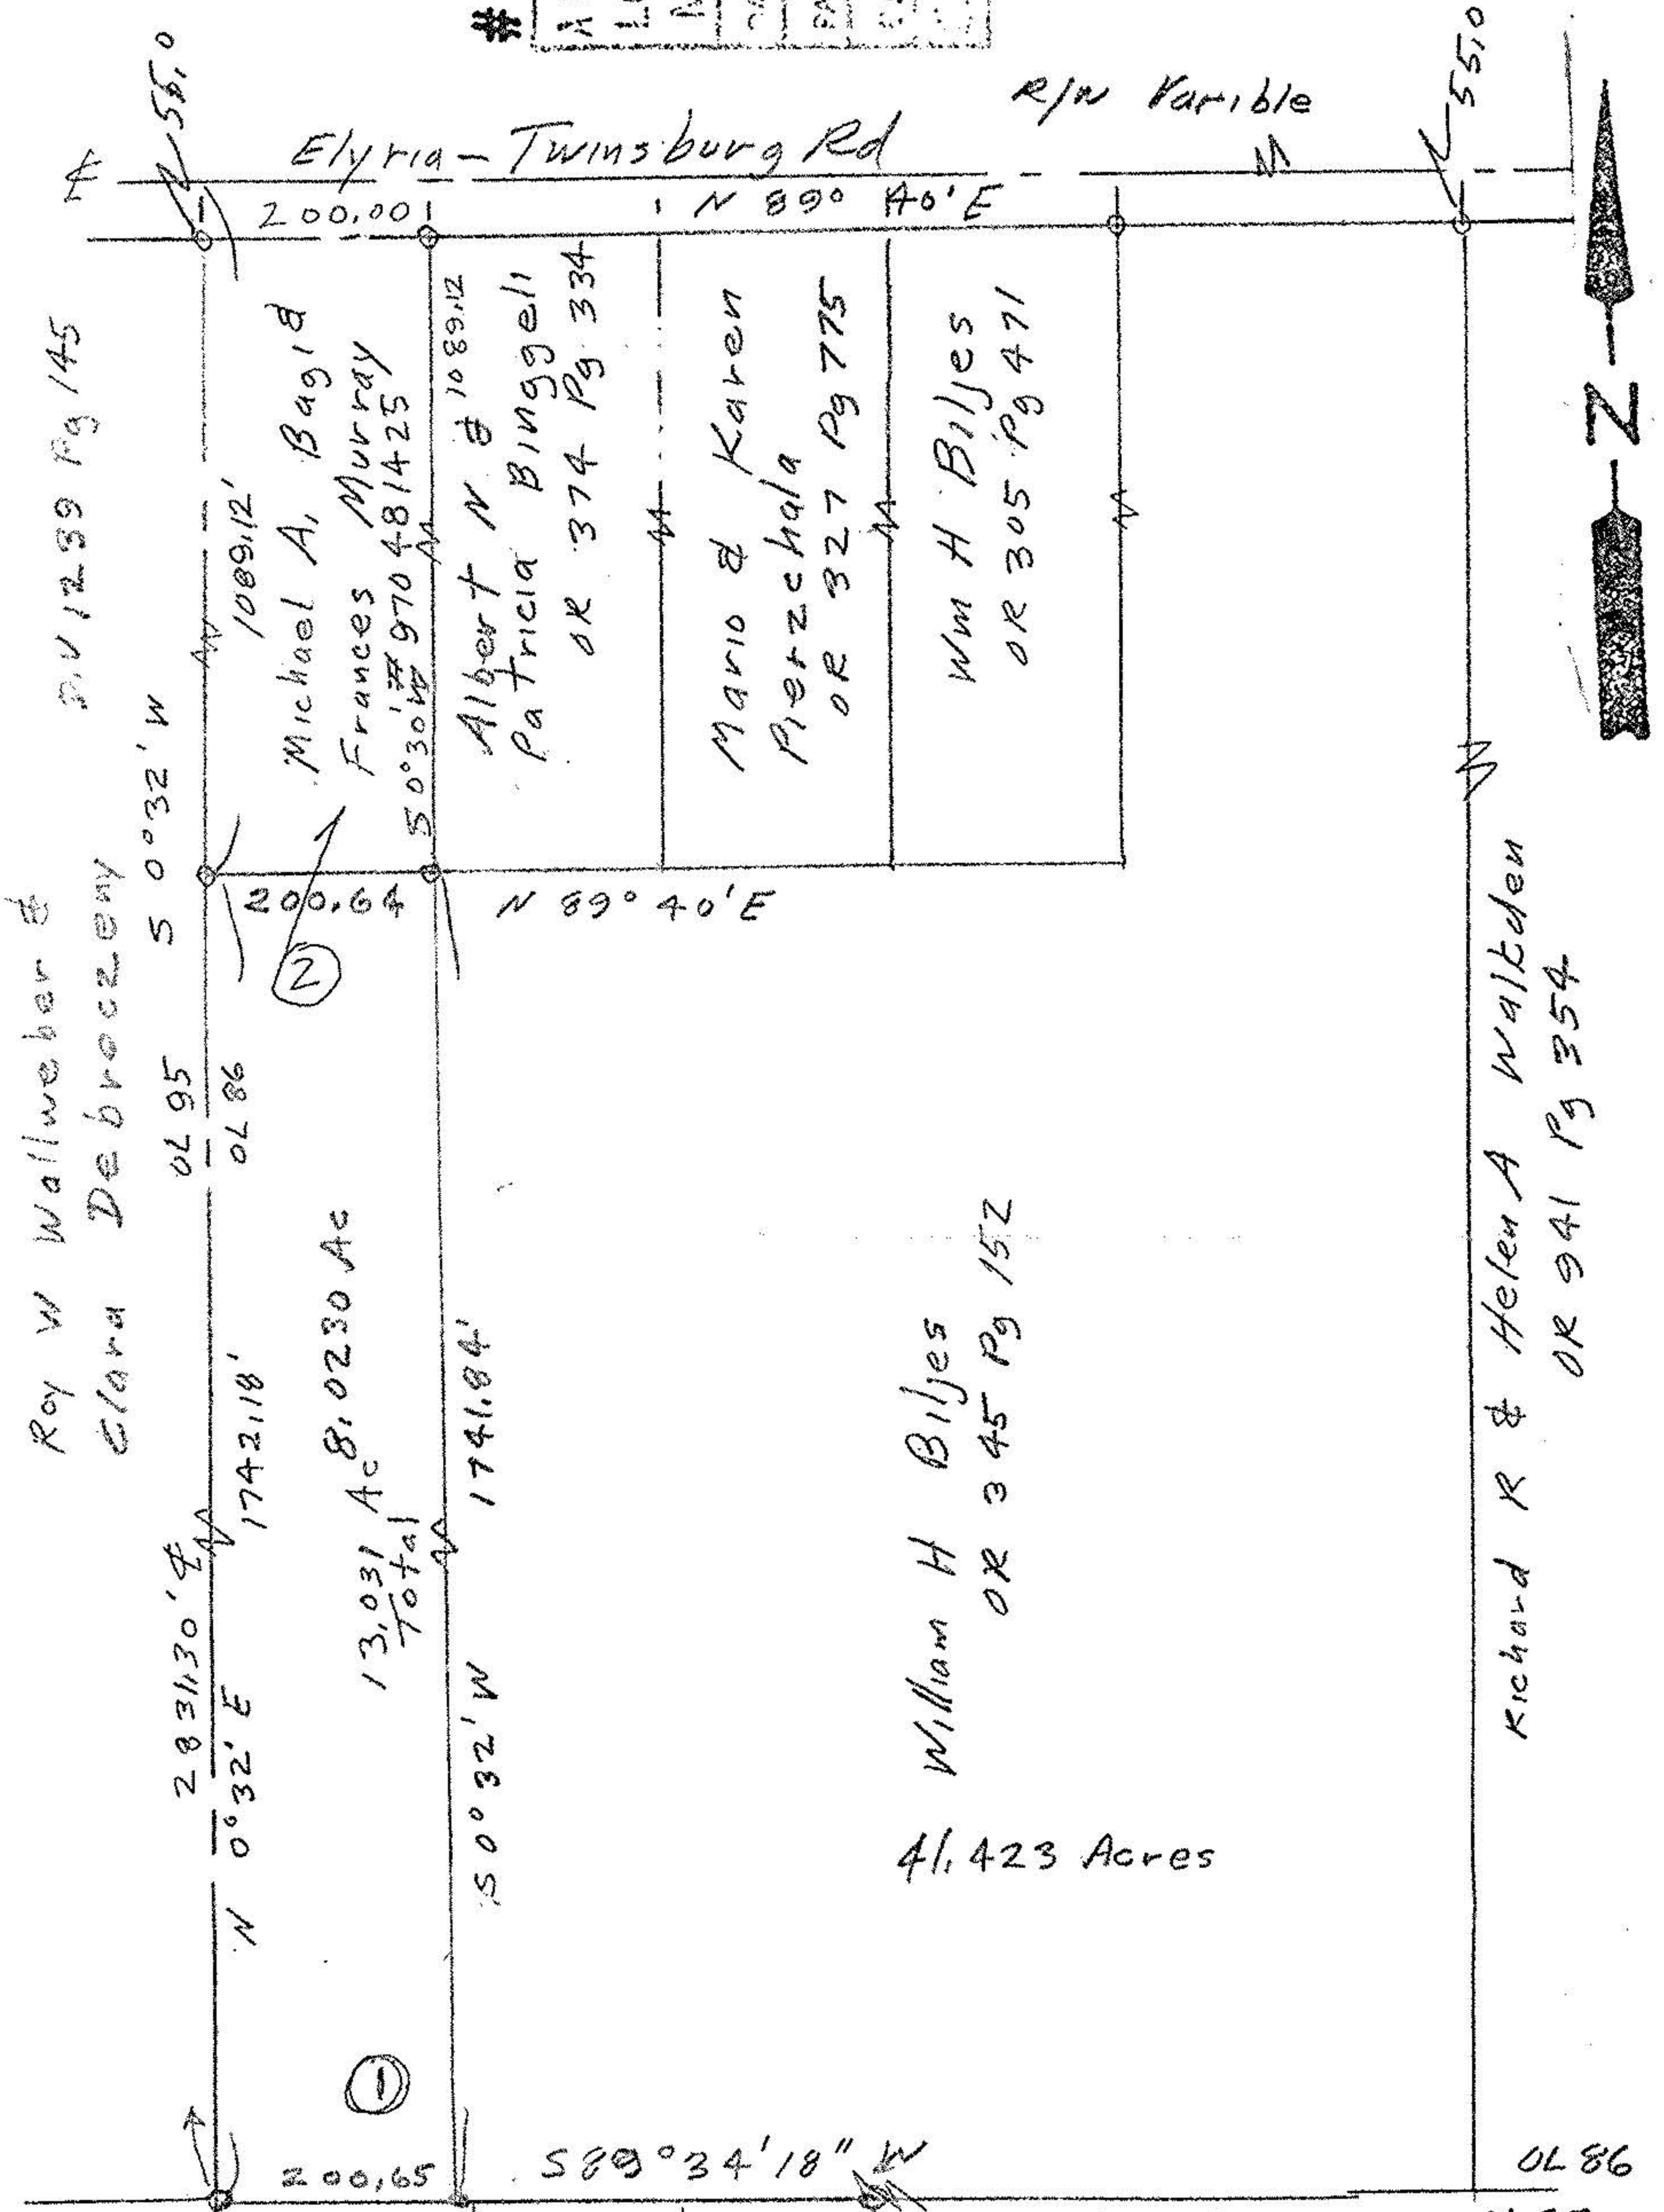

o iron pins fd
 • iron pins set
 John Pozywak

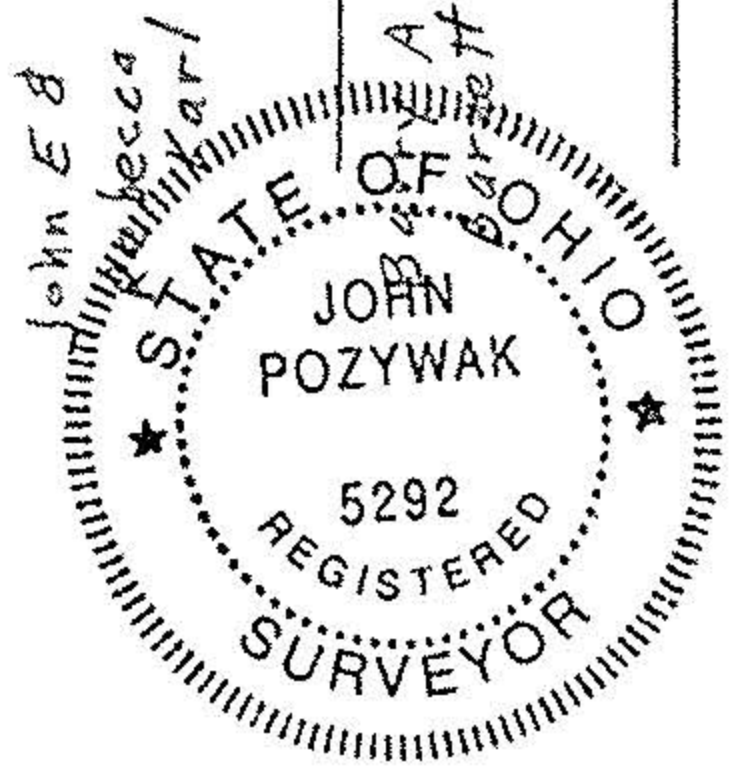

Survey of Parcel Split
 Original Lot 86
 Columbia Township
 Lorain County Ohio
 Scale 1"=200' Aug 16, 1998

