


Lot 33
 Survey Map of Part of Lot 23 Russia Twp. Lorain Co. Ohio
 Dec. 27, 1983 By Arnold F. Koepf Reg. Surveyor No. 4306

VOL 1167-107
 Helen Cobb ETAL; CERT

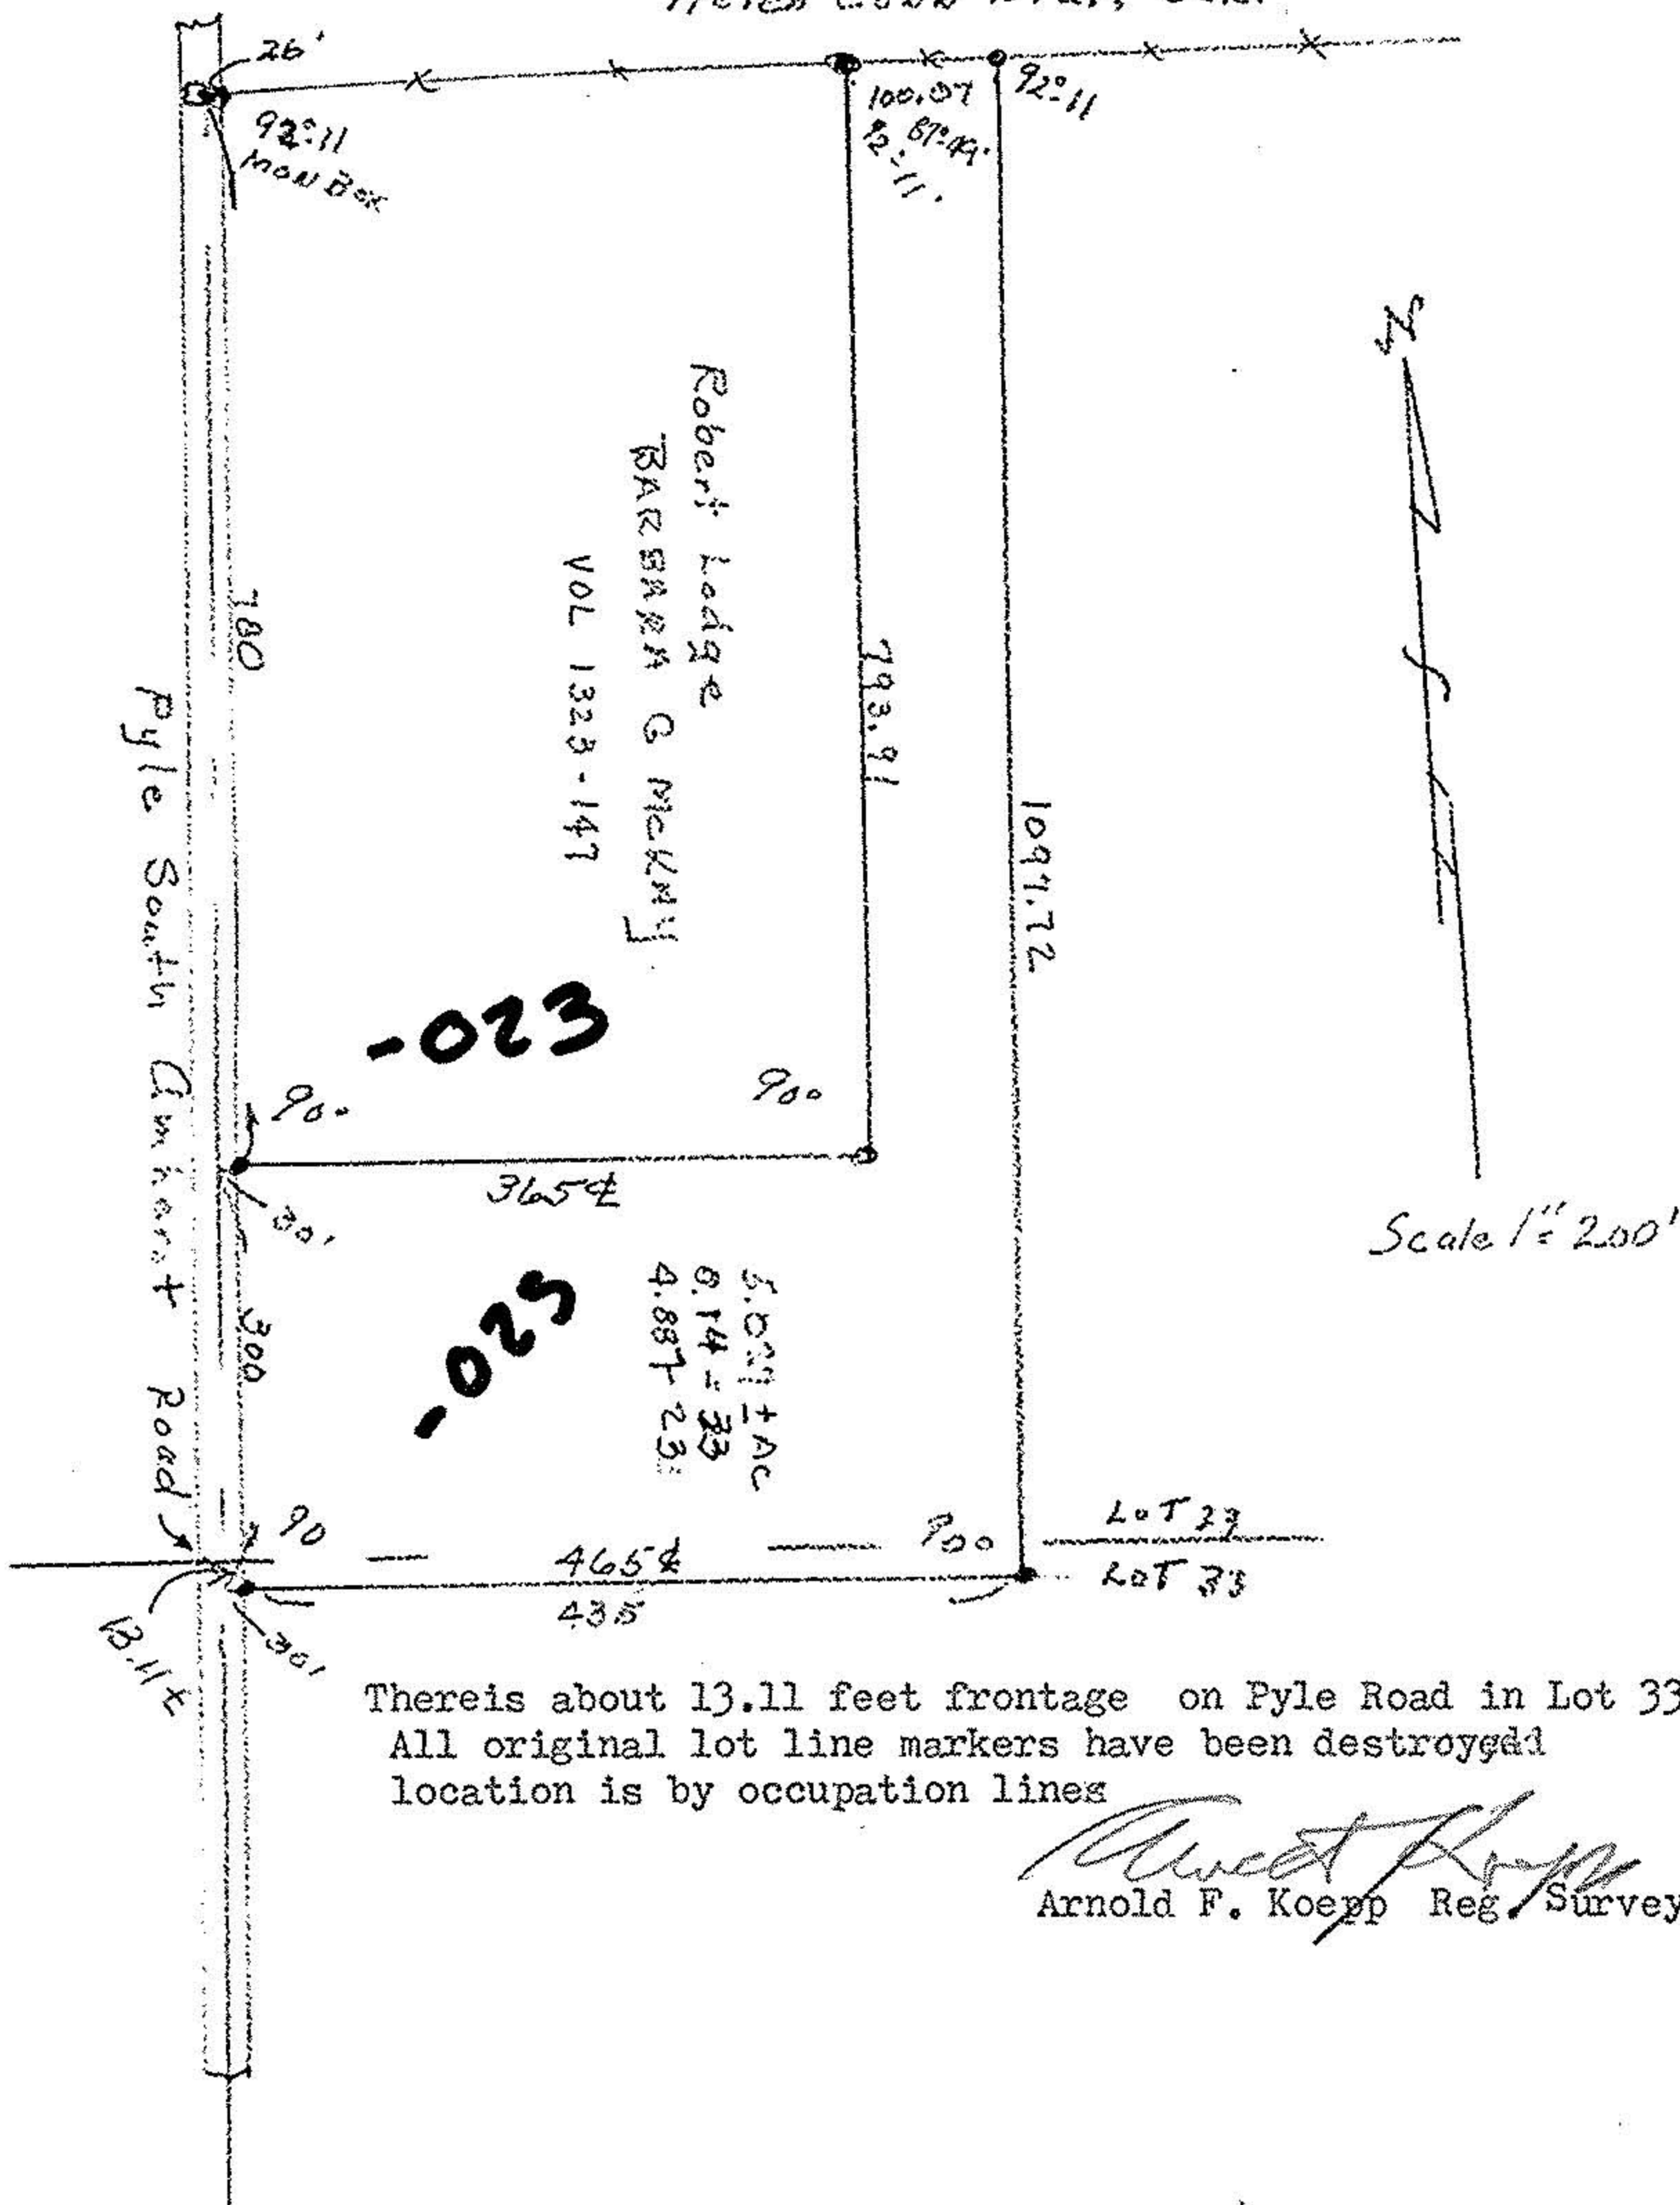

-023

520-

Thereis about 13.11 feet frontage on Pyle Road in Lot 33
 All original lot line markers have been destroyed
 location is by occupation lines

Arnold F. Koepf
 Arnold F. Koepf Reg. Surveyor

9-00-023-B
 9-A o.l. 33

#15448

09-00-023-102
 09-00-033-000

#15448
 APPROVED
 LORAIN CO.
 MAP DEPT.
 DATE 3-1-84
 PAGE 9-A & 9-00-023B
 BY T. McNeil
 VOID
 WJES