

9-00-079-A

09-00-079-050

N 87° 16' 39" E  
230.91'

81.62'

JAN 21 1975

2.7953 ACRES

1.1039 ACRES

-027



S 2° 13' 17" W 522.95'

Hedge row follows this line, all the way back.

S 2° 13' 17" W 535.75'

Property in question.


N 0° 31' 0" E 540.00'

9-00-079-06

09-00-079-A

Monroe Barber

Leonard Leshar

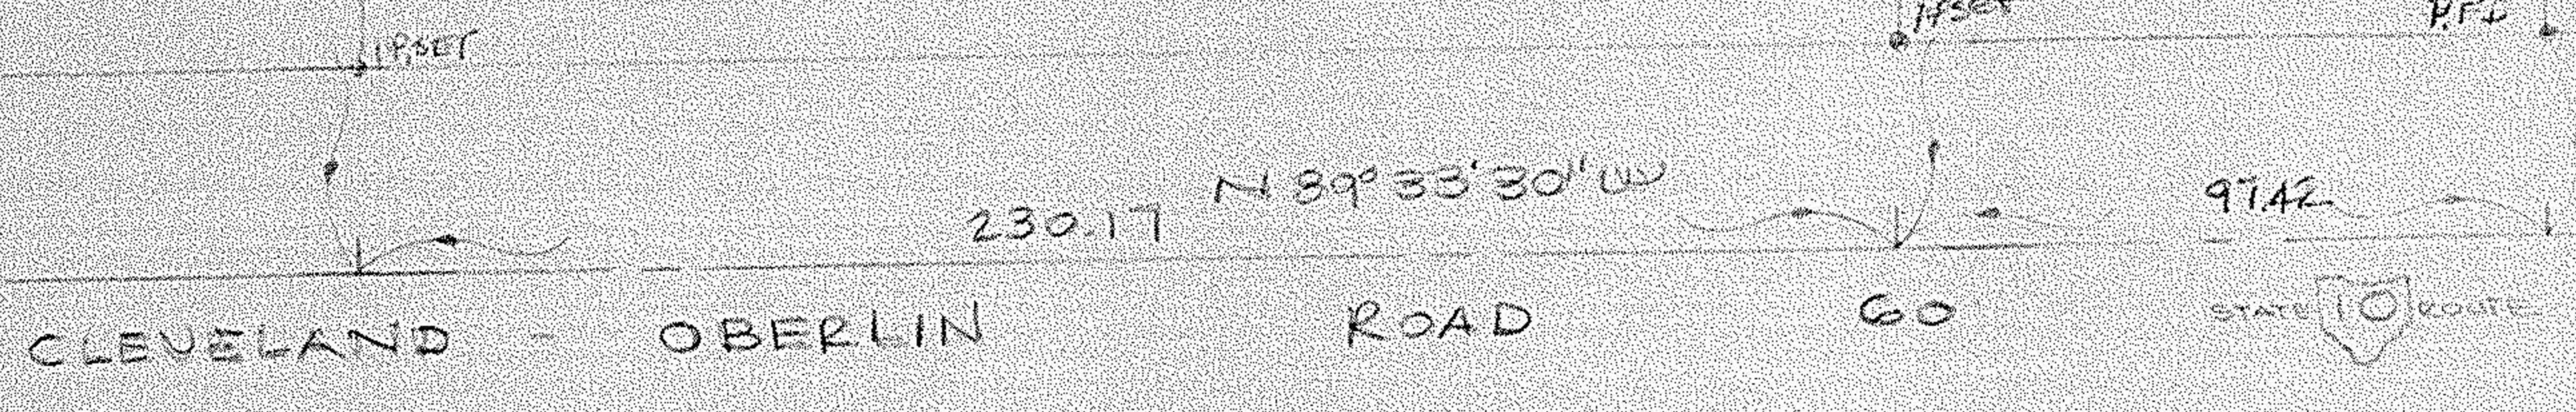

SURVEY PART OF  
ORIGINAL RUSSIA TWP LOT 19  
COUNTY OF LOZAIN STATE OF OHIO  
SCALE: 1" = 40'

DATE: MAY 71  
REVISED: JUNE 2, 1971

FOR  
MAZJOS E BURGETT

BY  
D.D. ANDRUS  
REGISTERED SURVEYOR  
ELKIN, OHIO