


B. C. LAND CO.
12-20-73 V. 1073 P. 509

REVISED FOR
GEORGE H. SIEGEL & JEAN T. GUESS
JANUARY, 1996

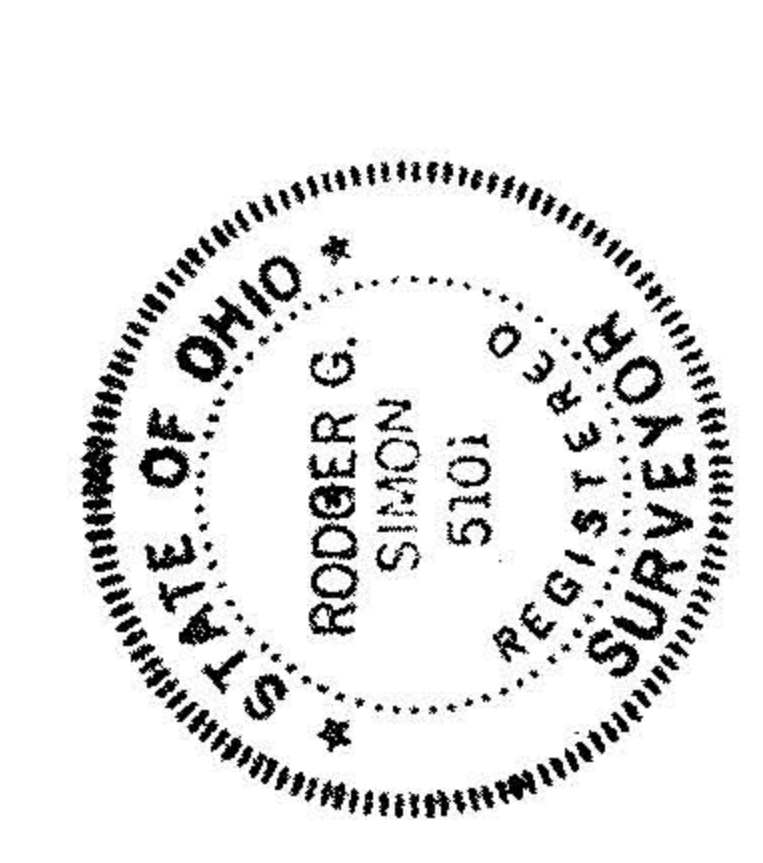

#00540
APPROVED
LORAIN CO.
MAP DEPT.
DATE 8-24-00
PAGE 9-00-078-A
BY J. Hatfield
#00-00540

C.M. & M. DEVELOPMENT INC.

SURVEY FOR

PART OF O.L. 78 RUBENIA TOWNSHIP
COUNTY OF LORAIN
STATE OF OHIO
SCALE 1"=100'
LAUNDON • SIMON • CAHL & ASSOC.
ENGINEERS
SURVEYORS
JOB NO. 04-1955
P.B. 116 P. 95

REV. 1/20/96 Change Corp. Line K.G.S.
REV. 5/9/04 Acreage for annexation R.G.S.