



LAUNDON . SIMON . CAHL & ASSOC. INC.
CONSULTING ENGINEERS & SURVEYORS
219 COURT ST. ELYRIA, OHIO 44035

SURVEY FOR:
OBERLIN COLLEGE

Orig. Lot 75	City of OBERLIN	Date AUG. '91	Scale 1"=50'
Orig. Sec	Village of	Dwn. by R.G.S.	Chkd. by R.C.
Tract	County of LORAIN	Job No. 91-2086 F.B. 221/46	
Township of RUSSIA	State of OHIO	Printed JAN 23 1992	


BEARINGS SHOWN ARE ASSUMED
AND USED TO DESCRIBE ANGLES
ONLY.

I.P. Mon. @ Walnut
St. Used

19709

APPROVED
LORAIN CO.
MAP DEPT.
DATE 12-18-92
PAGE 9-10-075-B
BY CAROLYN
FRANCIS
VOID AFTER # 19709

OBERLIN COLLEGE

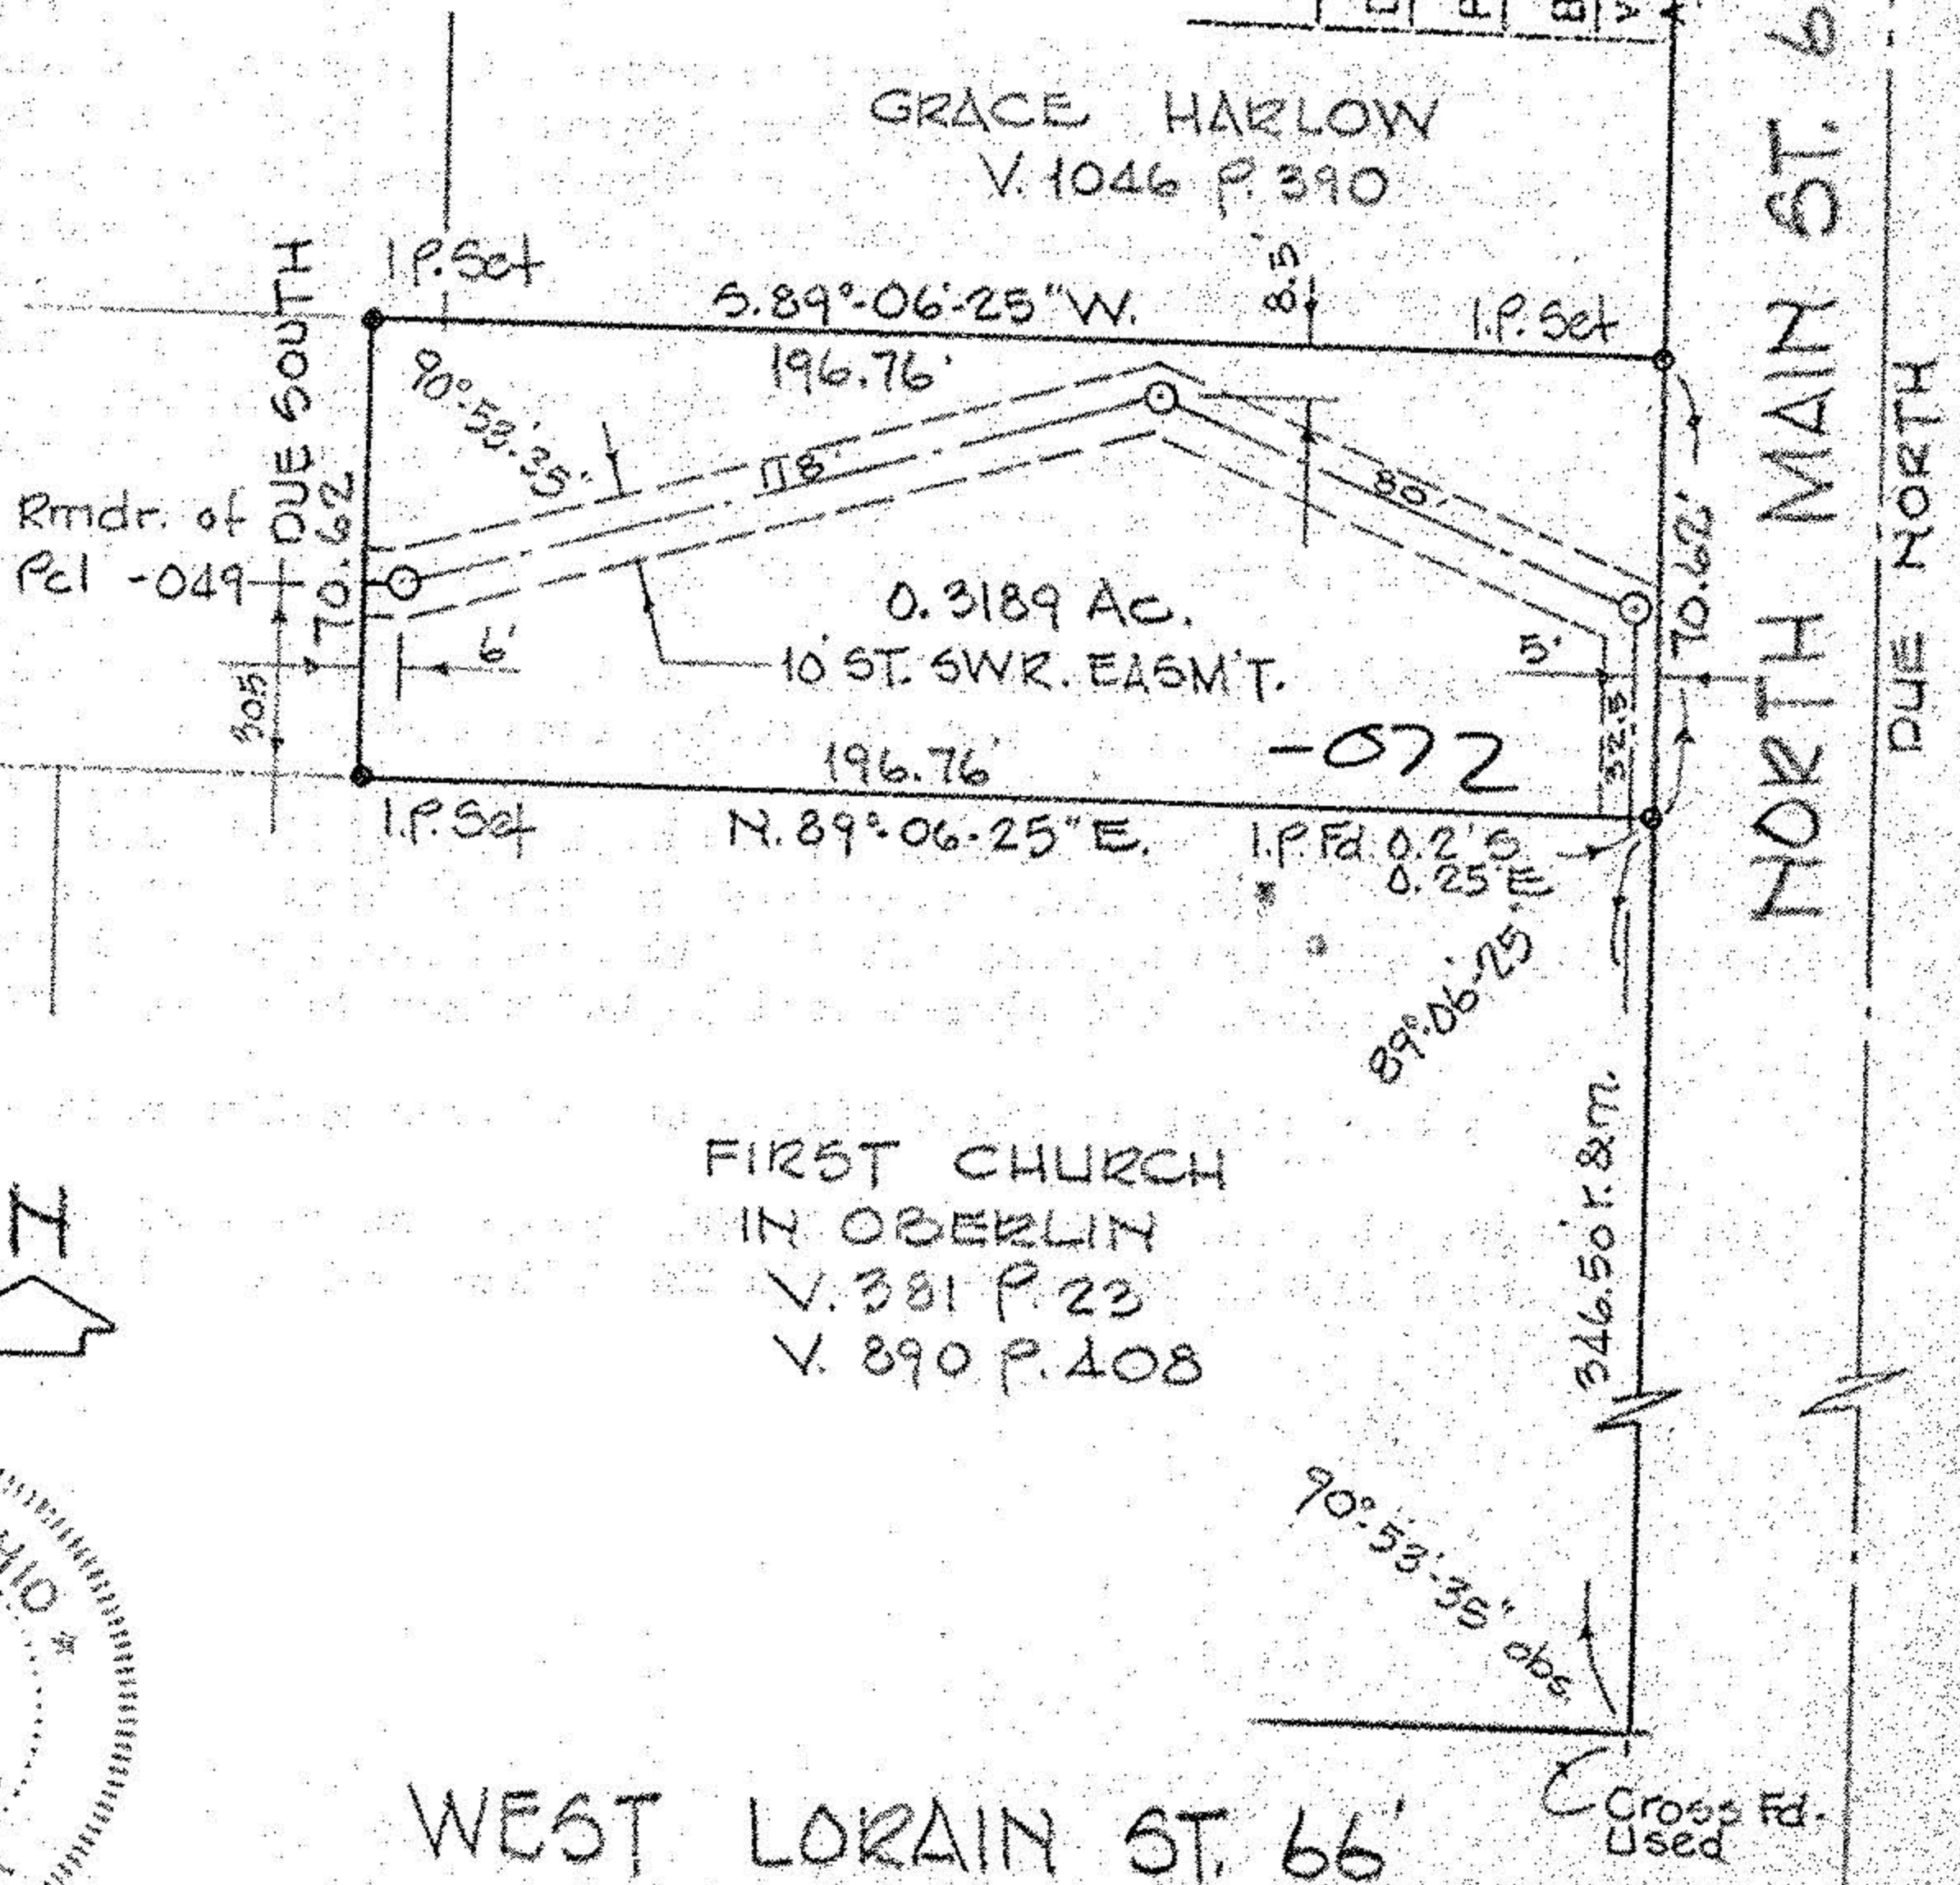

FIRST CHURCH
IN OBERLIN
V. 381 P. 23
V. 890 P. 408

WEST LORAIN ST. 66'

Cross Fd. Used



19709

9-00-075-B

09-00-075-110