


EAST COLLEGE ST 60'

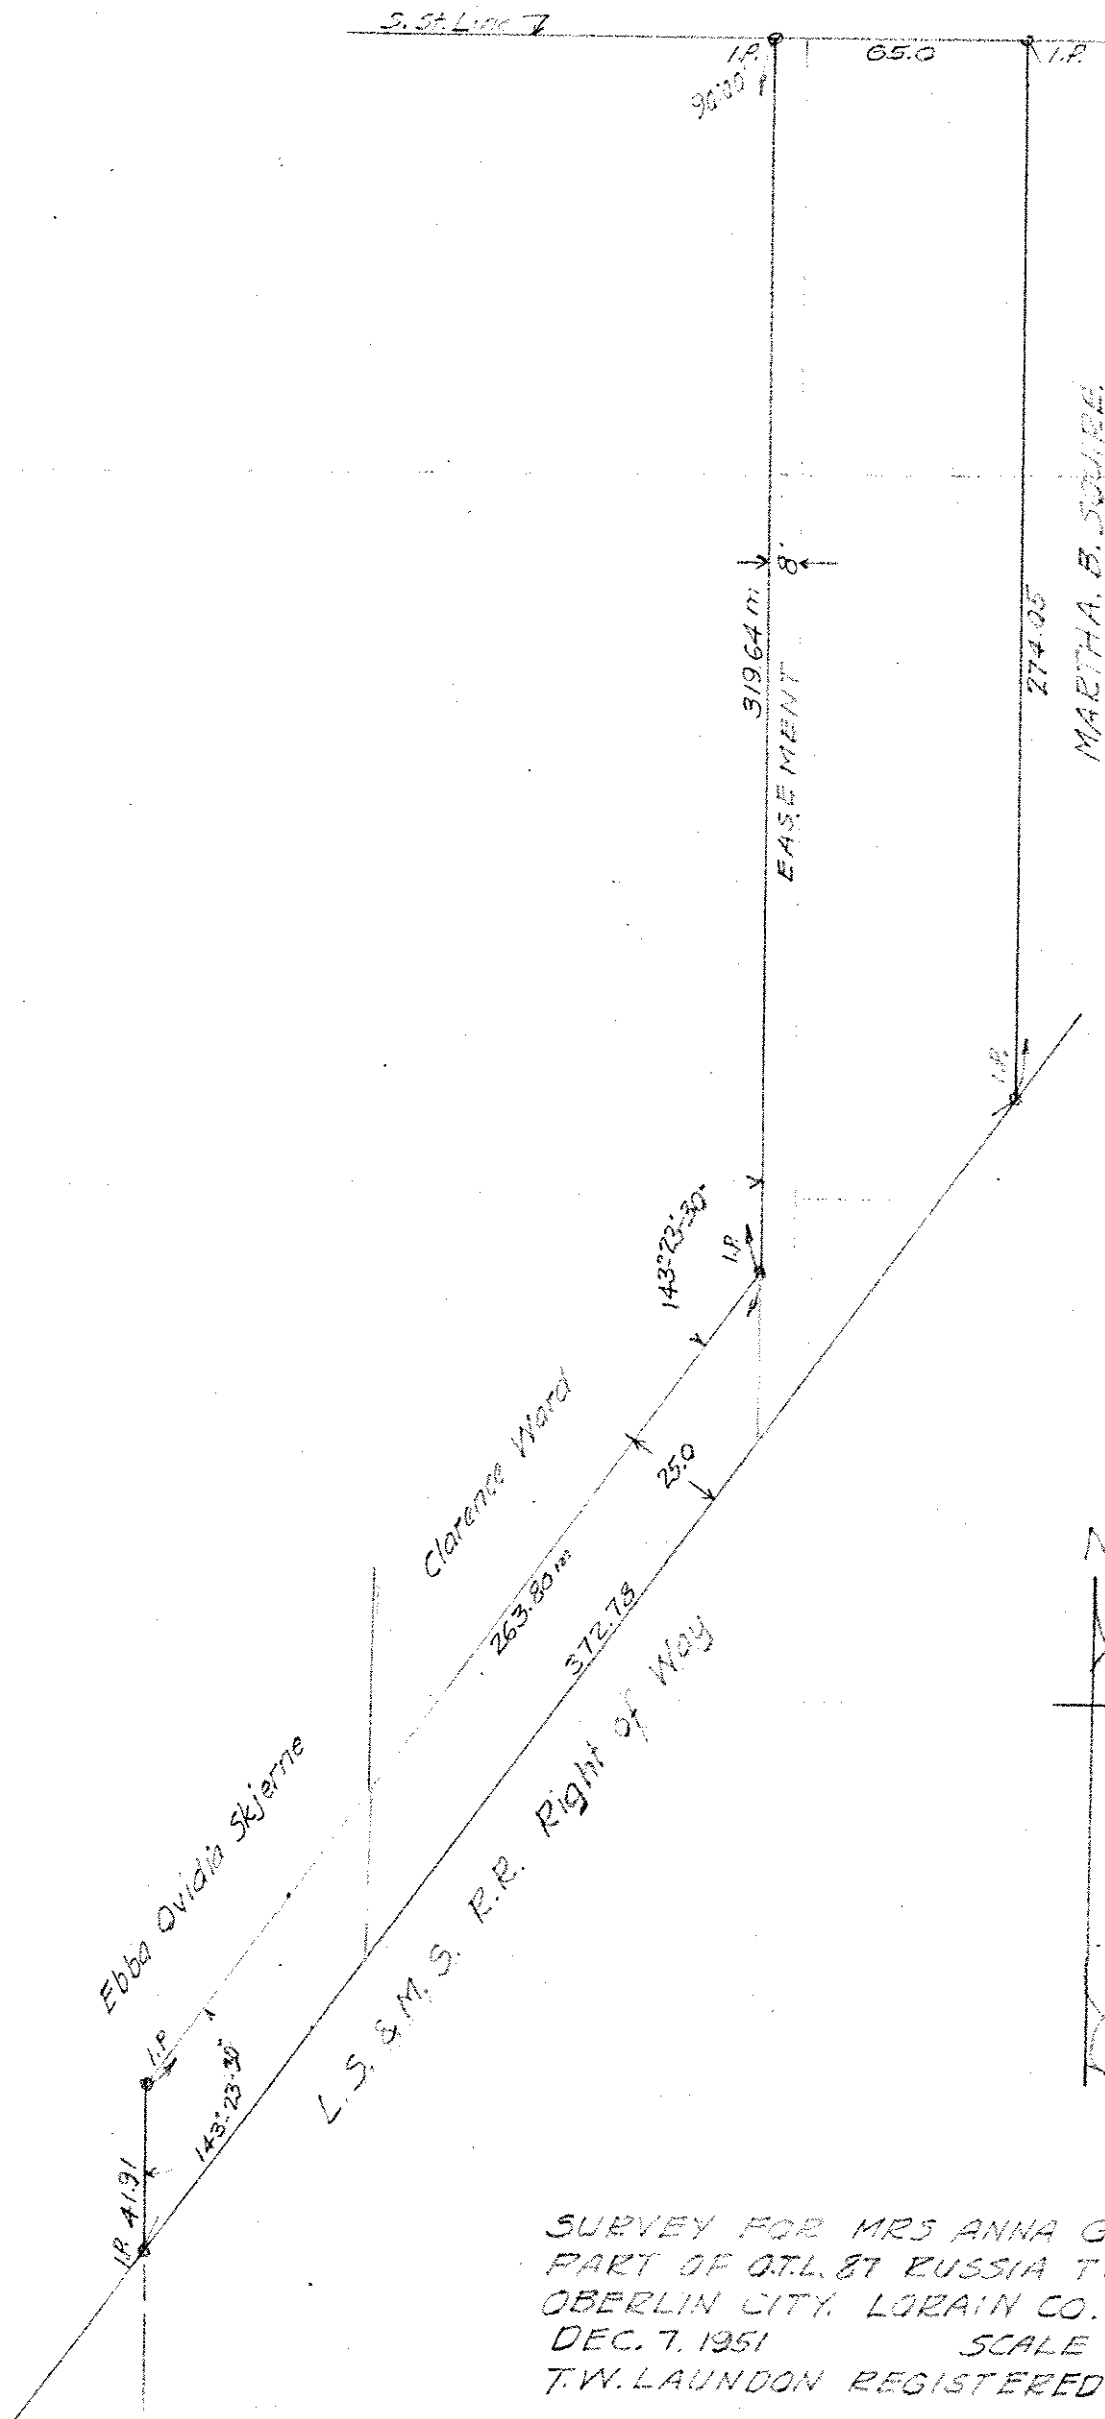

SURVEY FOR MRS ANNA GOESKE  
PART OF QTL 87 RUSSIA TWP  
OBERLIN CITY, LORAIN CO., OHIO.  
DEC. 7, 1951 SCALE 1"=50'  
T.W. LAUNDON REGISTERED SURVEYOR