



9562 PATRICIA CT  
 ENVRIA OHIO 44035  
 440-322-4109 - HOME  
 440-537-3314 - CELL

-050  
 Milton J. & Jean Lois Baker  
 Doc. 97-0483626

-090  
 Jack A. & Barbara A. Hoyt  
 O.R. 460 P. 708

PARSONS ROAD  
 I.P. Mon. fd. & used  
 -089  
 Jack A. & Barbara A. Hoyt  
 Doc. 2002-0855173

\* GAS STOPS HERE

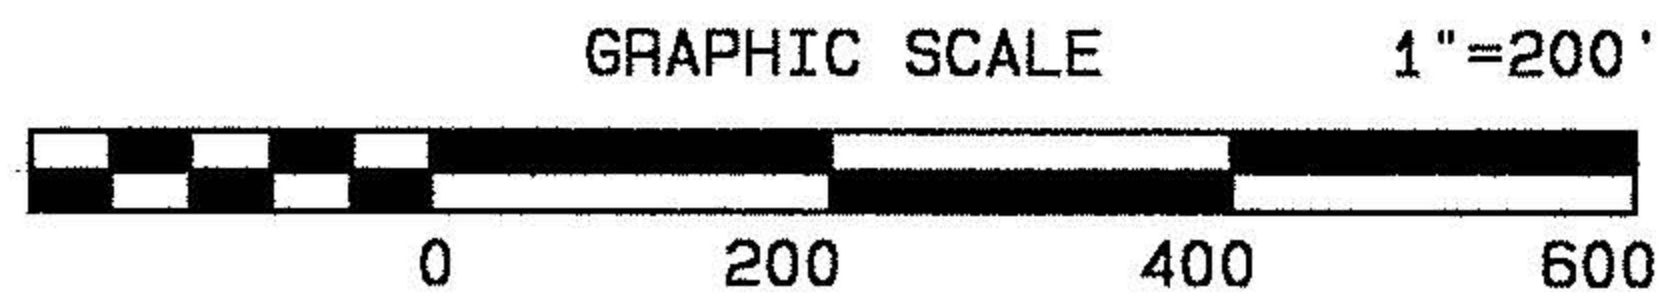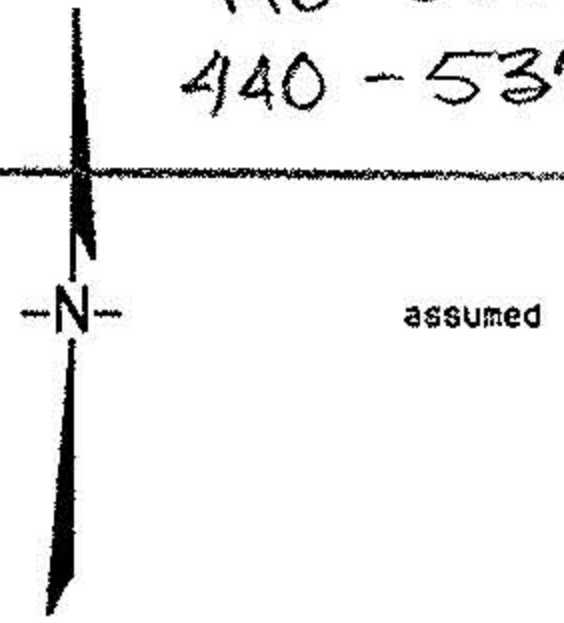

This plat of survey represents the minimum standards for boundary surveys in the State of Ohio as adopted 5-1-80 of the Administrative Code chapter 4733-37


Bearings are to an assumed meridian and used to indicate angles only.

-015  
 Gavin Land Co. LLC  
 Doc. 2001-074973  
 Pcl. 3

-018  
 Martin & Theresa Nasipak  
 V. 1105 P. 309  
 Pcl. 3



Survey For  
**WILLIAM FORTHOFFER**  
 O.L. 99 & 109 New Russia Twp.  
 Lorain County Ohio  
**CARLSON SURVEYS**  
 440-926-0200  
 November 2002  
 Job # 901-03

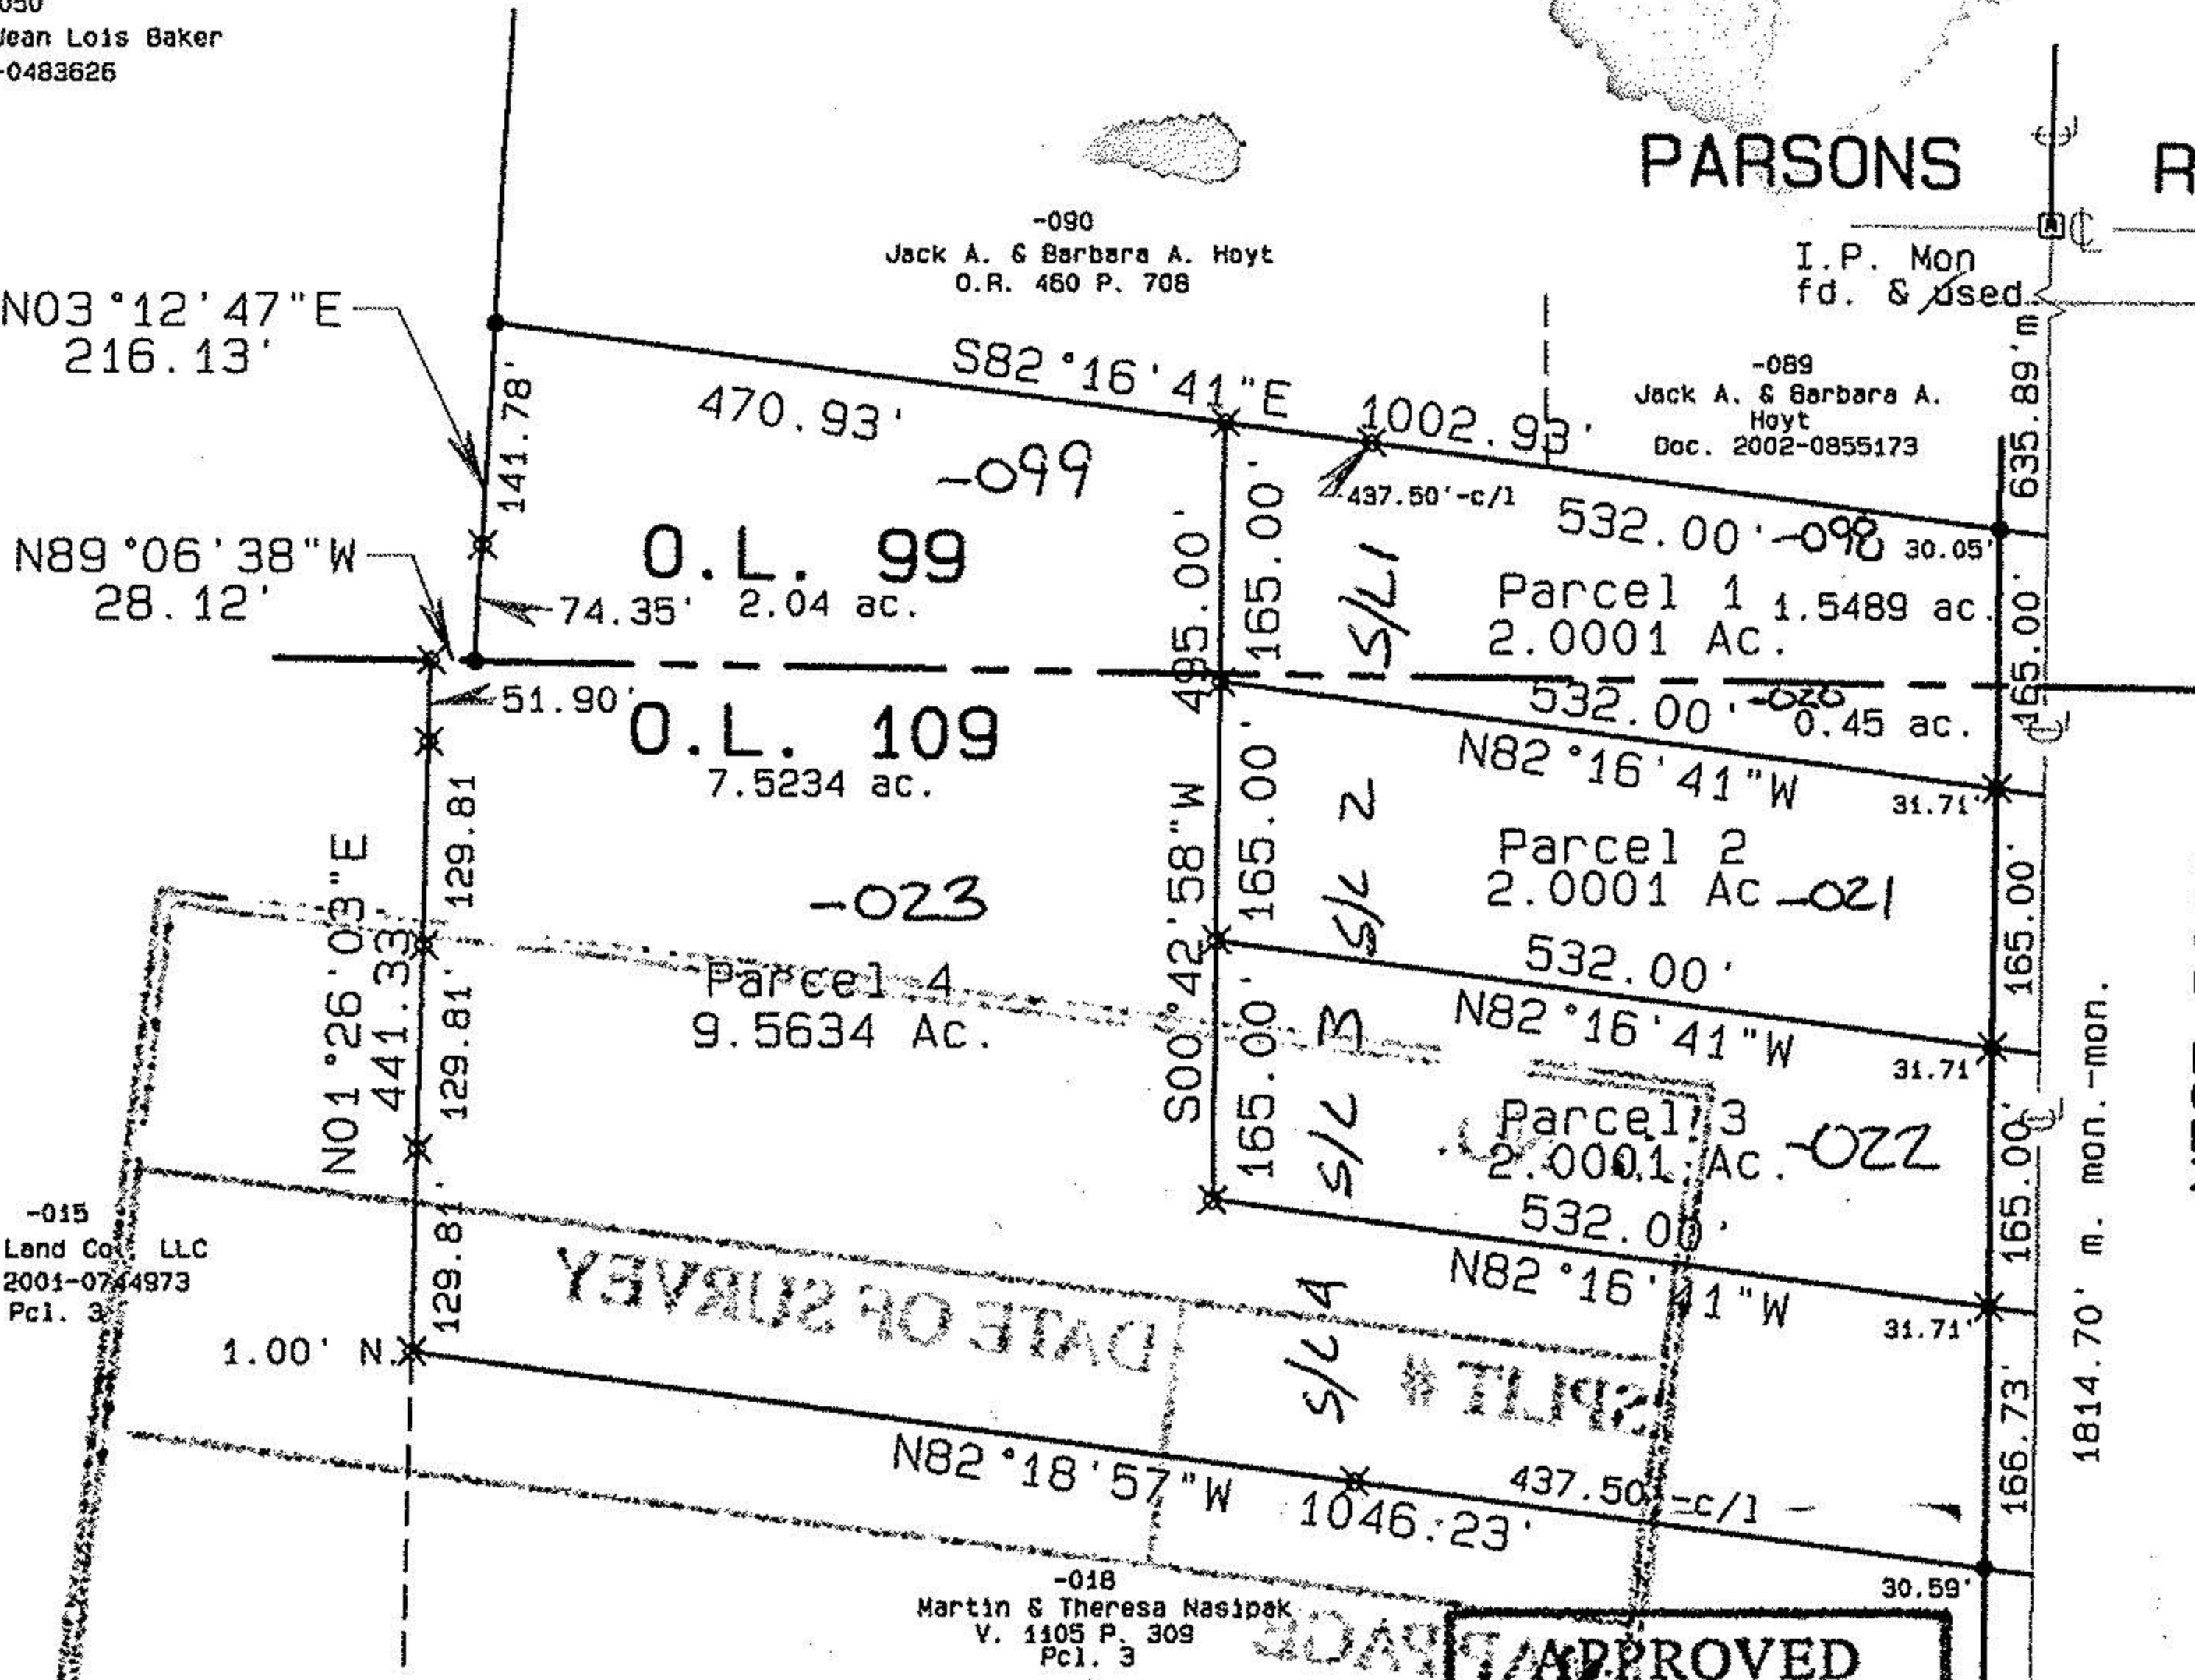

- ✕ = 5/8"x30" re-bar set with cap stamped CARLSON
- ⊠ = iron pin monument found
- = iron pin found

APPROVED <b>LORAIN CO.      MAP DEPT</b>
DATE 4-21-03
PAGE 9-00-09A-B
BY: D. Holland 11001350

1814.70' m. mon.-mon.

WEST ROAD

OBERLIN Reservoir

I.P. Mon. fd. & used

NEED GAS EXTENSION FOR PROPOSED 1 HOUSES