


7-00-084-A

18169

7-00-084-101

WILLIAM B. BARTON
By *Paul Frances*
100 PARKWOOD AVENUE
AVON LAKE, OHIO 44012
TELEPHONE (216) 933-6662

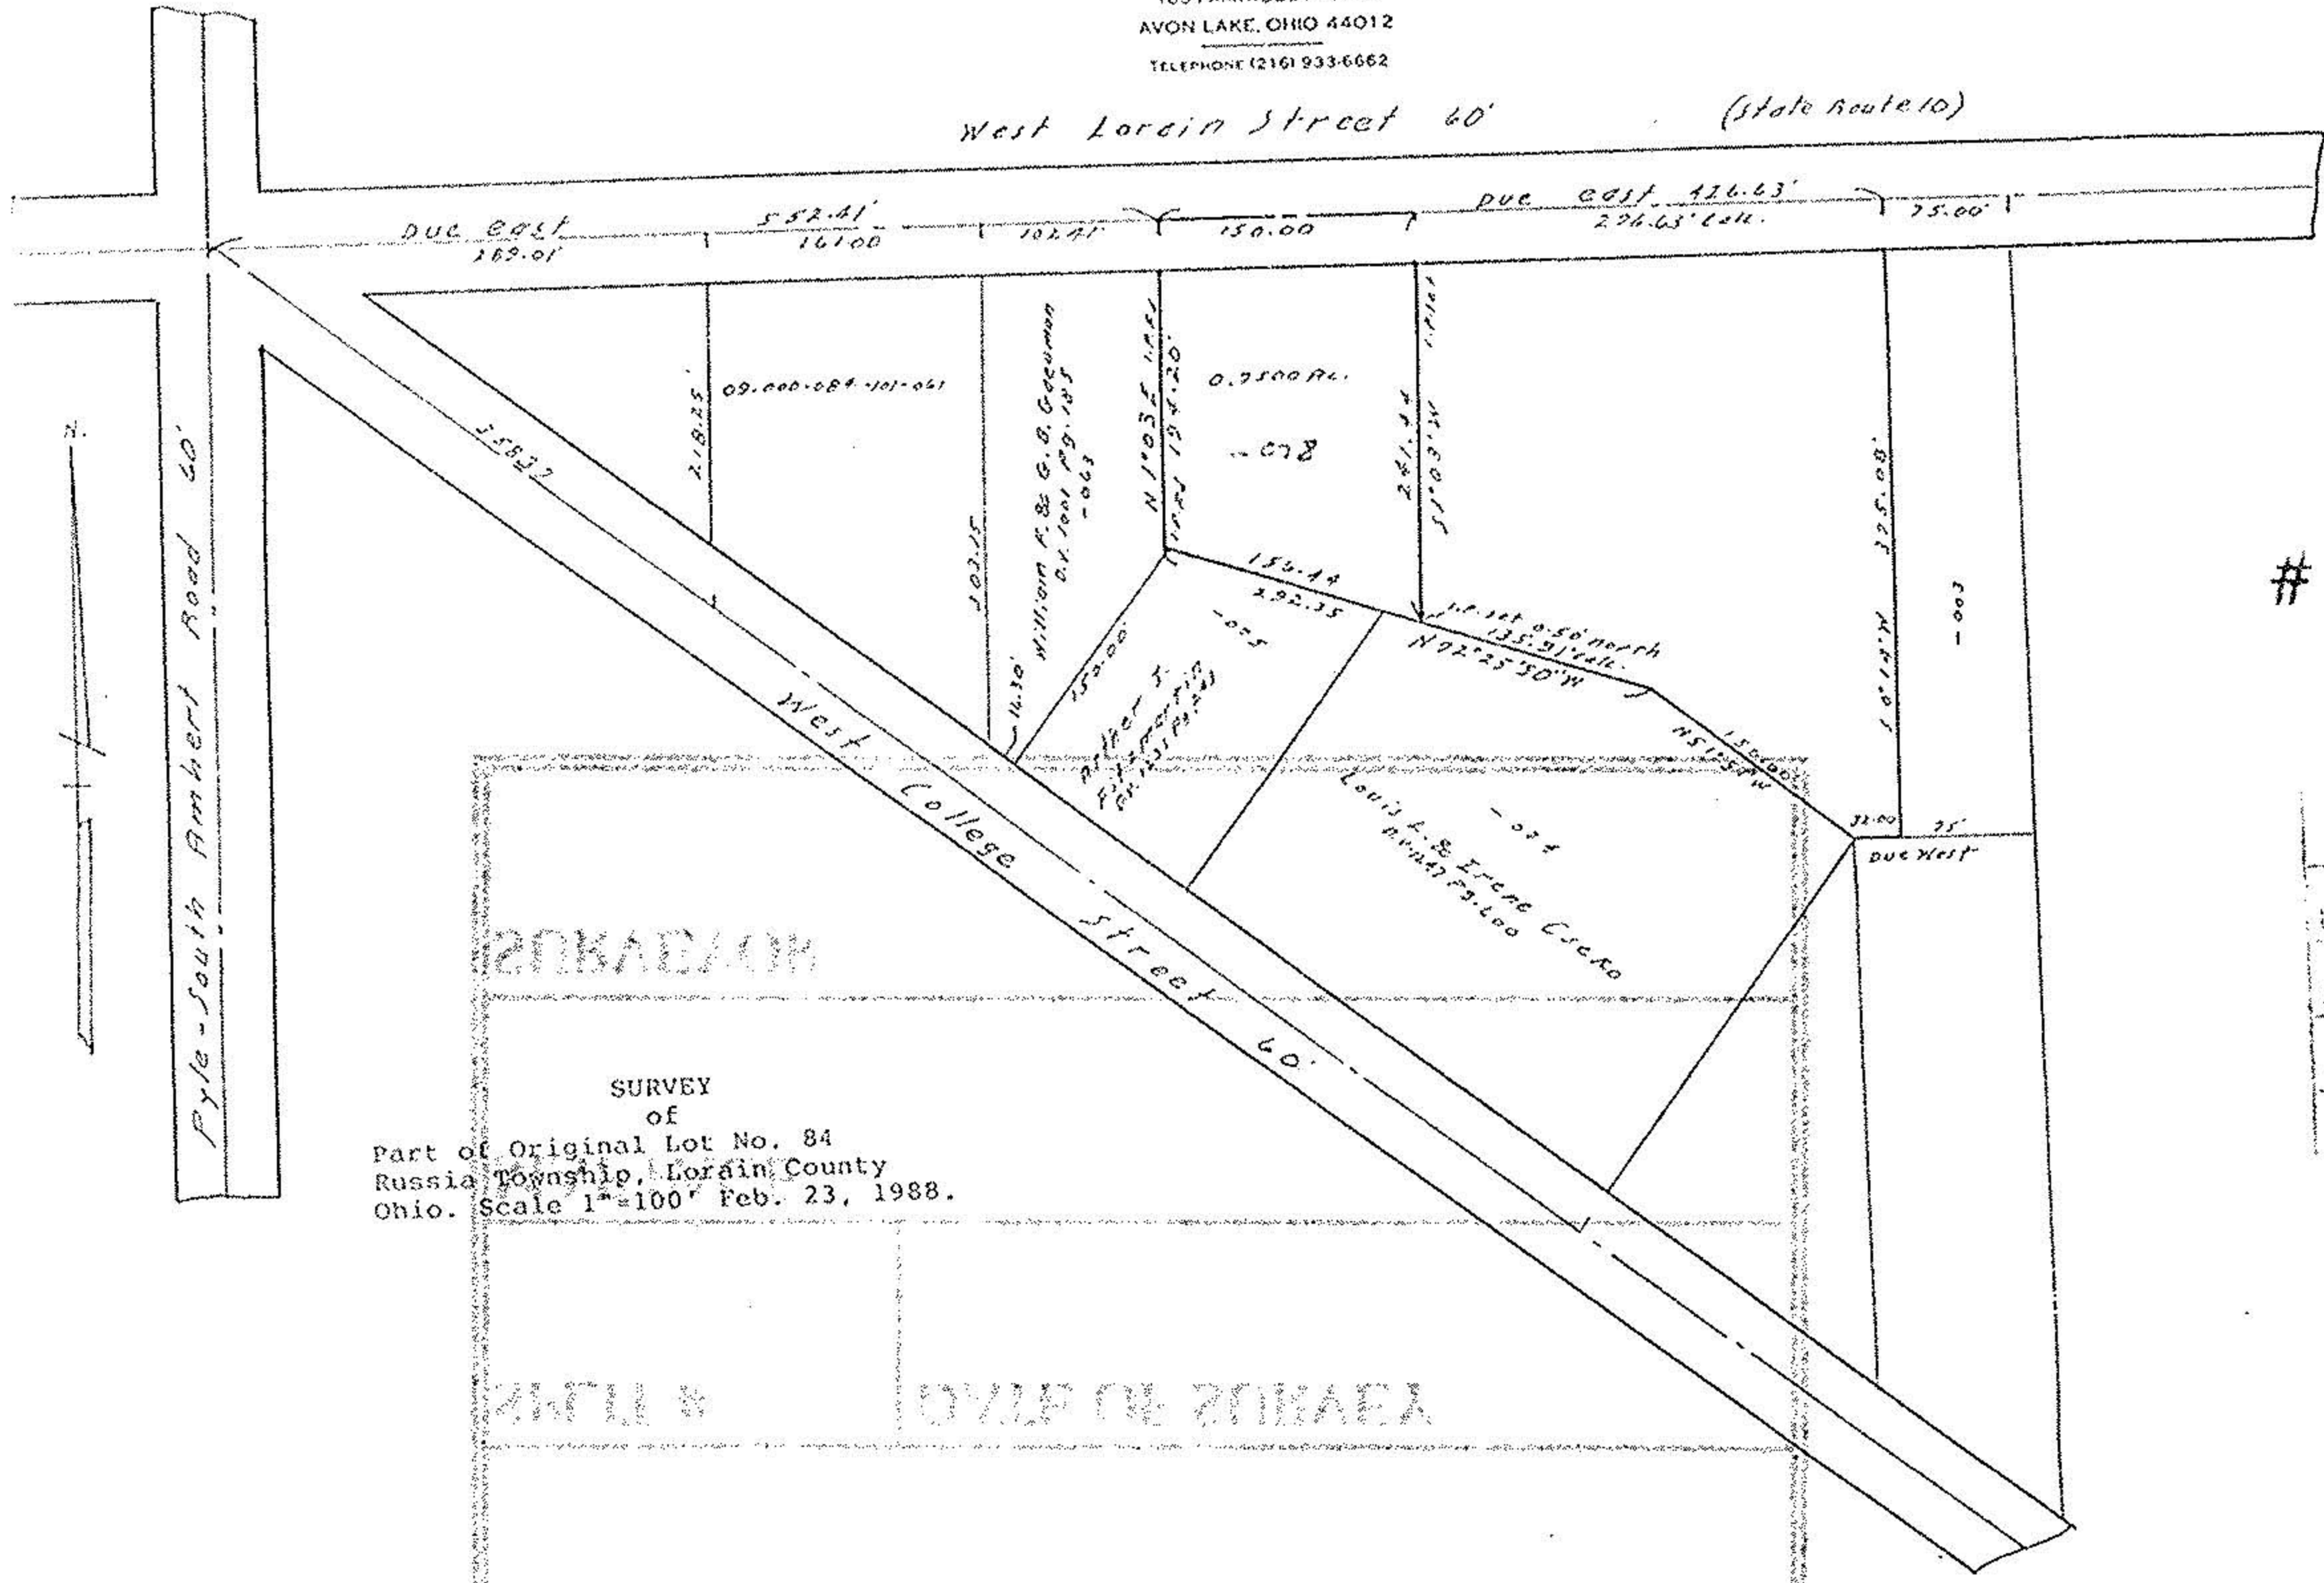

18169

APPROVED
ORAIN CO.
MAP DEPT.

DATE 10-11-88

PAGE 9-00-084A

BY *Paul Frances*

VOID AFTER # 18169

SURVEY
of
Part of Original Lot No. 84
Russia Township, Lorain County
Ohio. Scale 1"=100' Feb. 23, 1988.

