



9-00-097-A 19909 09-00-097-000



LAUNDON • SIMON • CAHL & ASSOC., INC.
CONSULTING ENGINEERS & SURVEYORS
110 MIDDLE AVE., ELYRIA, O. 44035

SURVEY FOR
JAKE JONES

Orig. Lot 97	City of	Date 2-25-92	Scale 1"=50'
Orig. Sec	Village of	Dwn. by RC	Chkd. by RS
Tract	County of LORAIN	Job No. 92-2157	F.B. 223-2
Township of RUSSIA	State of OHIO	APR 13 1992	

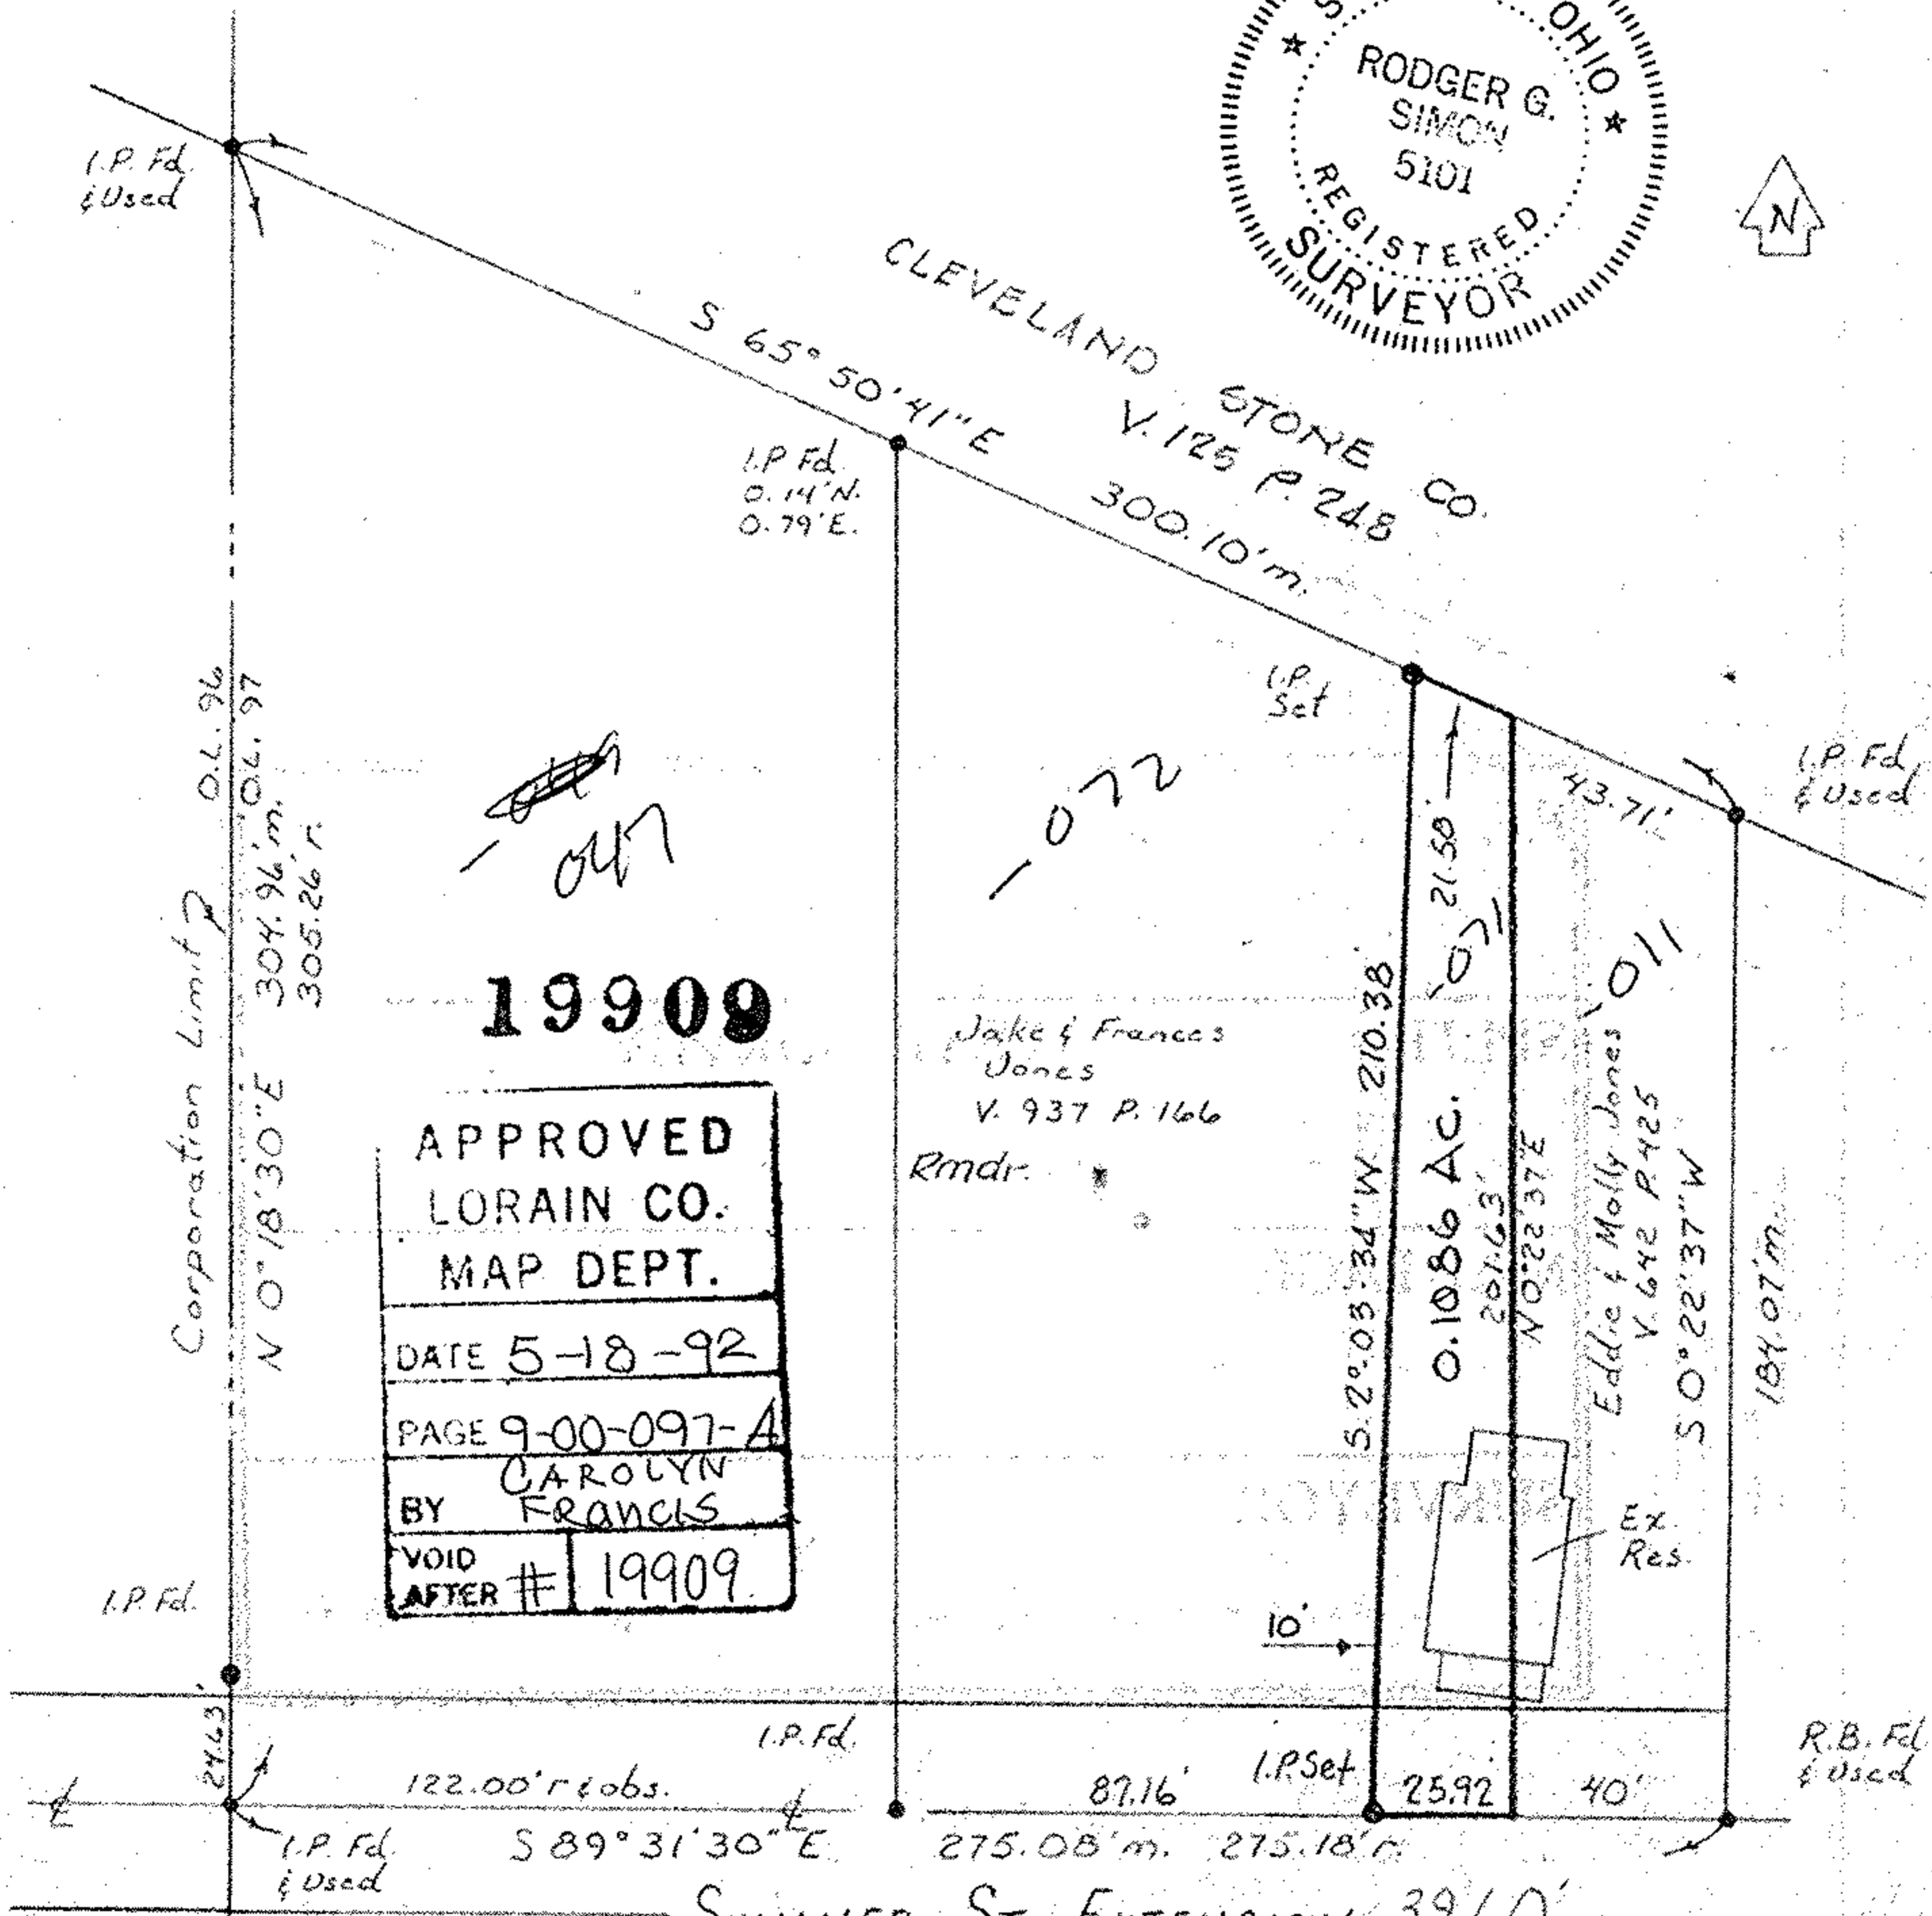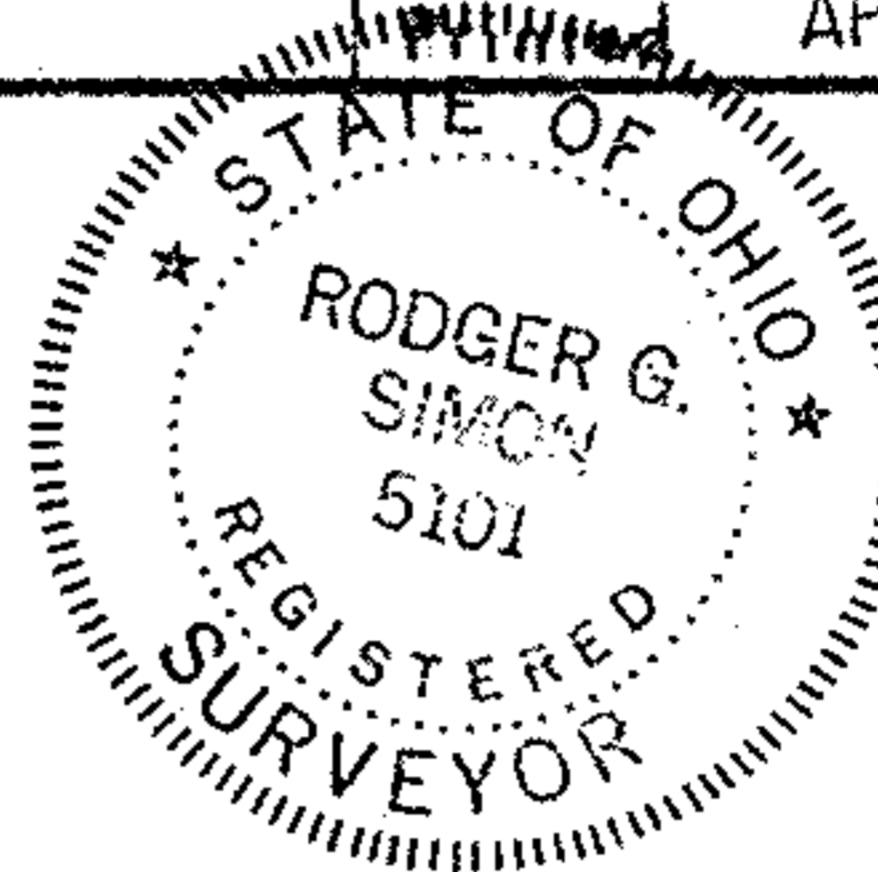

19909

APPROVED
LORAIN CO.
MAP DEPT.

DATE 5-18-92
PAGE 9-00-097-A
BY CAROLYN FRANCIS
VOID AFTER # 19909