


9-00-096-A

20363 09-00-096-110-

MAP OF SURVEY FOR AMBILT CORP.
CITY OF OBERLIN - RUSSIA TWP. - O.L. #96
APRIL 1993 SCALE 1"=50'
JOHN R. HAMILTON - REG. SURVEYOR #6861

NORTH
SCALE 1"=50'

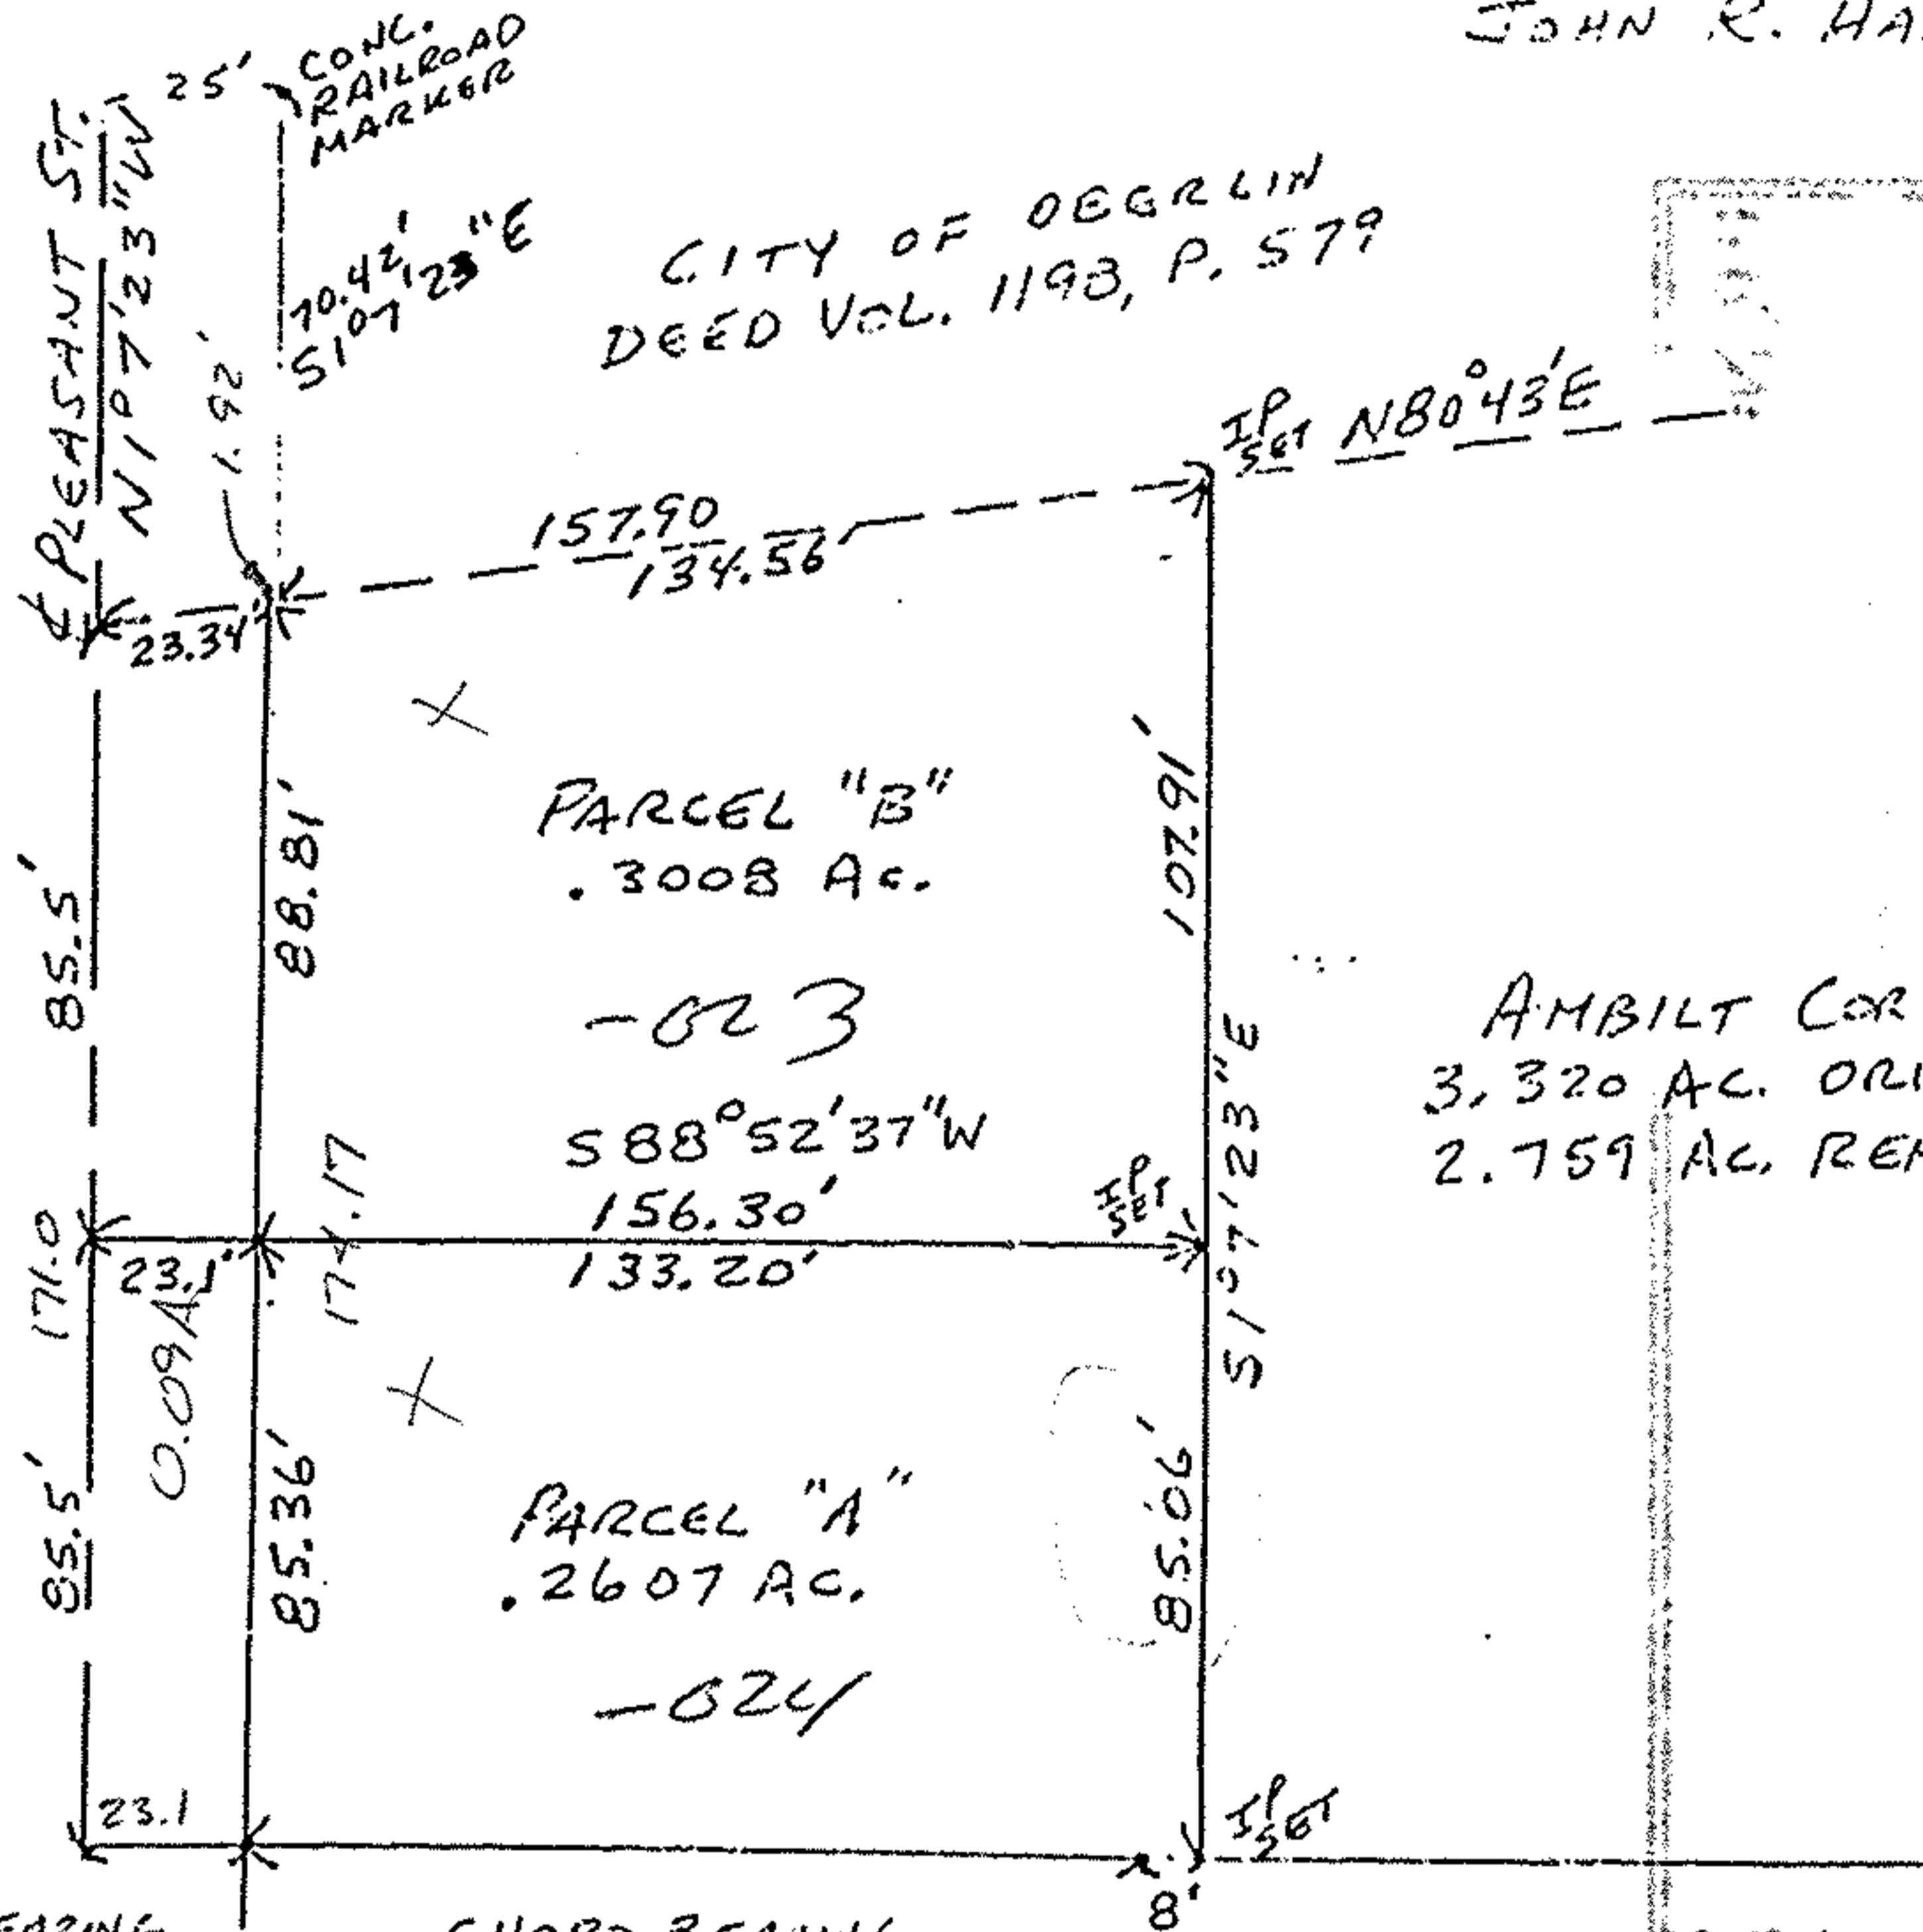

CHORD BEARING
S 88° 32' 21" W
L = 23.1'
D = 0° 20'

CHORD BEARING
S 88° 47' 14" W
L = 125.20'
Δ = 0° 25' 2"
D = 0° 20'

CHORD BEARING S 88° 9' 38" W
LENGTH = 8.00'
Δ = 0° 1' 12"
D = 0° 15'

A.H. CLARK
DEED VOL. 1160, P. 945

20363

APPROVED
LORAIN CO.
MAP DEPT.

DATE 6-30-93

PAGE 9-00-096-A

BY CAROLYN FRANCIS

VOID NUMBER OF 20363

STATE OF OHIO

JOHN R. HAMILTON
6861
REGISTERED PROFESSIONAL SURVEYOR