
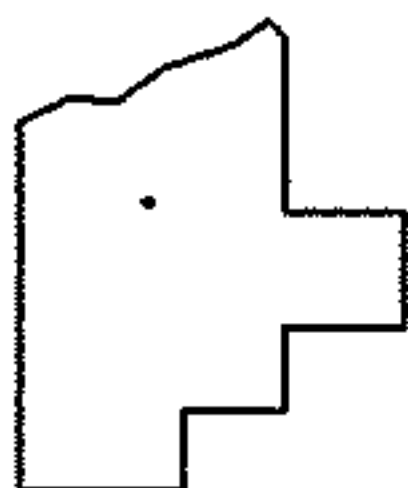
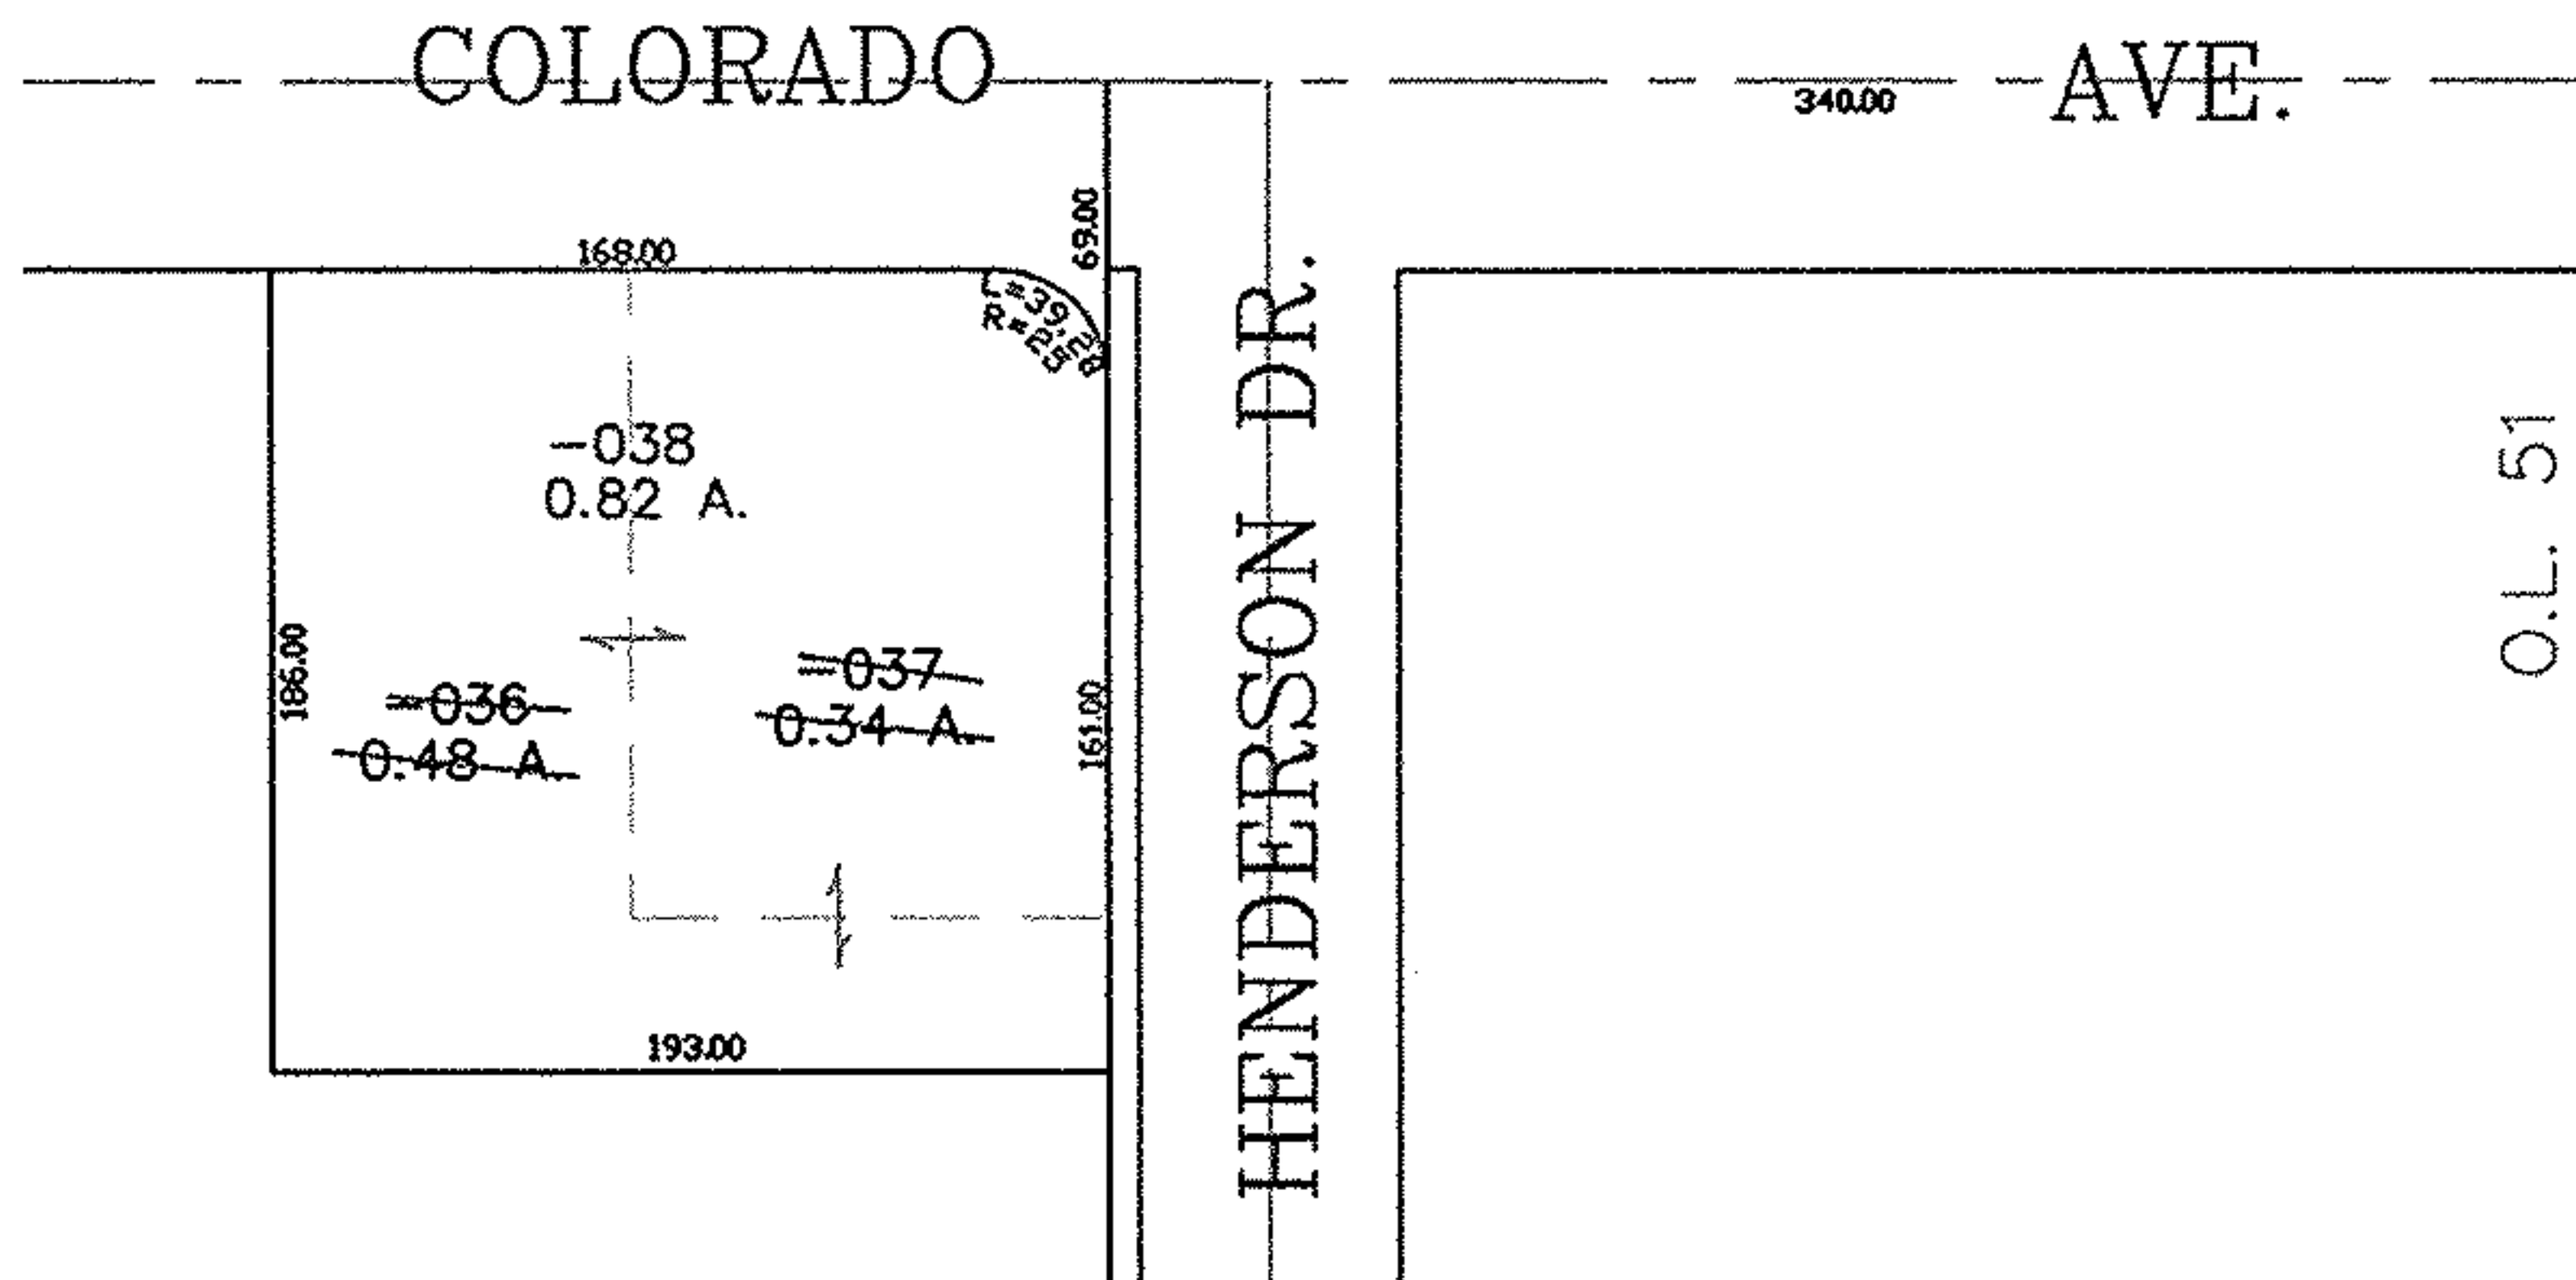


PARENT PARCEL: 02-00-051-142-028, -029

CHILD PARCEL: 02-00-051-142-038

STARTING POINT: CENTERLINE OF COLORADO AVE. & O.L. 51

NO. 01752

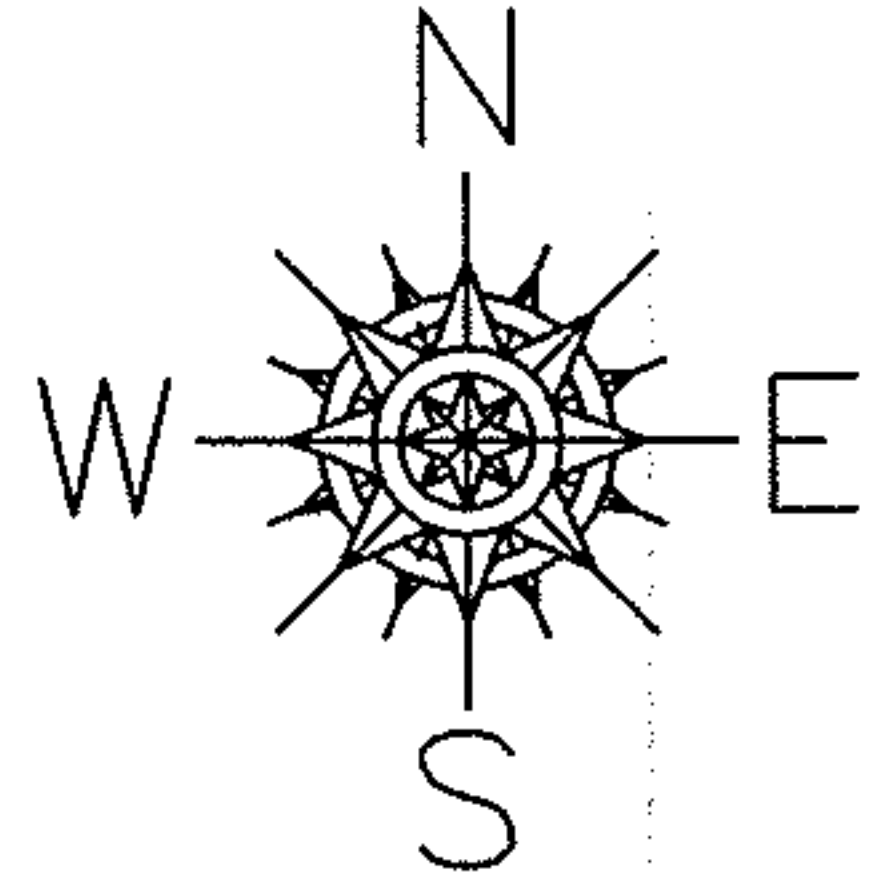

SPLITS/DEEDS PROCESSED

LORAIN COUNTY TAX MAP DEPARTMENT
226 MIDDLE AVE. ELYRIA, OHIO

SURVEYED BY: PATRICK A. MCGANNON

CLOSURE: 0.00 : 10.000

MAP PAGE(S): 02-00-051-B

APPROVED BY: JAH DATE: 9-2-04

SCALE: 1" = 100 PRIOR INSTRUMENT: 20010763601