
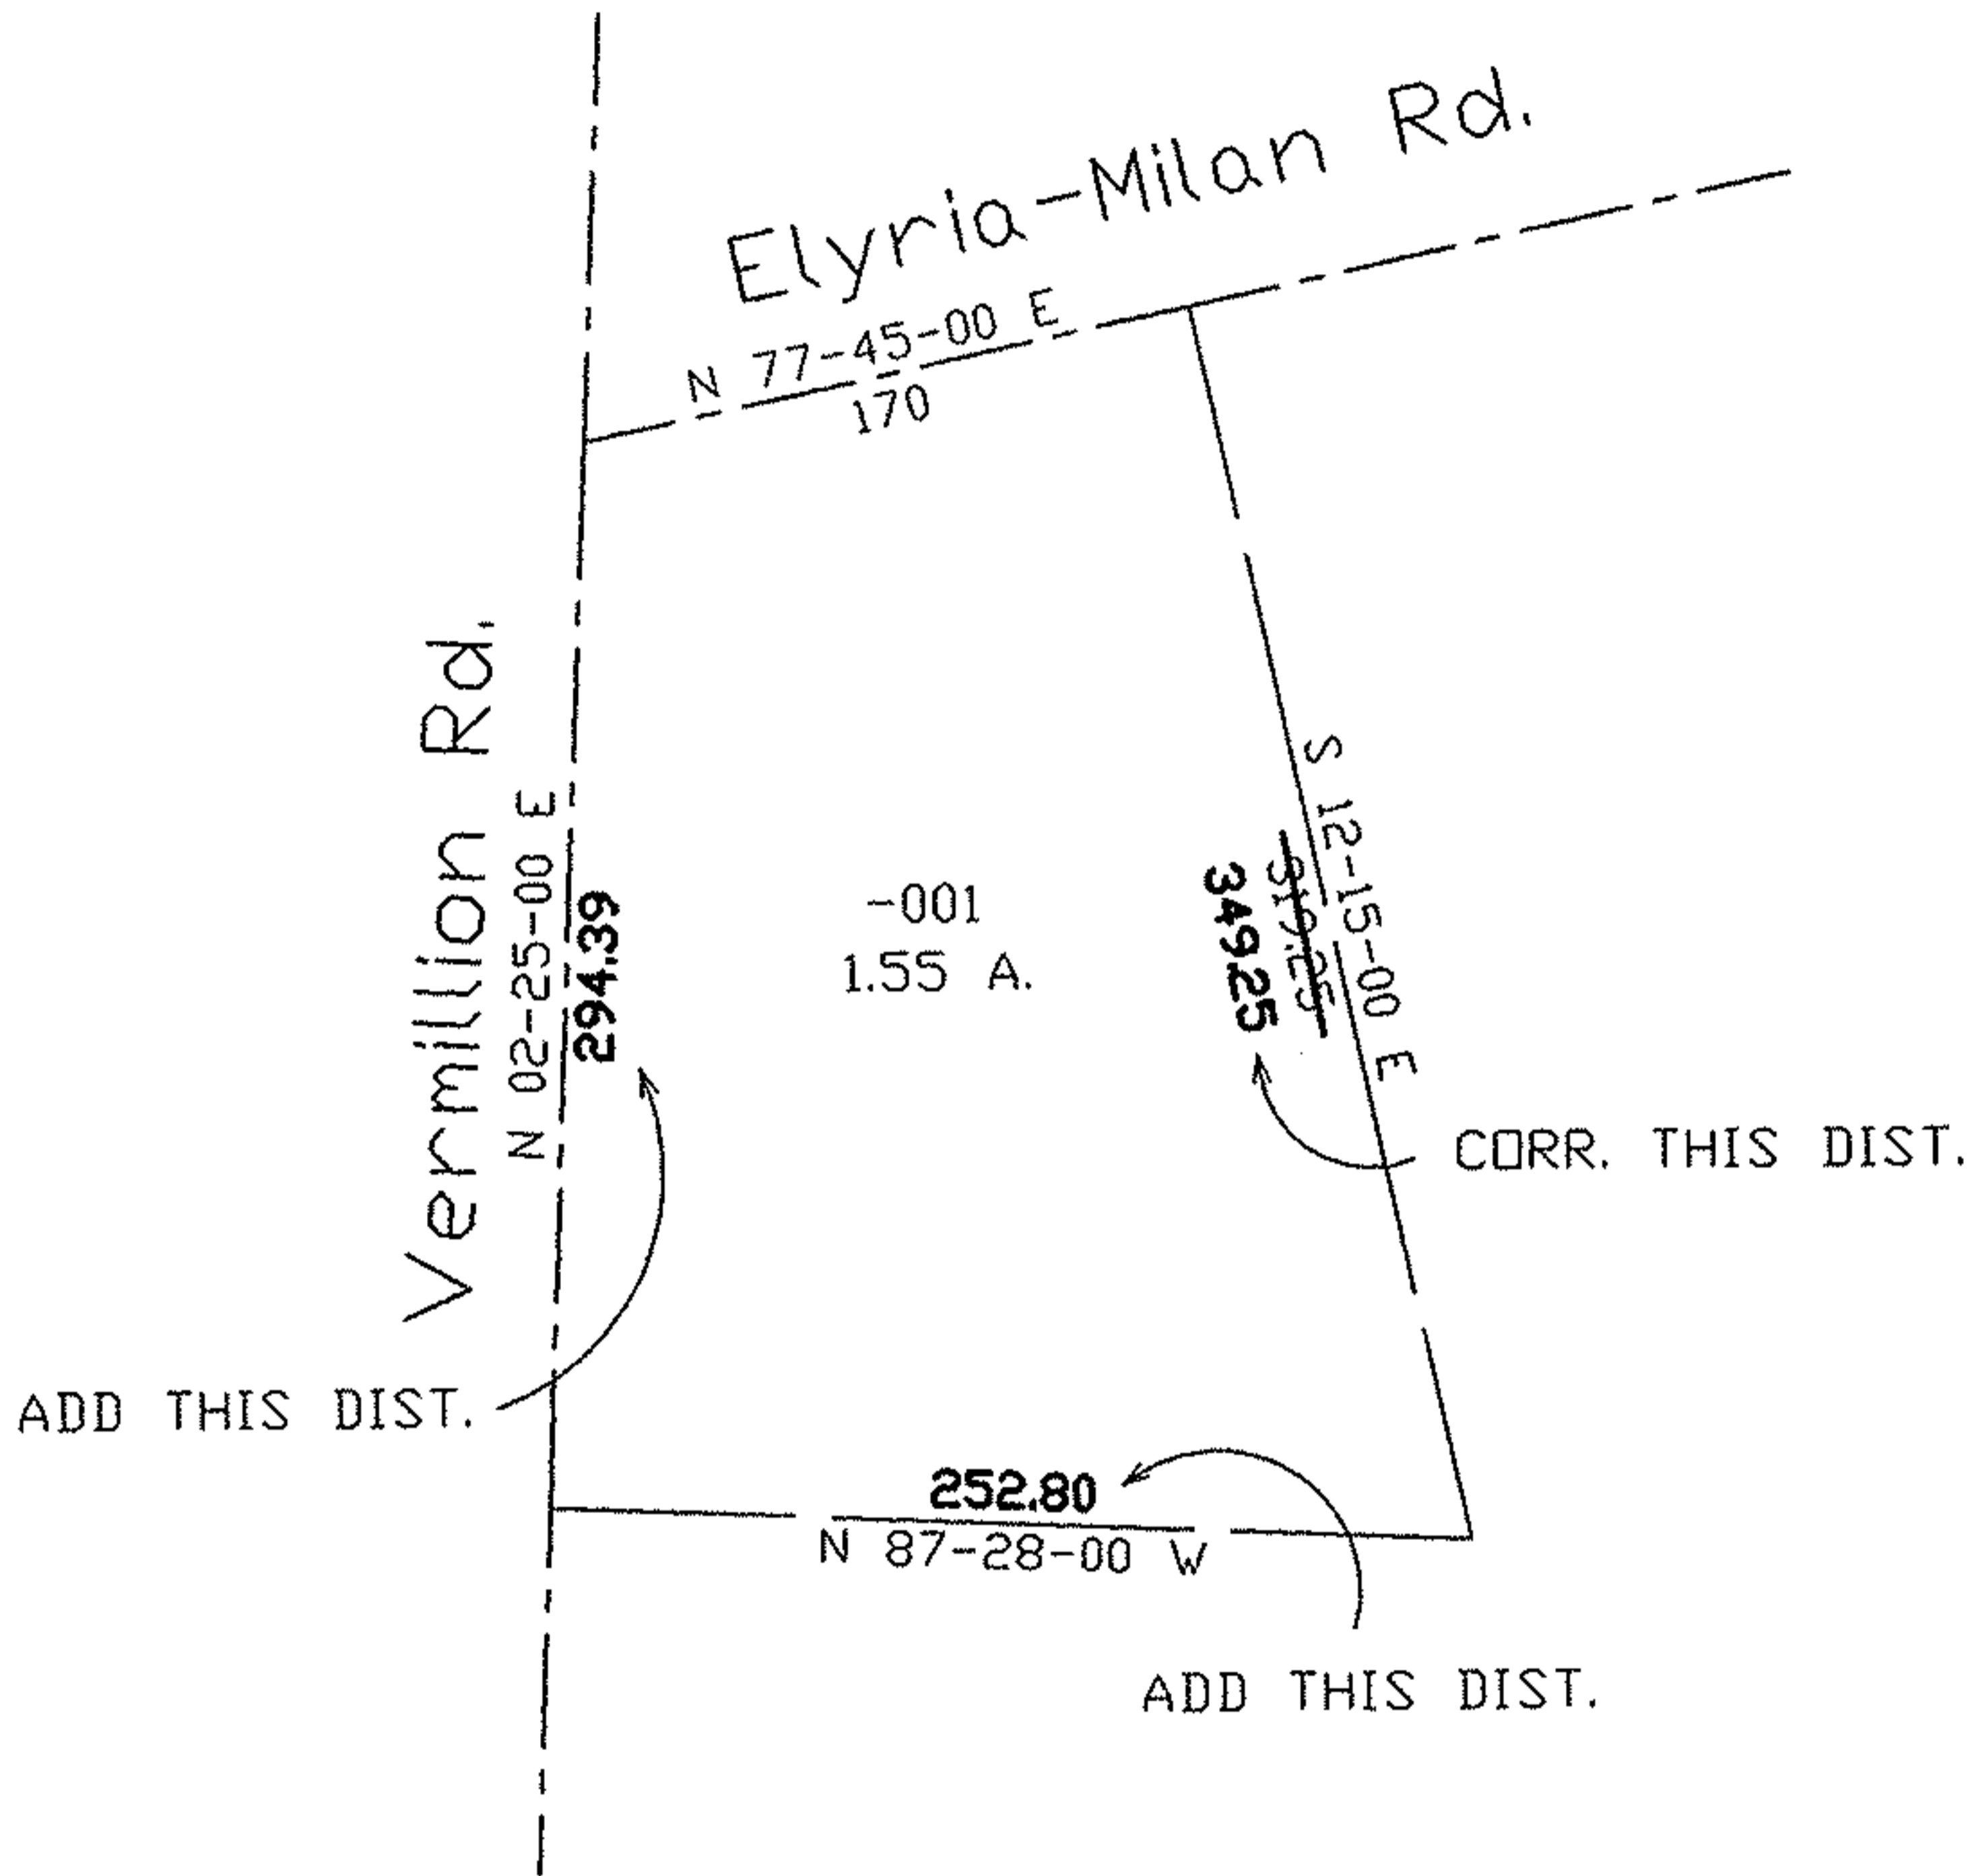


PARENT PARCEL: 08-00-092-104-001


NO. 22460-D

CHILD PARCEL:

STARTING POINT: cL of Elyria-Milan Rd. & cL of Vermillion Rd.

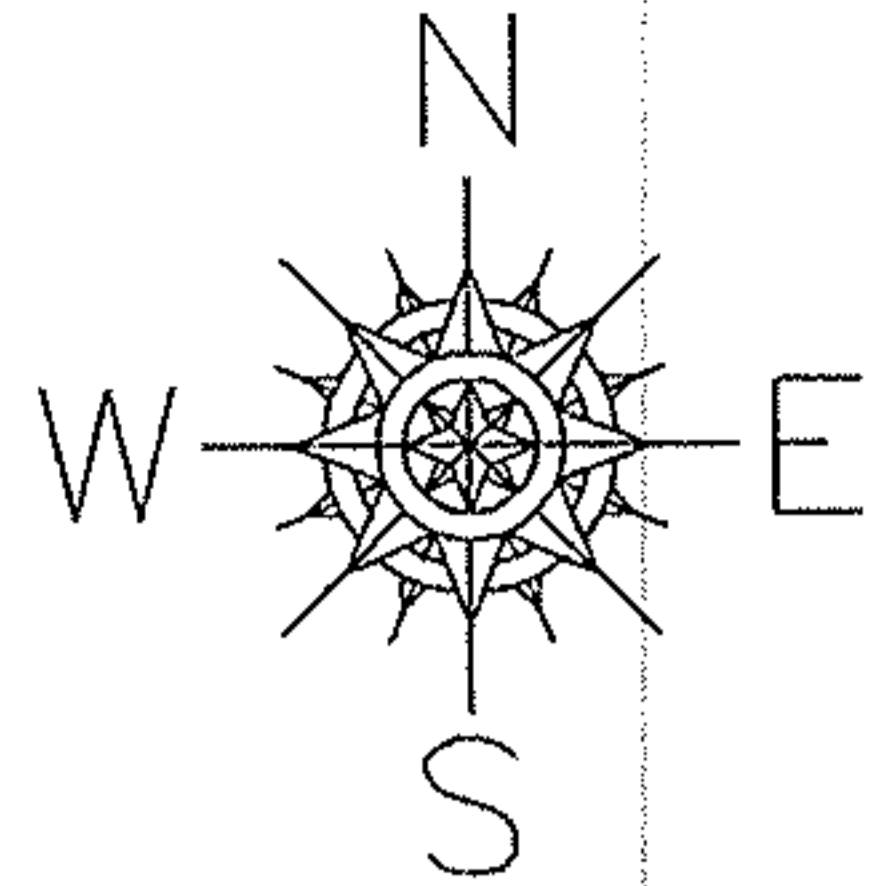

CORR. PER DV 922/188

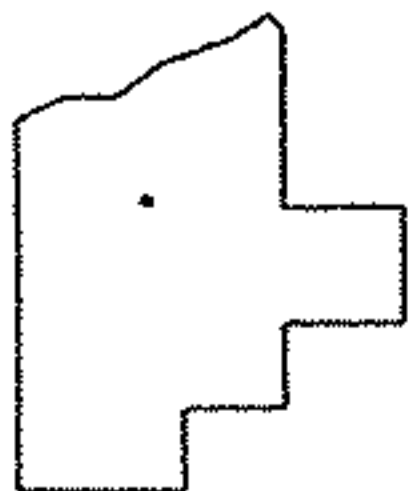

SPLITS/DEEDS PROCESSED
 LORAIN COUNTY TAX MAP DEPARTMENT
 226 MIDDLE AVE. ELYRIA, OHIO

SURVEYED BY: J.W. WARDEN

CLOSURE: 0.11:10.000

MAP PAGE(S): 08-00-092-8

APPROVED BY: koc DATE: 3/12/98

SCALE: 1" = 100 PRIOR INSTRUMENT: DV 922/P.182