

07-00-022-101-078, 079

NO. 00271-D


PARENT PARCEL: 07-00-022-101-078 & -079
CHILD PARCEL: XX-XX-XXX-XXX-XXX
STARTING POINT: LC OF ROOT RD & NORTH LINE OF O.L. 22

MAP CORRECTION ONLY


CORRECTIONS IN RED

07-00-022-101-078

07-00-022-101-079

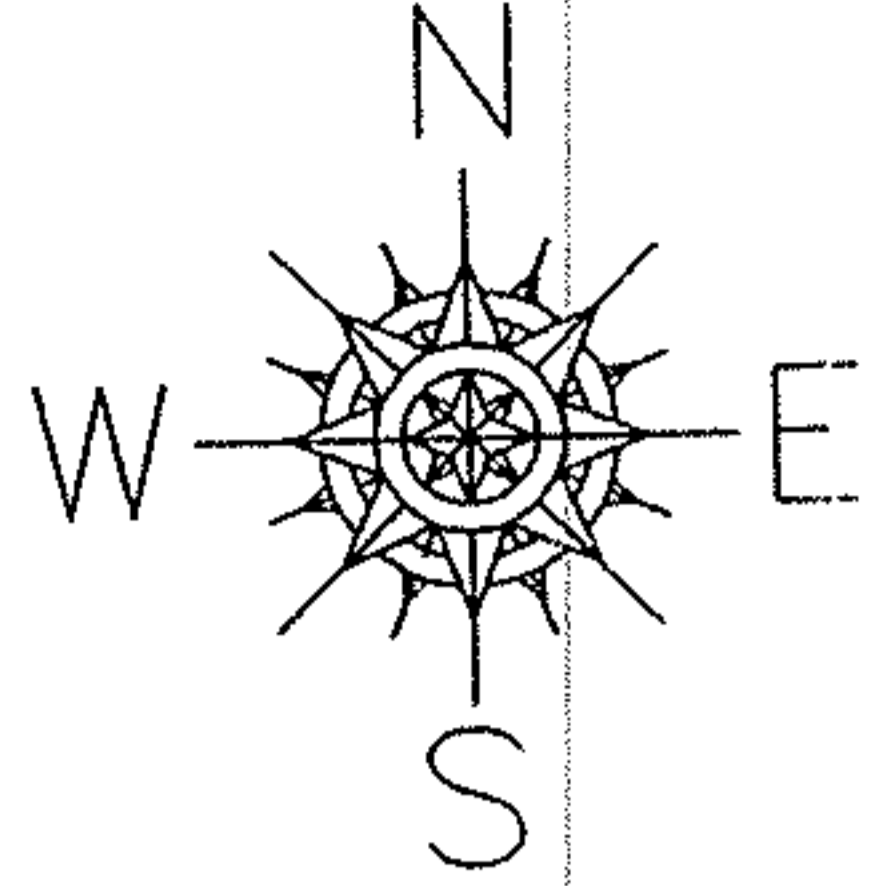

SURVEY & CORRECTED LOCAL RECORD NEXT TO MAP

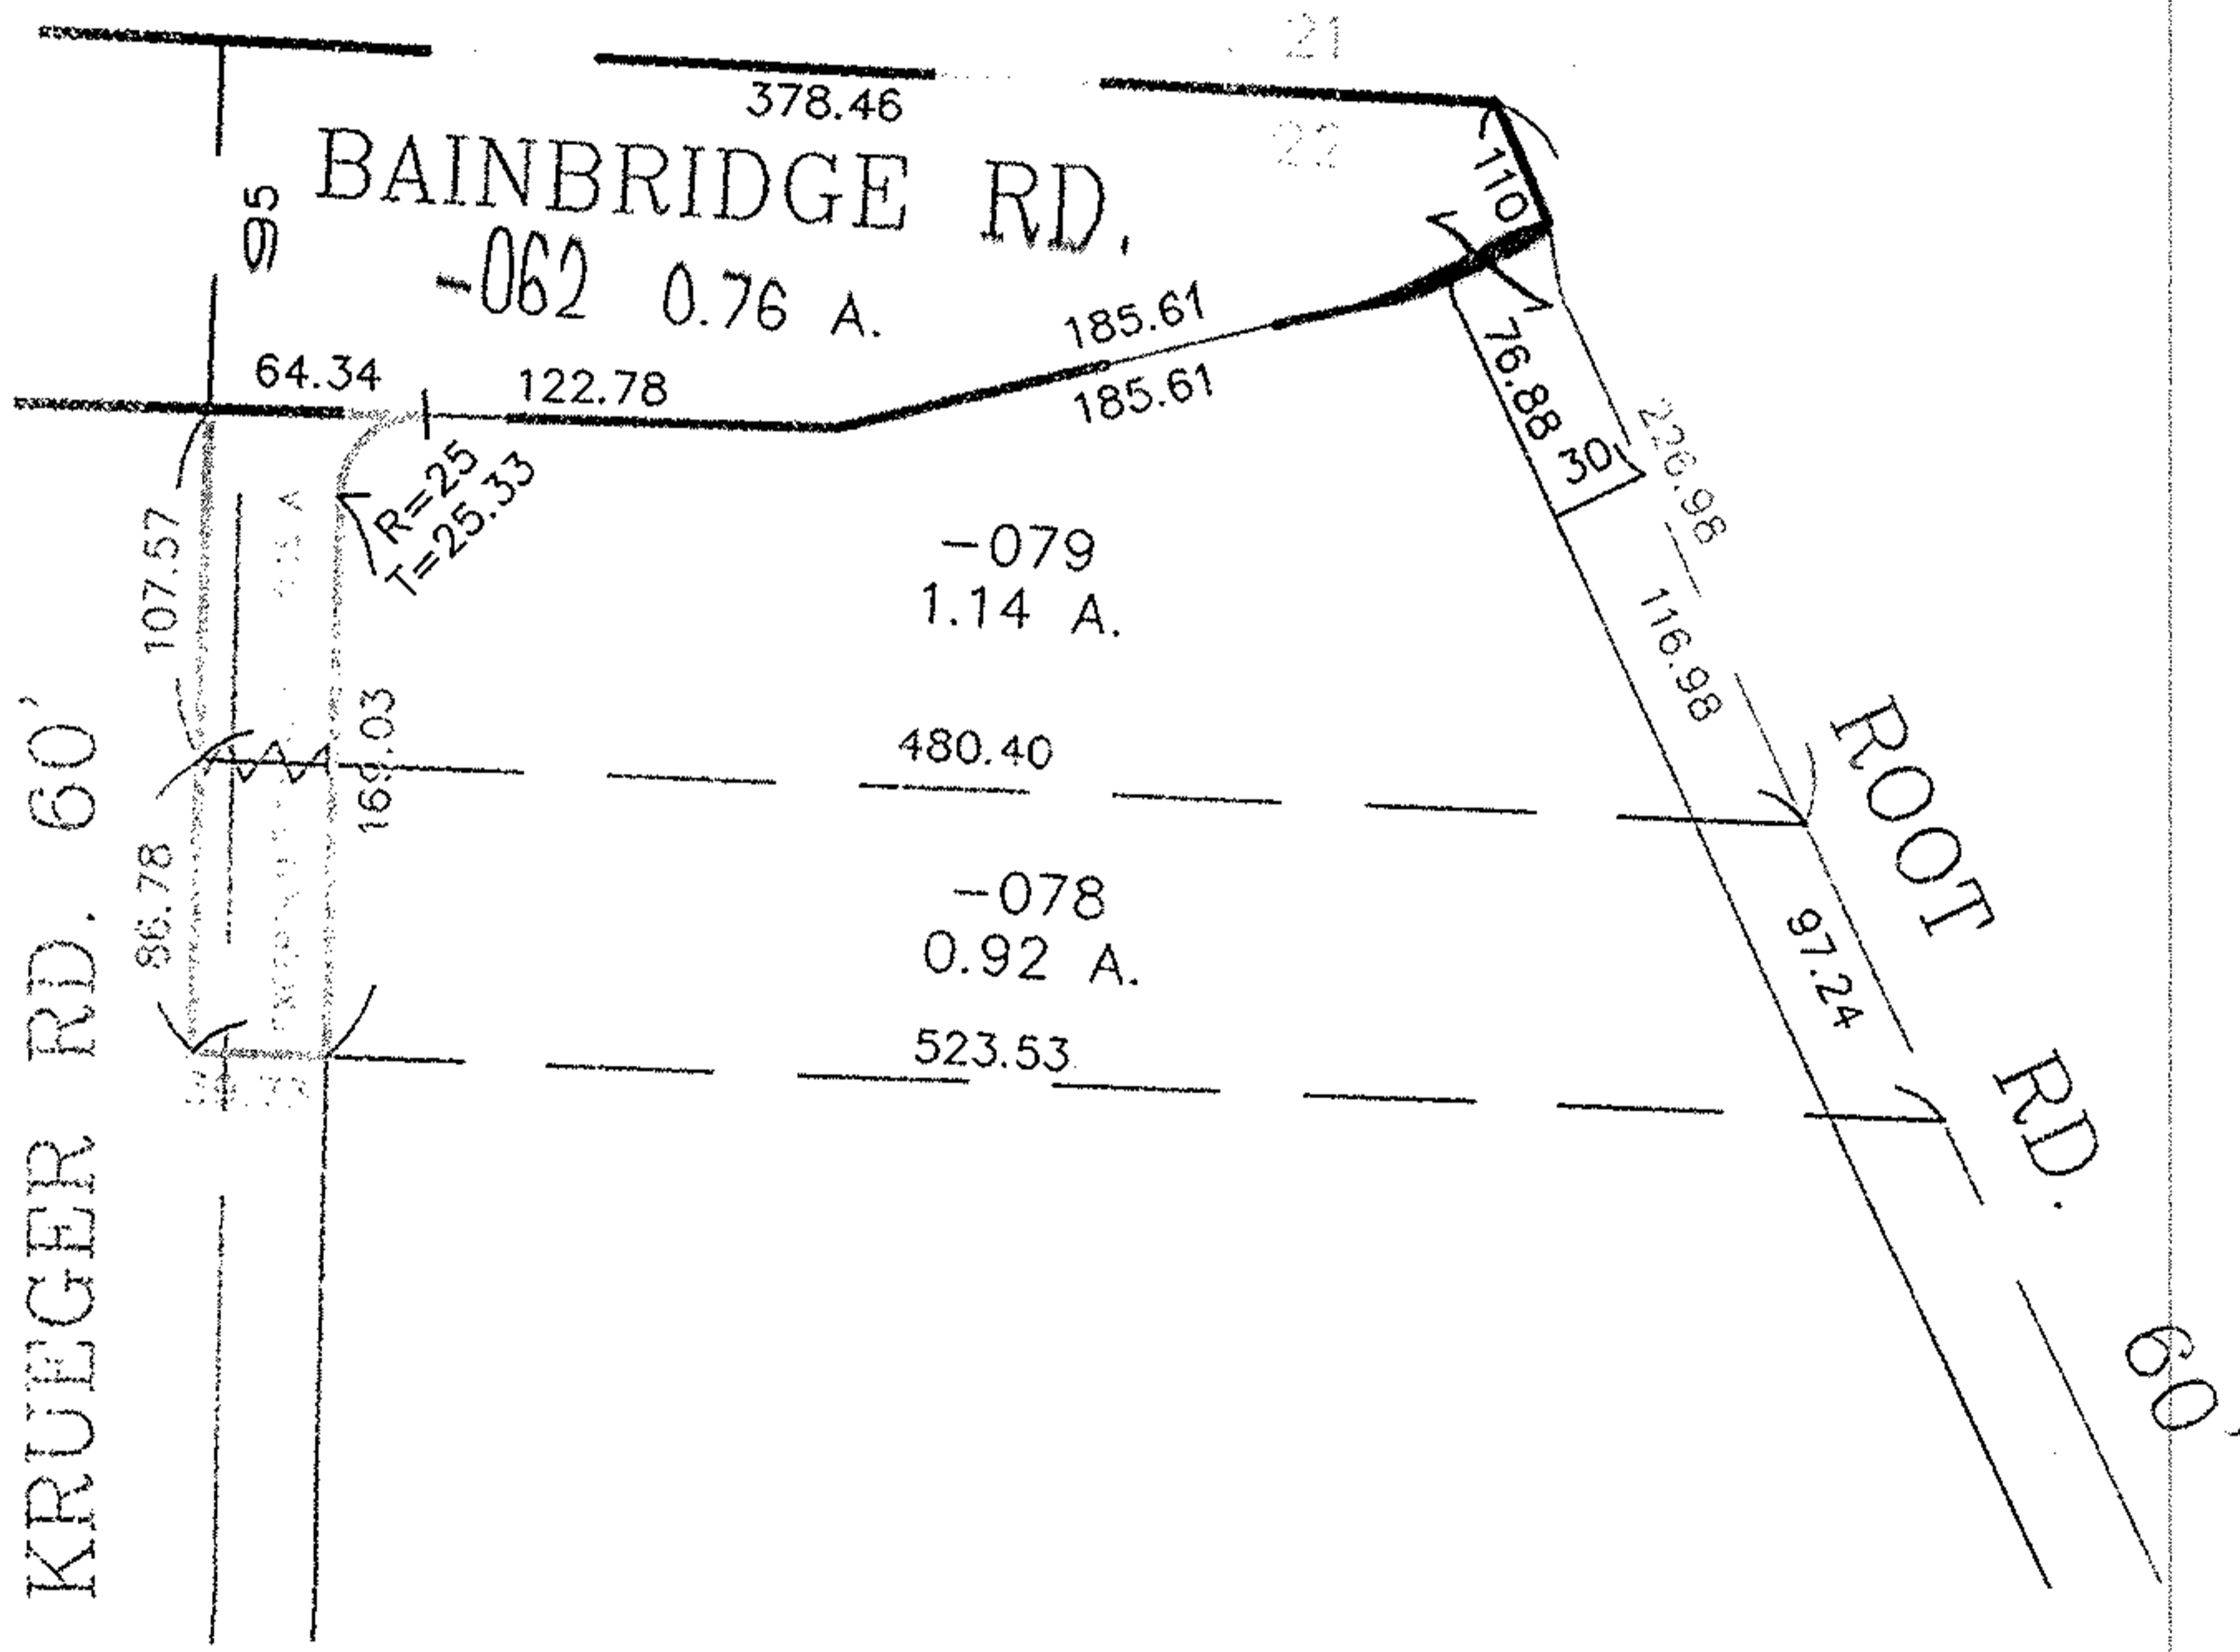

PRIOR INSTRUMENT: DV 1124/766
PRIOR INSTRUMENT: DV 1365/915

SPLITS/DEEDS PROCESSED

LORAIN COUNTY TAX MAP DEPARTMENT
MIDDLETOWN OHIO

SURVEYED BY: NONE
CLOSURE: CAN'T RUN
MAP PAGE(S): 07-00-022-B
APPROVED BY: T. SPILLMAN DATE: 01/28/00
1" = 100'

7-00-022-001-078, 079