

07-00-022-101-078, 079

PARENT PARCEL: 07-00-022-101-078 & -079

CHILD PARCEL: XX-XX-XXX-XXX-XXX

STARTING POINT: LC OF ROOT RD & NORTH LINE OF O.L. 22


NO. 00271-D

MAP CORRECTION ONLY


CORRECTIONS IN RED

07-00-022-101-078

07-00-022-101-079

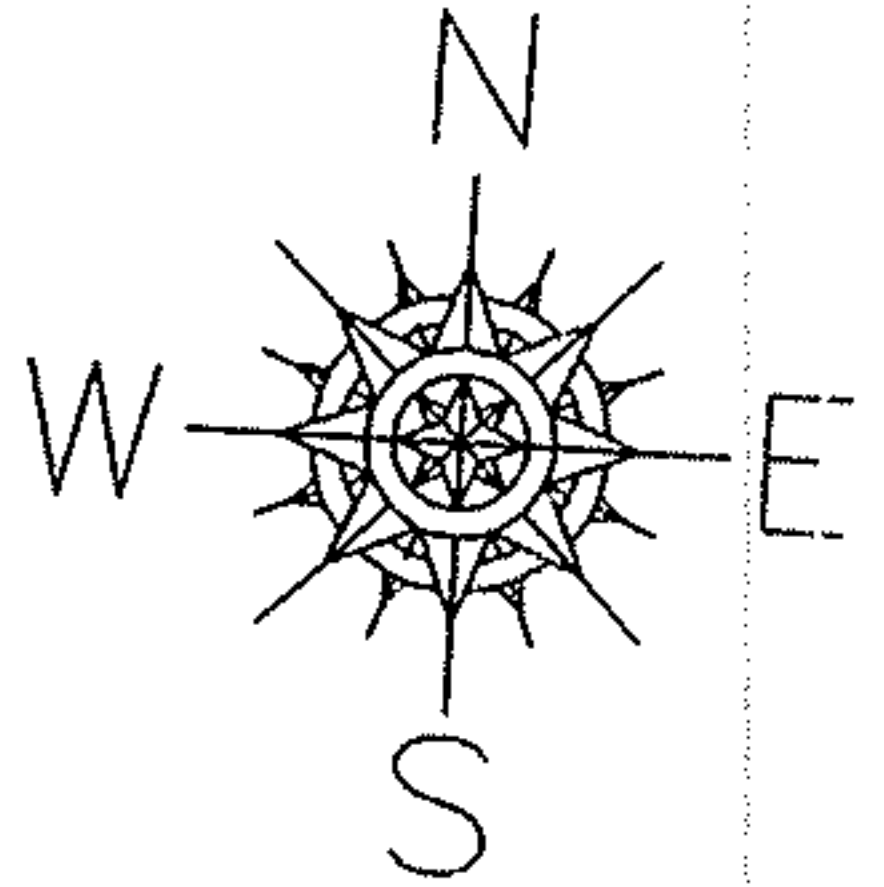

SURVEY ...

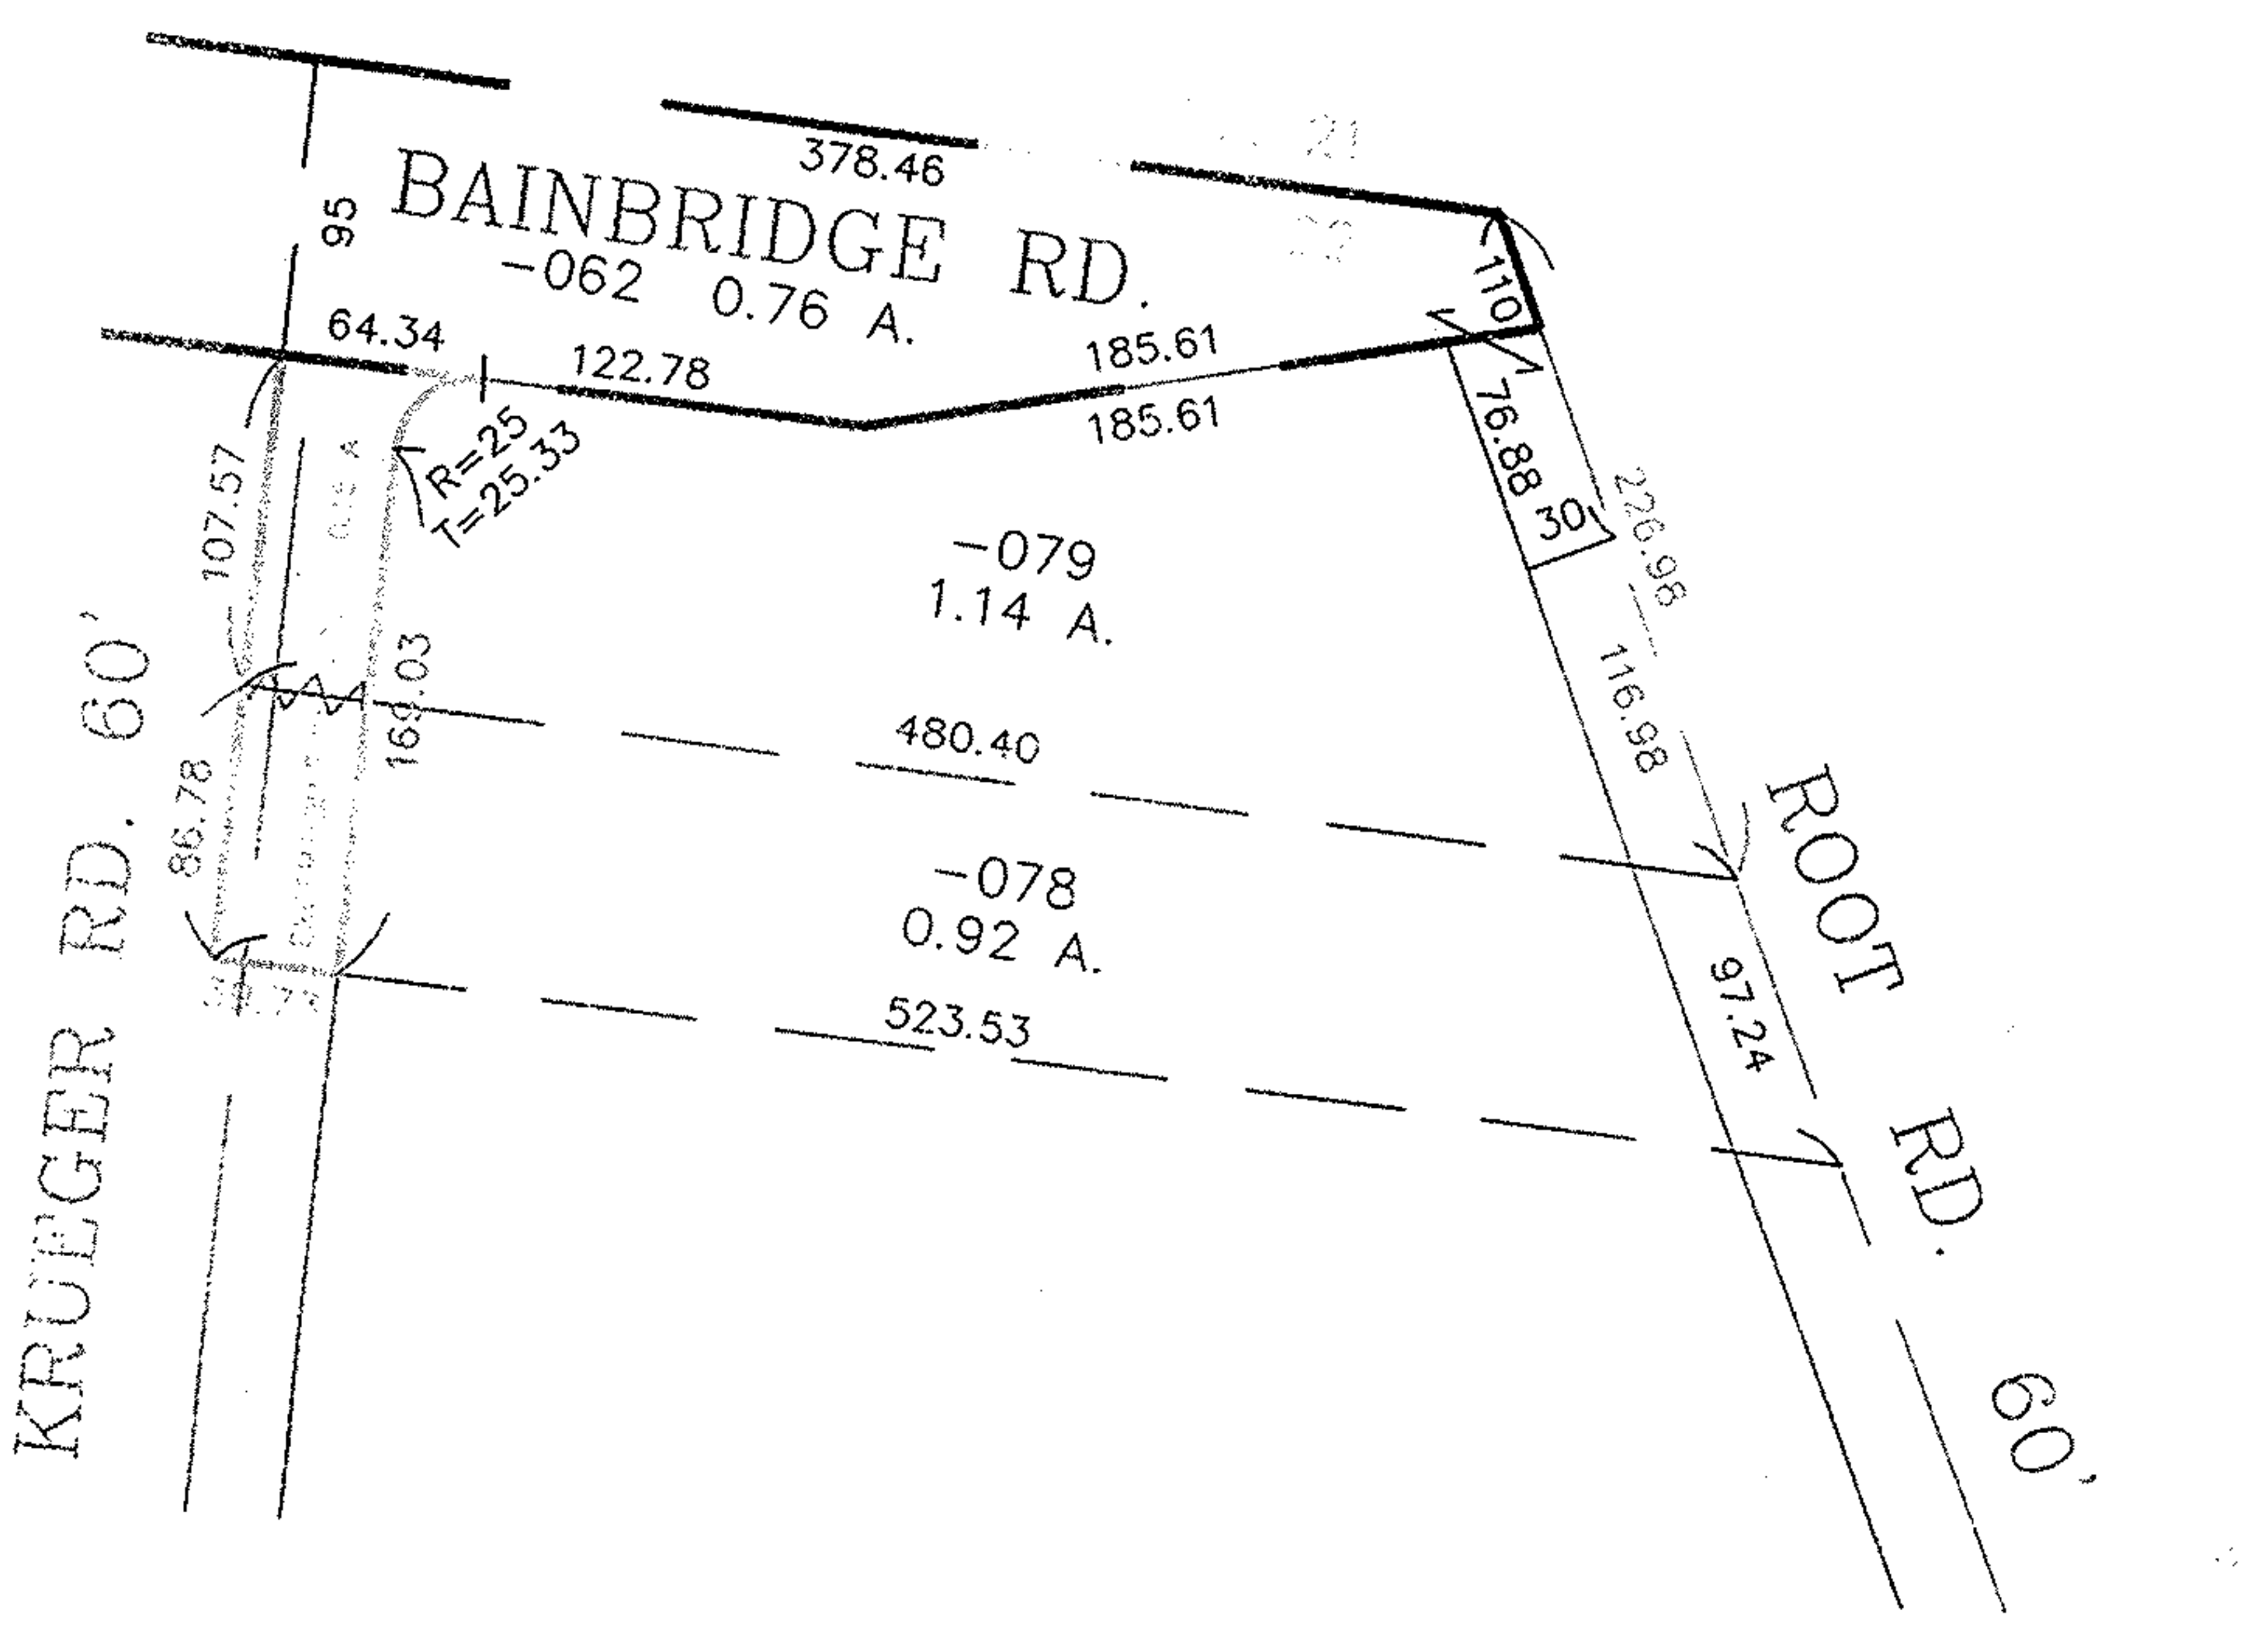

PRIOR INSTRUMENT: DV 1124/766
PRIOR INSTRUMENT: DV 1365/915

SPLITS/DEEDS PROCESSED

SURVEYED BY: NONE
CLOSURE: CAN'T RUN

MAP PAGE(S): 07-00-022-B

LORAIN COUNTY TAX MAP DEPARTMENT

7-00-022-101-078