

01-00-022-101-018, 019

PARENT PARCEL: 07-00-022-101-078 & -079

CHILD PARCEL: XX-XX-XXX-XXX-XXX

STARTING POINT: LC OF ROOT RD & NORTH LINE OF O.L. 22


NO. 00271-D

# MAP CORRECTION ONLY


CORRECTIONS IN RED

07-00-022-101-078

07-00-022-101-079

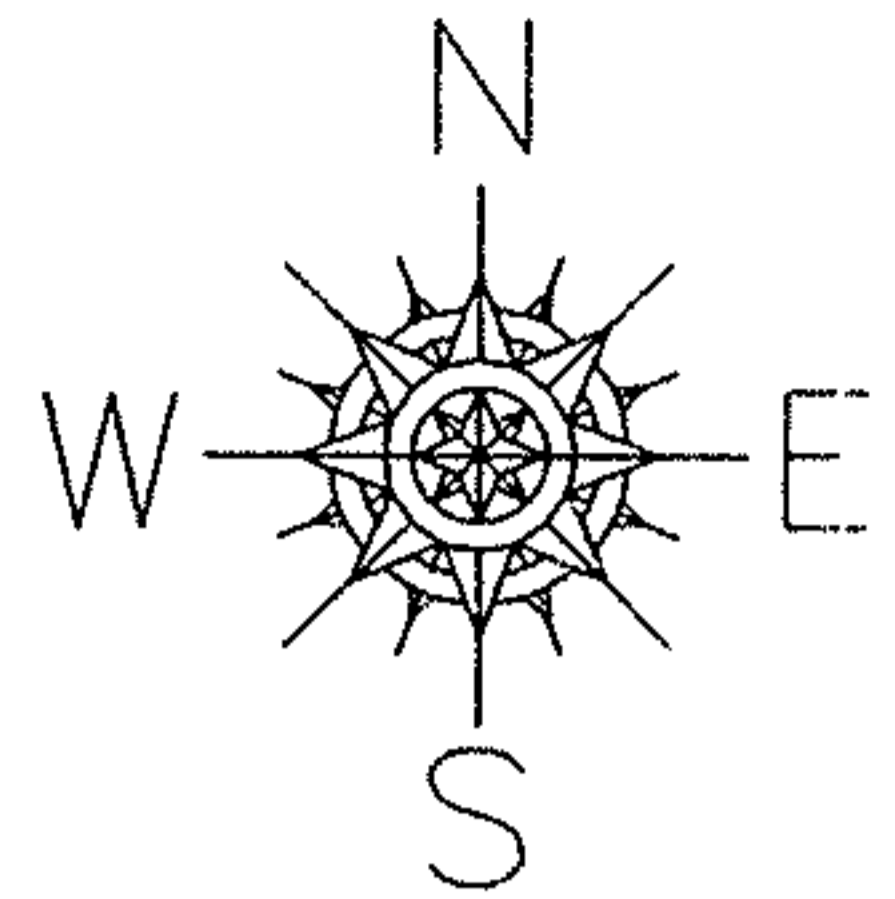

TRAVEL ...

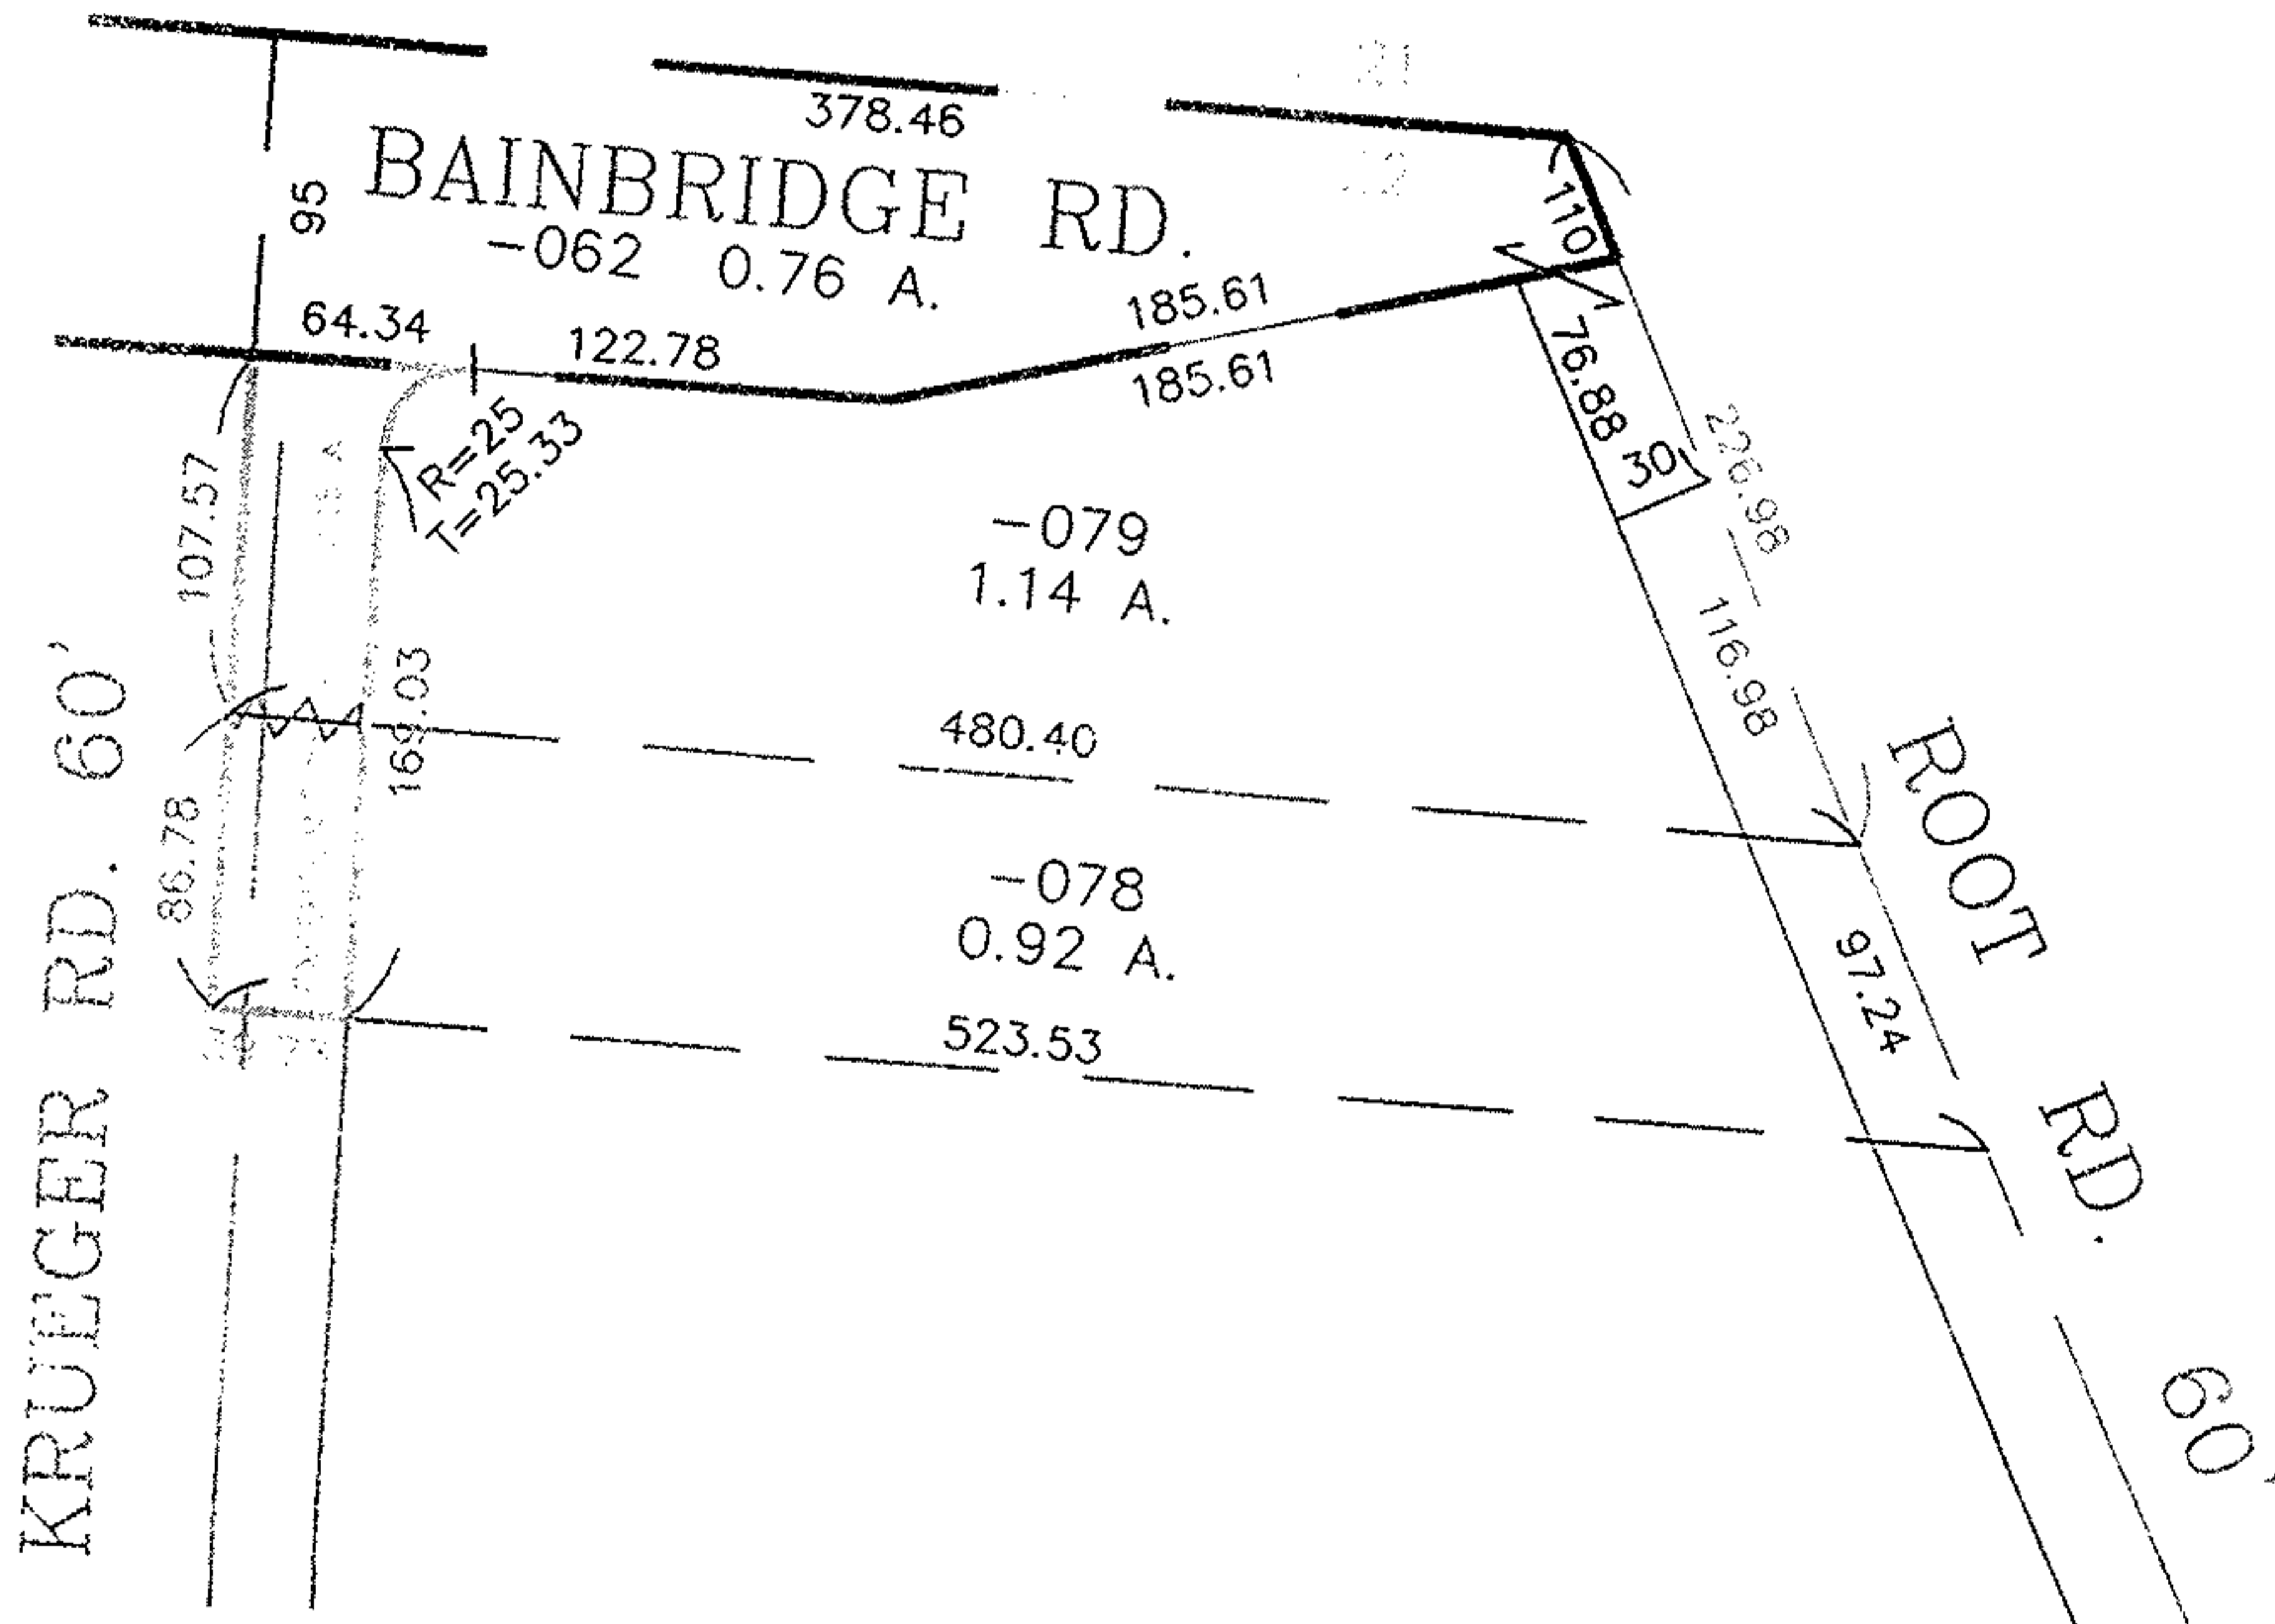

PRIOR INSTRUMENT: DV 1124/766

PRIOR INSTRUMENT: DV 1365/915

## SPLITS/DEEDS PROCESSED

LORAIN COUNTY TAX MAP DEPARTMENT  
226 MIDDLE AVE. ELYRIA, OHIO

SURVEYED BY: NONE

CLOSURE: CAN'T RUN

MAP PAGE(S): 07-00-022-B

APPROVED BY: I. SPILLMAN DATE: 01/28/00

SCALE: 1" = 100

7-00-022-000-078, -079