


7-00-028-A

7-00-028-101

C - 101

Dec. Plat Vol. 23 Pg 4

Schafer Drive

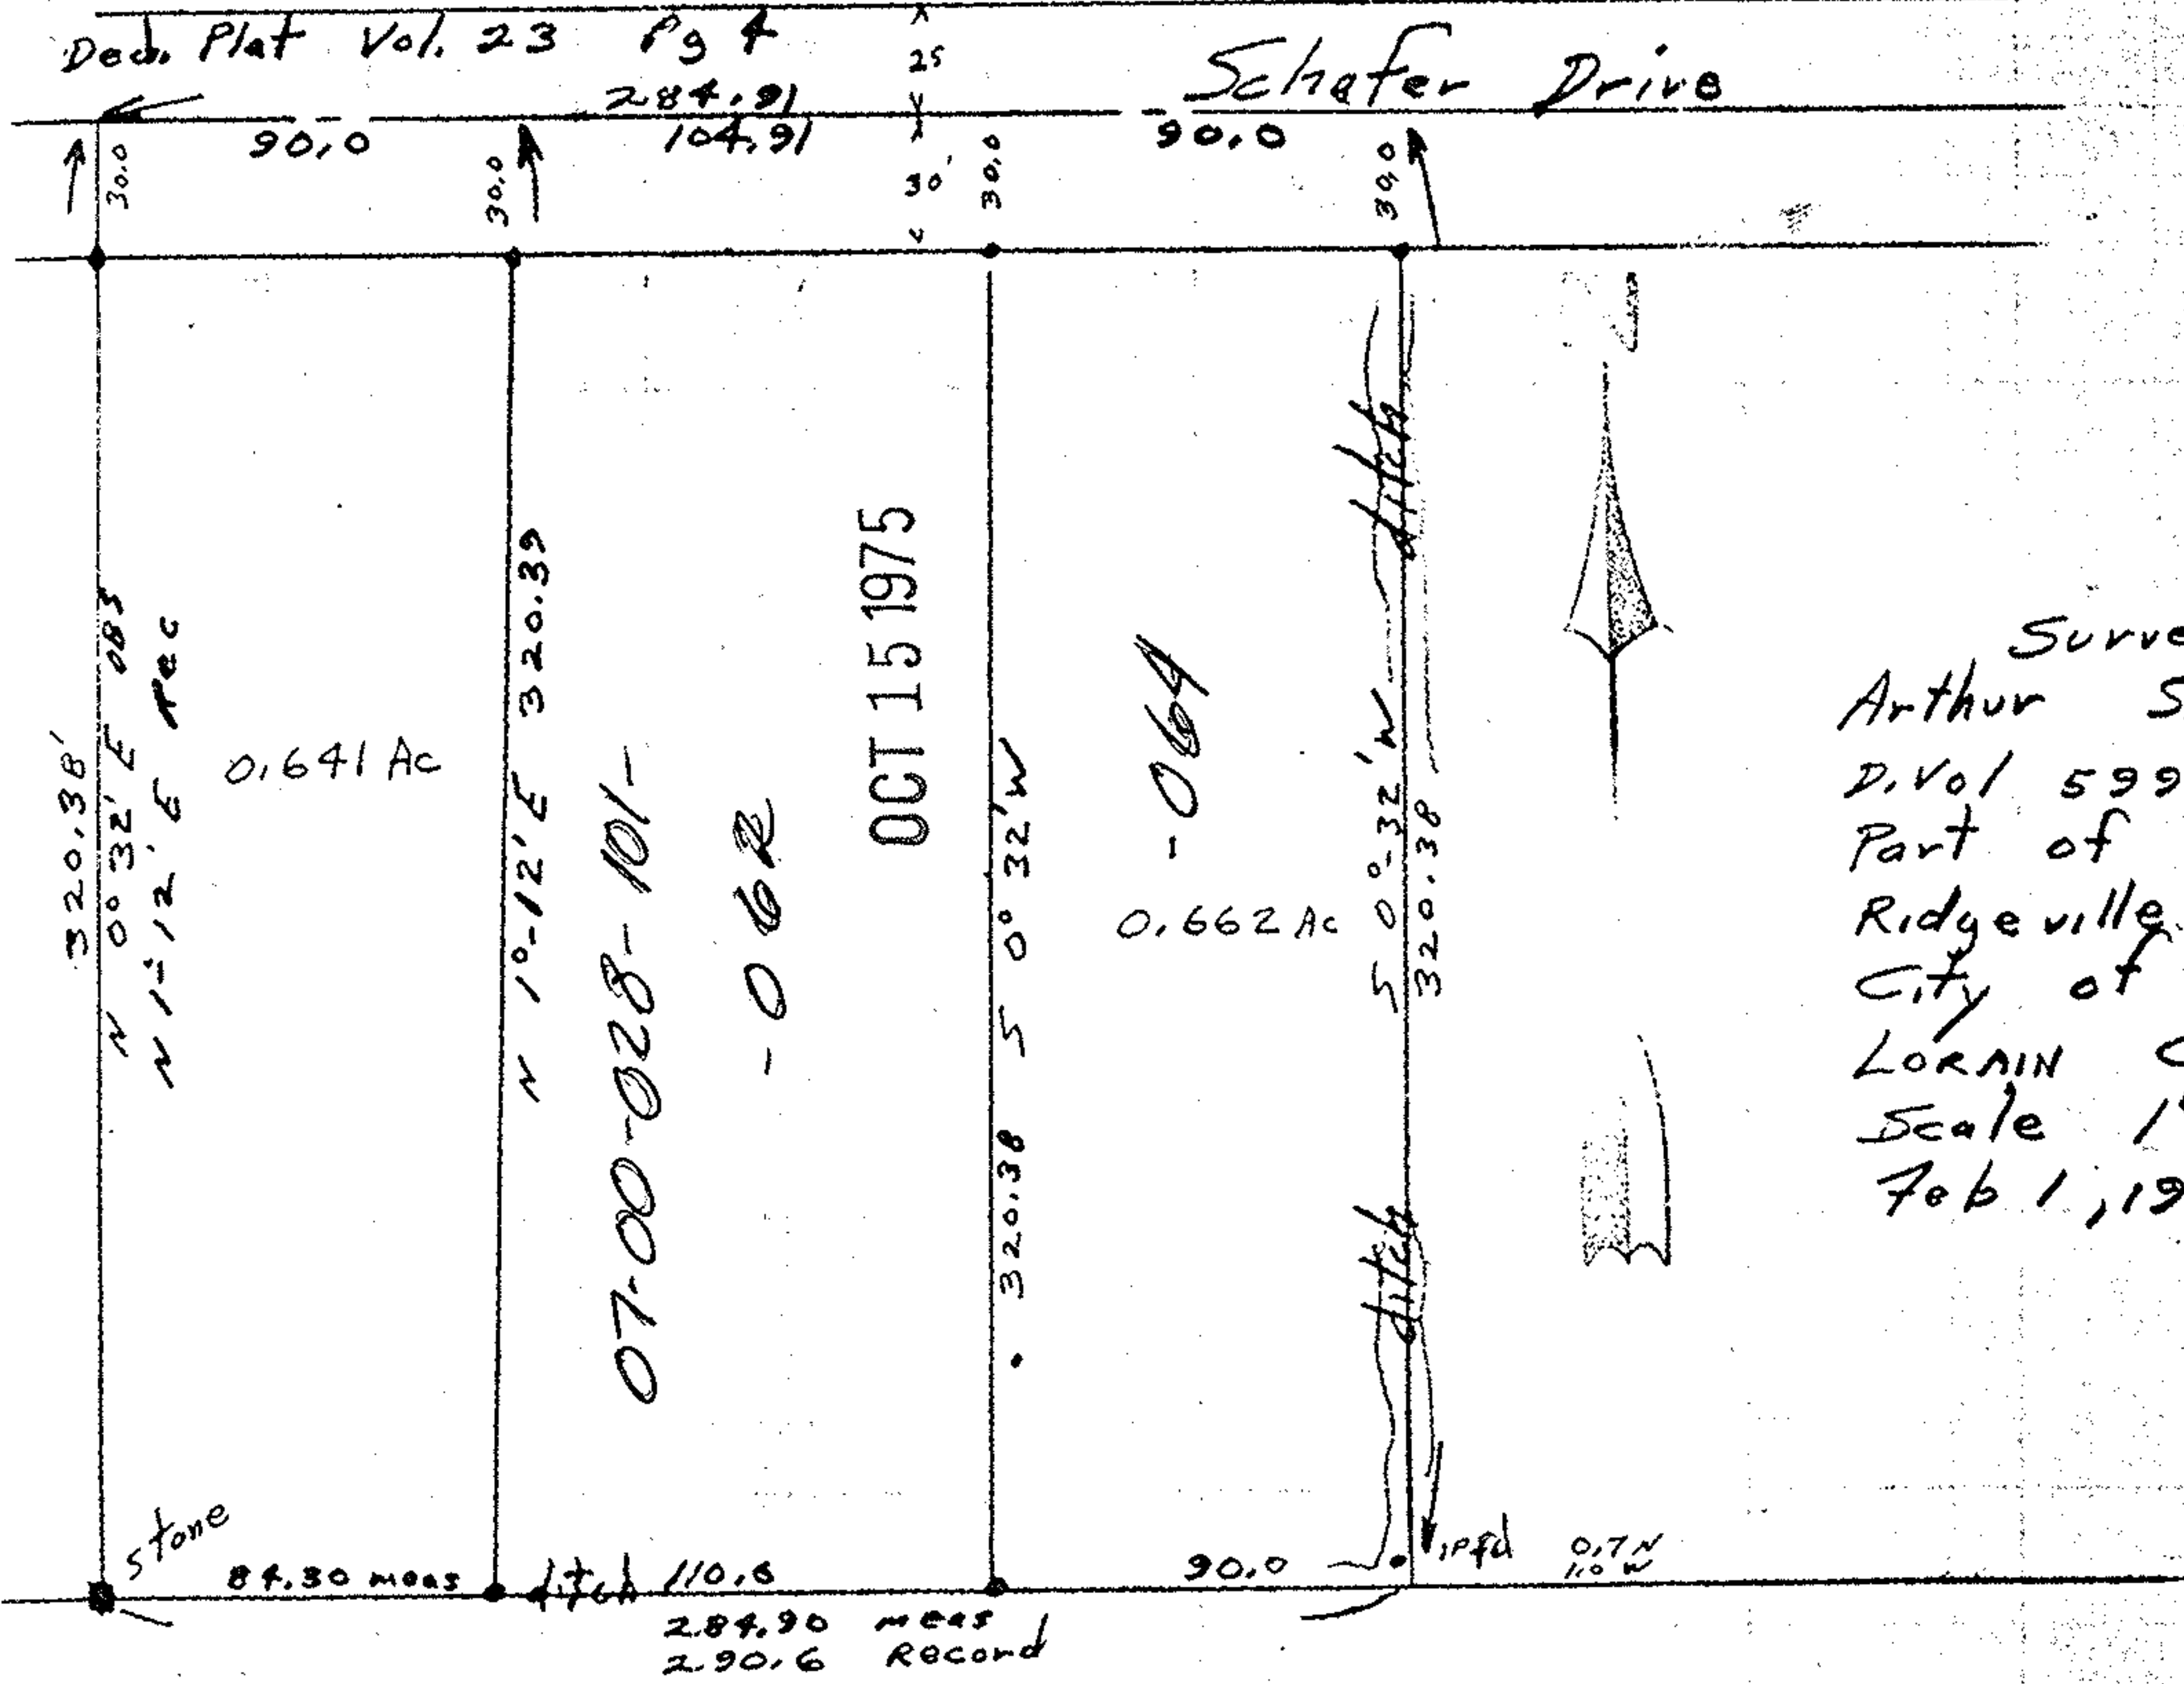

Survey for
 Arthur Simmons
 D. Vol 599 Pg 489
 Part of OL 28
 Ridgeville Twp
 City of No. Ridgeville
 LORAIN COUNTY, OHIO
 Scale 1" = 60'
 Feb 1, 1972

John Poznywak
 Reg Surveyor # 5292

Total 2.09 Ac
 • IP's fd or sot