

RACE RD.

SUGAR RIDGE RD.
N 60° 56' 00" E 1026.40'

1. Pipe Mon.


89.94m 90d.

10.00'

1. Pipe Fd. 29.26'-E

1. Pipe Fd. 29.83'-E

1. Pin Set 30.00'-E

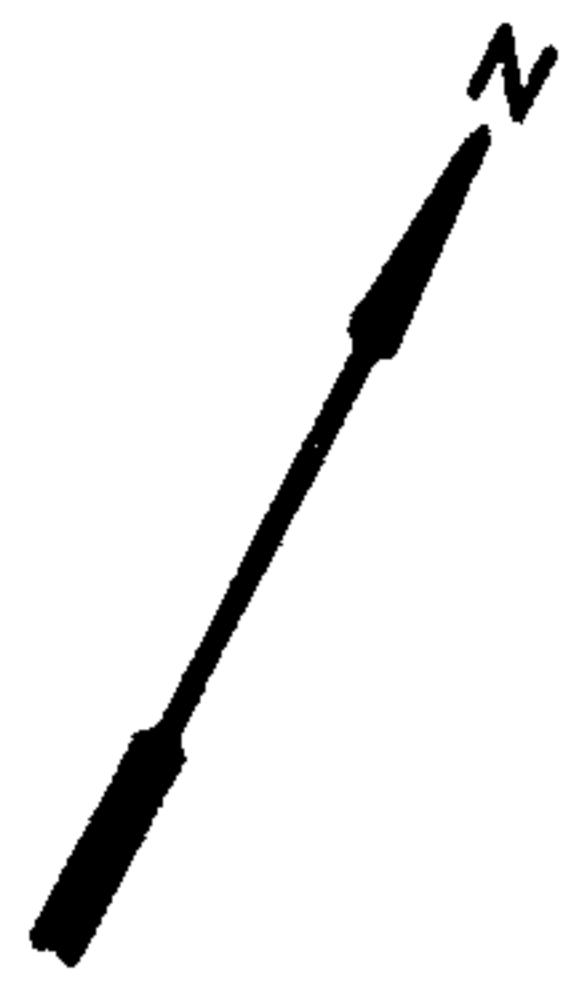

Scale: 1" = 100'
August 2001
Job No. 701-04

-012
George & Jennifer Thacker
V. 1379 P. 259

-013
Herbert J. & Evelyn E. Hintz
V. 1195 P. 202

-014
Herbert J. & Evelyn Hintz
V. 624 P. 196

1. Pin Set 208.43'-E
400.21'-E
461.34'-E
1.0734 Ac.
Pl. 1

Pl. 2
0.1059 Ac.

1. Pipe Fd. 384.50'-E

1. Pin Set 372.43'-E

1. Pin Set 414.75'-E

ditch

101.44'
N 51° 27' 44" E

1. Pipe Fd.

N 61° 01' 33" E 378.82'

N 29° 31' 33" W 44.13'

10.00'

Lexington Farms
P.V. 53 P.B

No 01051

APPROVED
LORAIN CO.
MAP DEPT.
DATE 7/2/02
DATE 7-00-035-A
BY T. SPILLMAN
02-01051

Pl. 3
3.9257 Ac.

N 29° 16' 29" W 351.59' m.

S 29° 18' 03" E 912.35'-E

-053
Jeffrey A. Taylor
O.R.V. 279 P. 179

1. Pipe Fd.

379.02' m.
S 60° 56' 15" W

1. Pipe Fd. Bent rebar reset



SURVEY FOR
KATHY SCHILKOWSKI

City of North Ridgeville County of Lorain State of Ohio
Ridgeville Township O.L. 35

CARLSON SURVEYS
440-926-0200

P.P.N 07-00-035-102-069 thru 072