



08-13 018-000-007

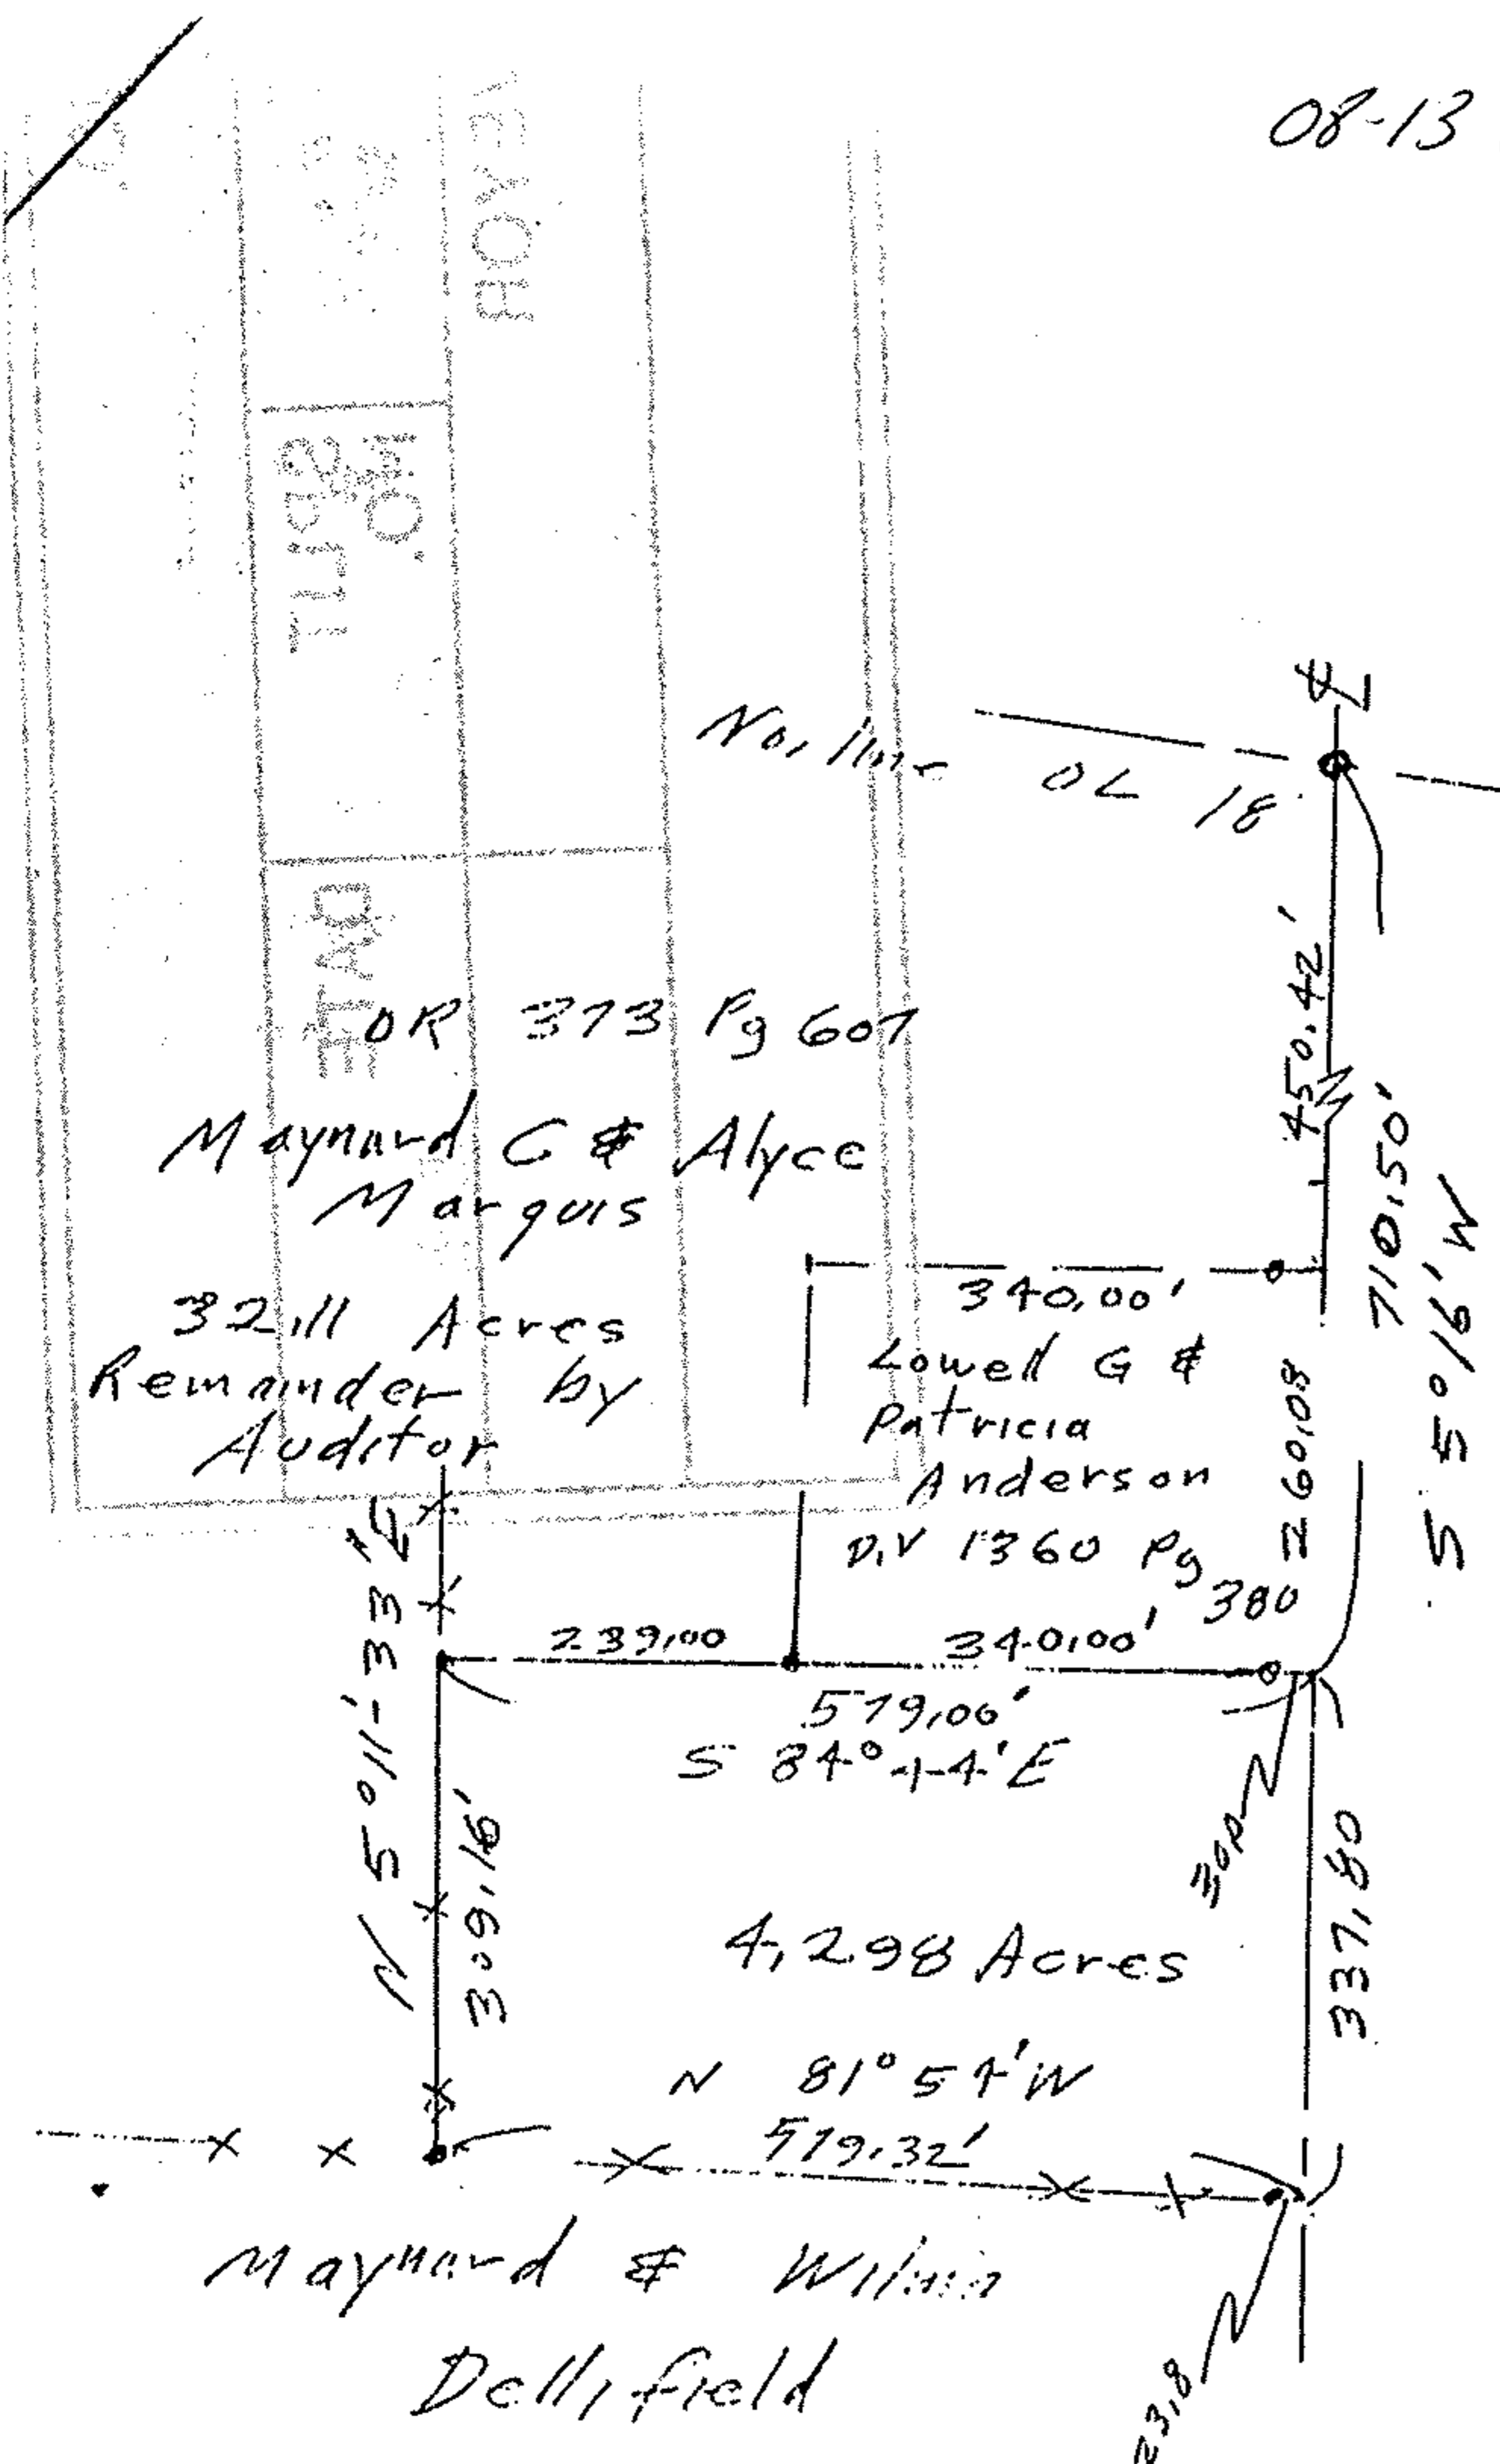

#21856

APPROVED	
LORAIN CO.	
MAP DEPT.	
DATE	7-25-96
PAGE	8-E
BY	<i>Collect</i>
VOID AFTER	21856

- o iron pipes fd
- iron pins set

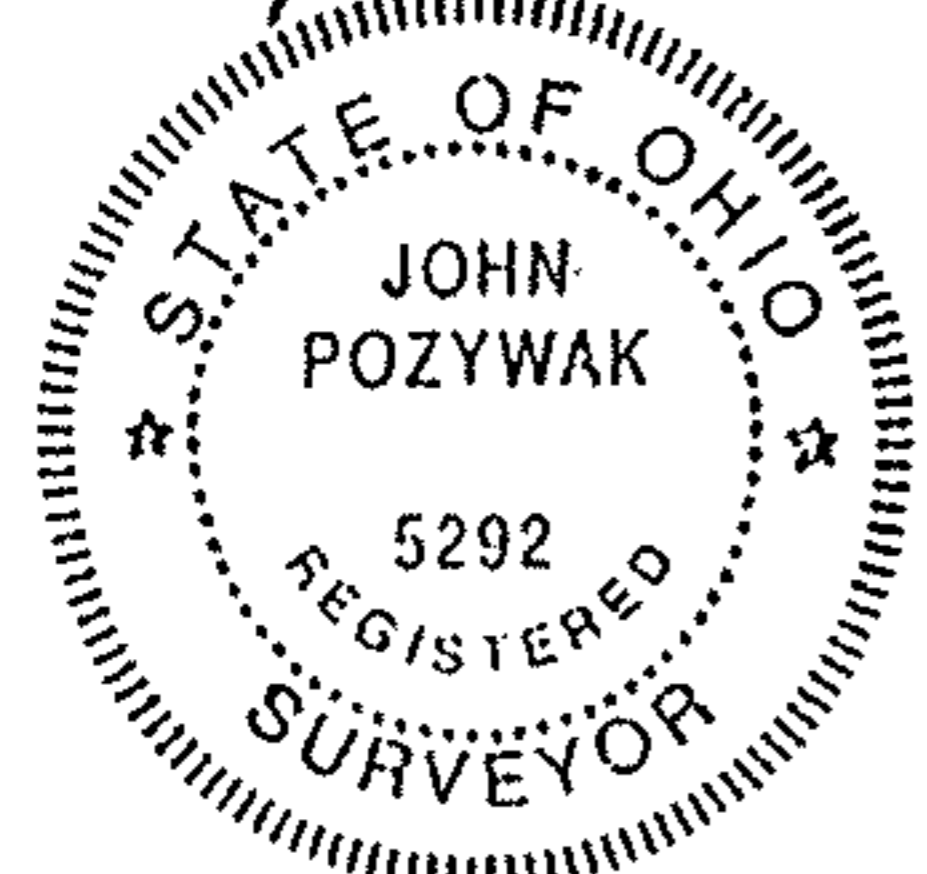

Survey of Parcel Split
 for Maynard Marguis
 Original Lot 18 Tract 13
 Henrietta Township
 Lorain County OH
 Scale 1" = 200' June 1996

John Pozywak
 Reg Surveyor 5292