


11698

APPROVED	L. Johnson
MAILING DEPT.	
DATE	5/25/97
PAGE	8-2
BY	S. Johnson
VOID AFTER	11698

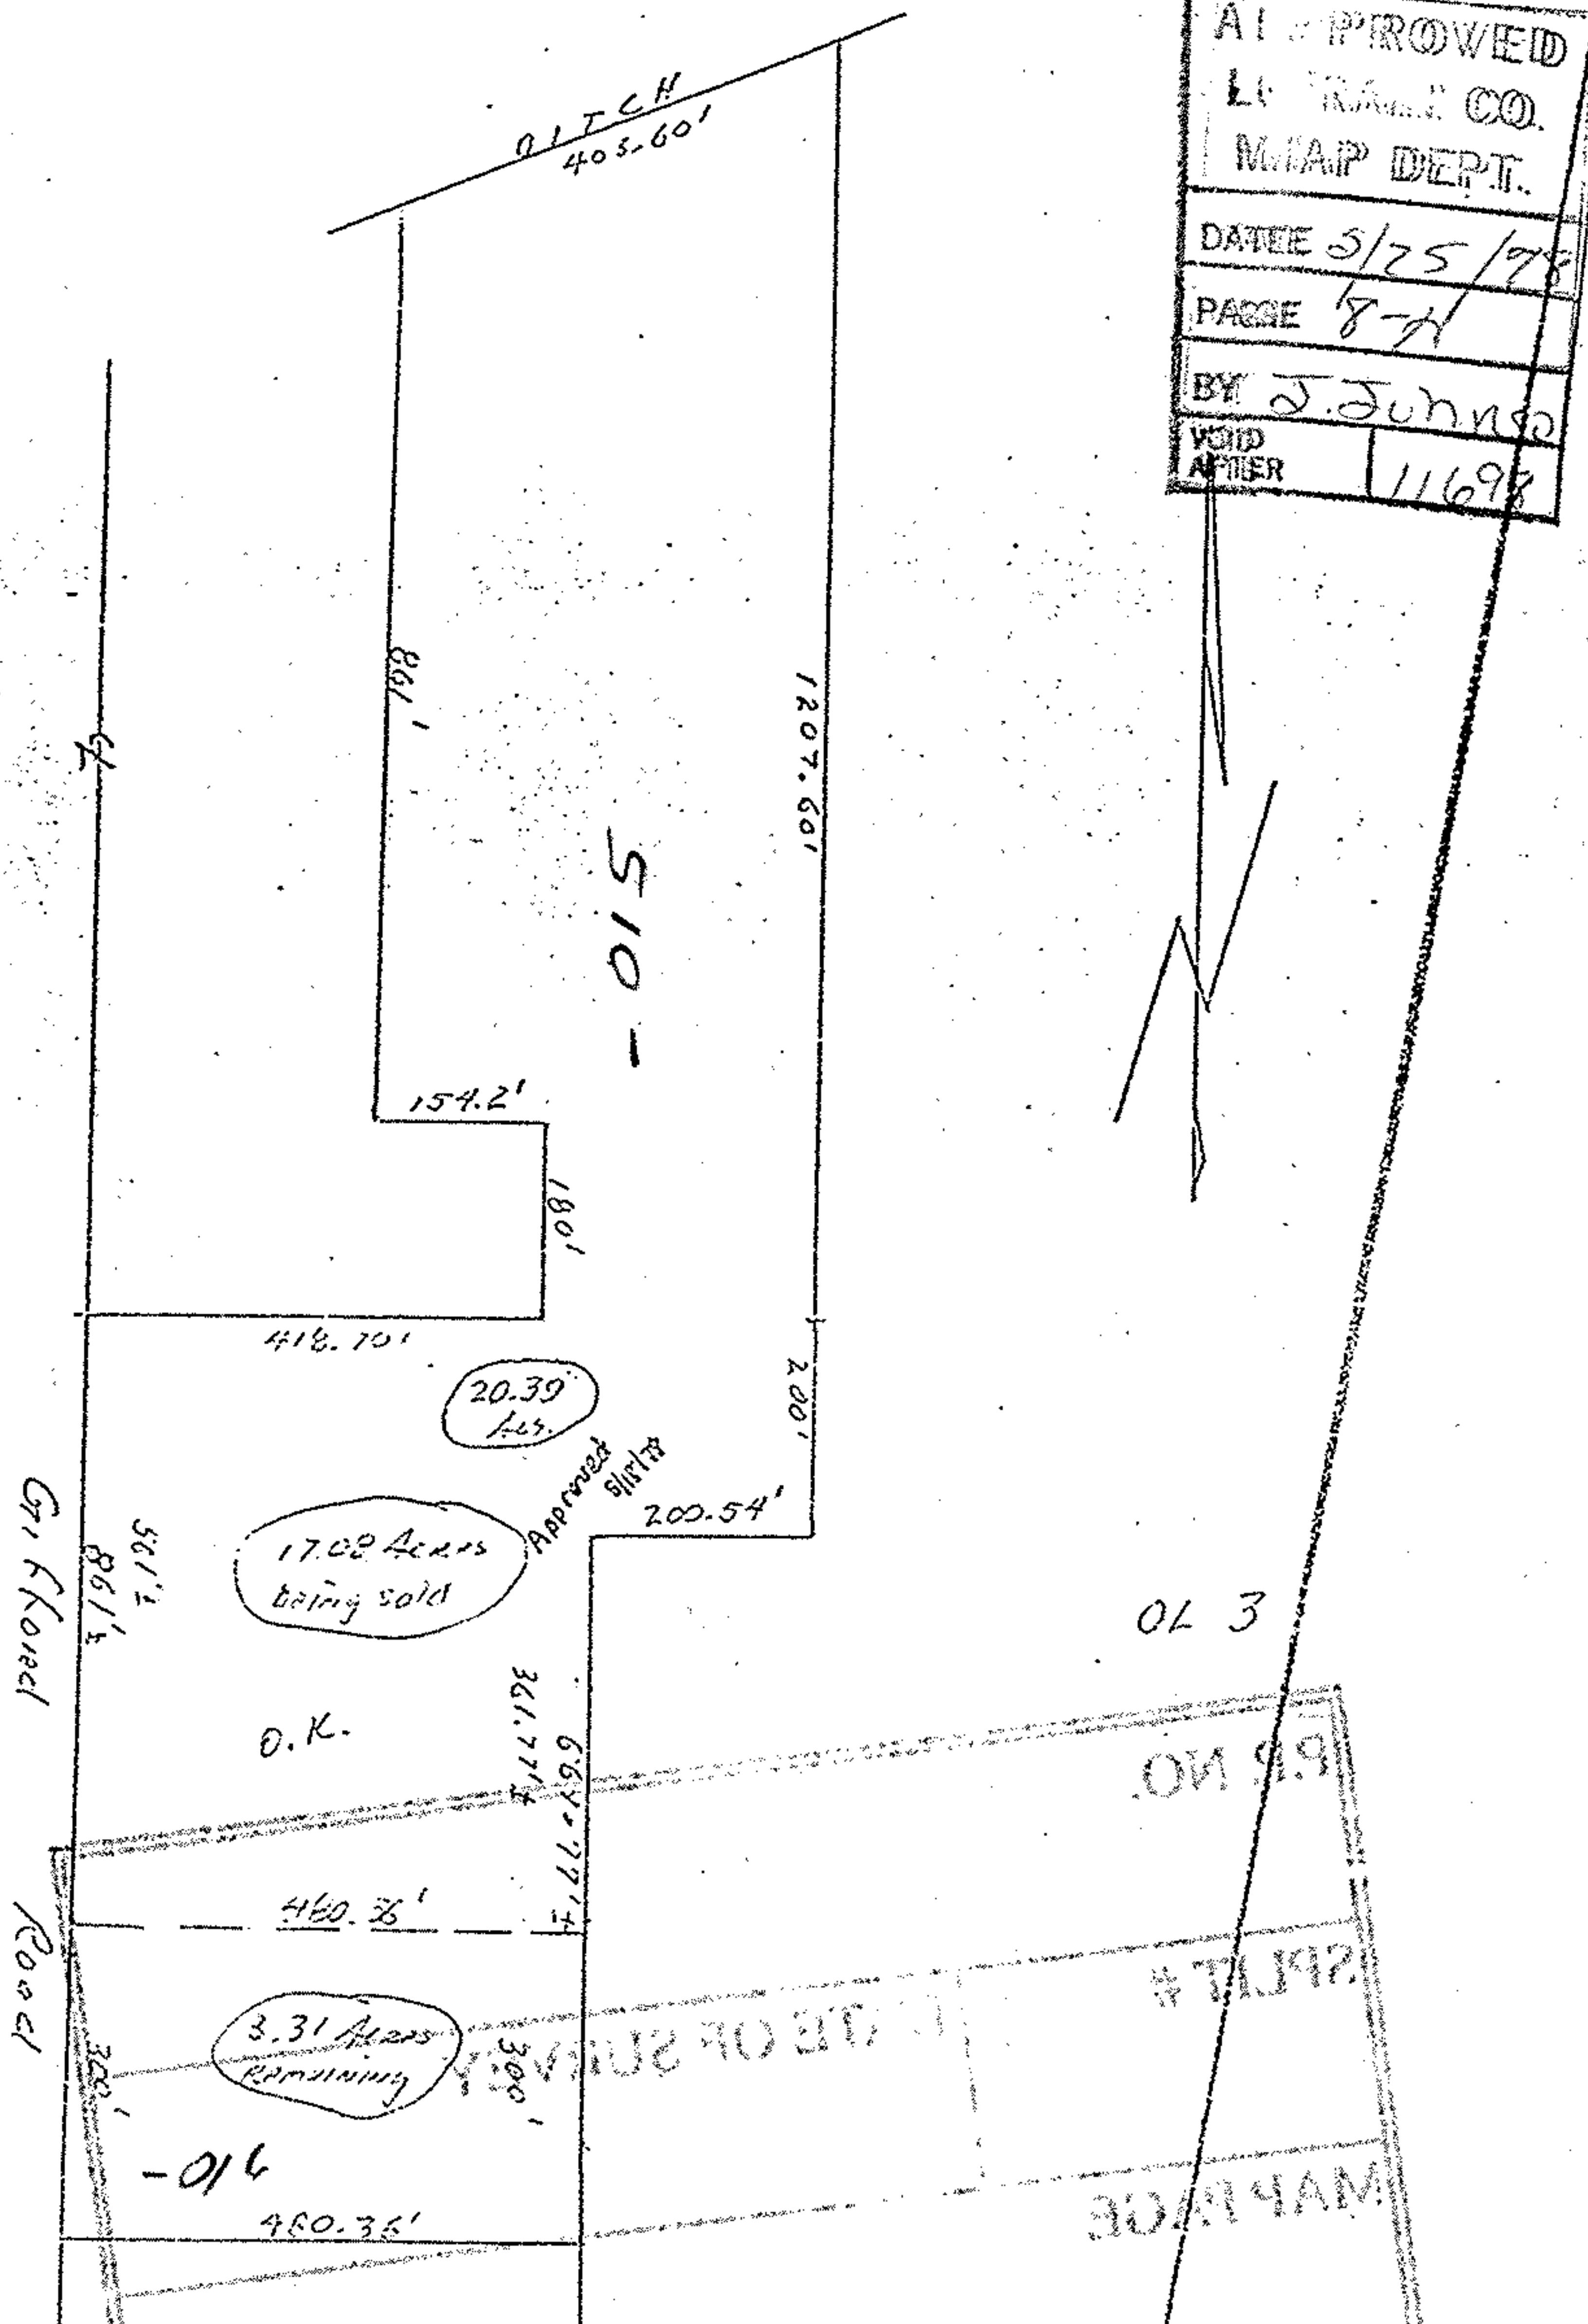

Geotrichum *spad.*

(Route 10);

A-9

86911 #
E00-21-80