

4.115 ac  
- 4.52 ac - New property

PP # 08-15-020-000-010, 008,009,022

08-15-020-000

#14719

#14719

APPROVED  
LORAIN CO.  
MAP DEPT.


DATE 6-14-82

PAGE ~~7~~ 8

BY T. McNeil

VOID  
AFTER

United Brethern Church

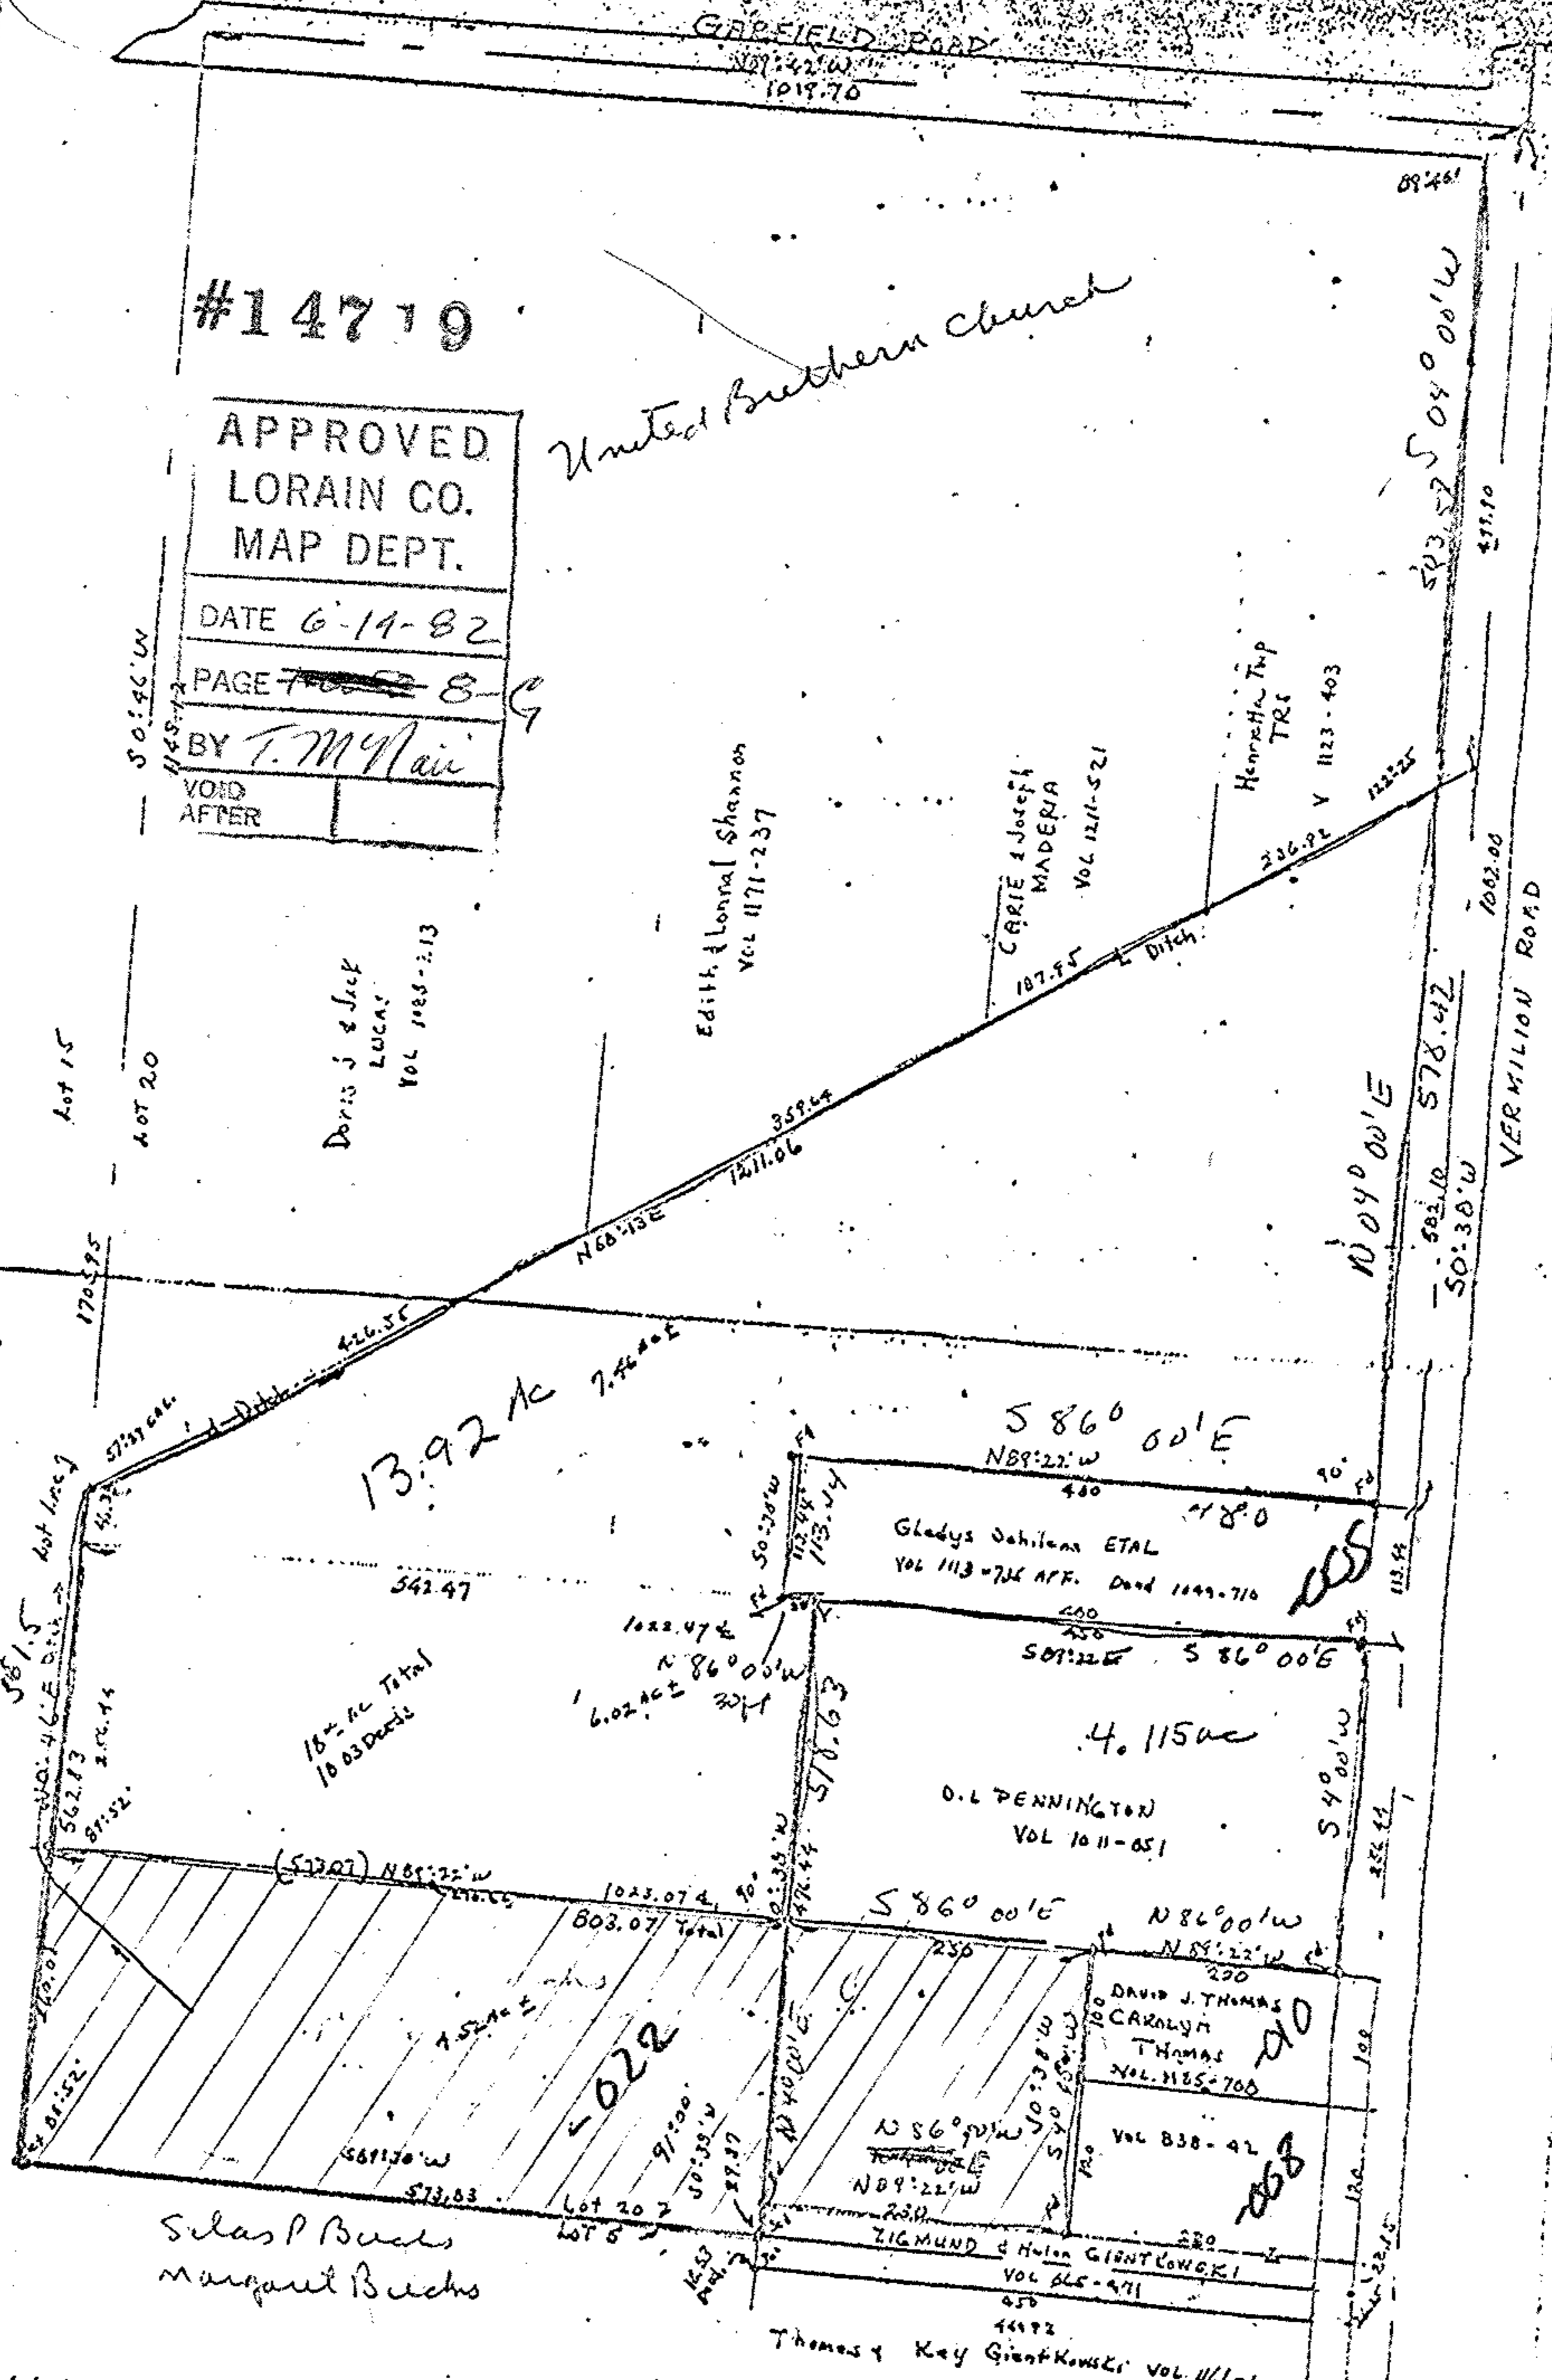

Silas P Buchs  
Margaret Buchs

MAP OF LOT 20 TRACT 15 HENRIETTA TWP.  
LORAIN CO. OHIO SCALE 1"=100'  
JULY 28 1981 BY ARNOLD KOEPP REG. SURVEYOR

B-G