


FM Pg
5-E

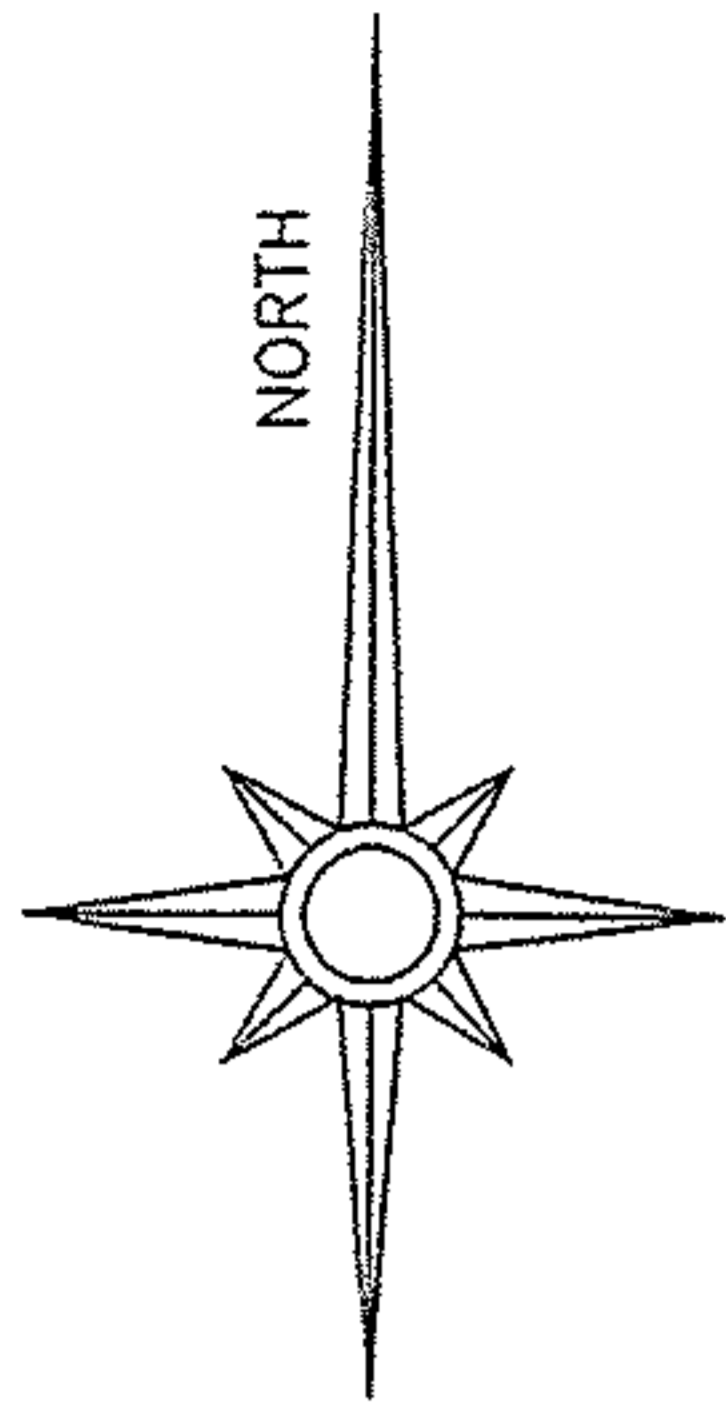

MIDDLE RIDGE SUBDIVISION
(PLAT BOOK 47, PAGE 47)

DENNIS L. &
TIMOTHY WAYNE ABRAHAM ETAL.
PARCEL NO. 0500007500001
IN. NO. 20040979343
2.80 ACRES

CITY OF AMHERST
PARCEL NO.
0500007000014
2.9721 ACRES
IN. NO. 19980562919

RICHARD P. SCHNEIDER
PARCEL NO.
0500007000016
IN. NO. 19980562918
1.4147 ACRES

MIKE HARRIS
PARCEL NO.
0500007000022
IN. NO. 20010730513
2.9428 ACRES

RICHARD P. SCHNEIDER
PARCEL NO. 0500007000023
IN. NO. 20030971321
11.170 ACRES (BY AUDITOR)

PARCEL NO. 0500006000041
IN. NO. 20000675716
1.979 ACRES

RICHARD P. SCHNEIDER
PARCEL NO. 0500006000022
IN. NO. 20000675716
6.398 ACRES

N 87°45'02"E 678.00' SE COR. LOT 6

NE COR. LOT 7

8.9233 ACRES

GARY W. & LYNN R. SOOY
PARCEL NO. 0500007000009
ALL OF 8.34 ACRES (BY DEED)
ALL OF 8.9233 ACRES (BY SURVEY)
VOL. 1417, PAGE 686

CHRISTY S. SELLERS
PARCEL NO. 0500014000001
O.R. VOL. 1358, PAGE 56
3.11 ACRES

388.21'
S 00°57'04"W 398.36'

N 00°37'54"W 441.90'

N 88°08'00"E 1682.90'

305.38'

1377.52'

S 84°44'45"W 958.64'

N 00°40'15"W 20.06'

S 84°44'45"W 747.97'

S 05°15'15"E 35.00'

S 84°44'45"W 655.99'

OHIO TURNPIKE

OHIO TURNPIKE

PERTINENT DOCUMENTS: AS SHOWN

BEARINGS ORIENTED TO THE SOUTH BOUNDS OF
THE ORIGINAL 8.34 ACRE TRACT (VOL. 1417, PAGE 686).

- I 1" IRON BAR FOUND
- o 5/8" IRON PIN FOUND
- o 3/4" IRON PIPE FOUND



I HEREBY CERTIFY THAT THIS
PLAT IS TRUE AND CORRECT.

RONALD L. SMITH
REGISTRATION NO. 5324

DATE: 08-23-2004

SCALE: 1" = 200'

RON SMITH SURVEYING
4180 MURRAY ROAD NW
DOVER, OHIO 44622
(330) 343-4730

Plat of Survey
for
GARY W. & LYNN R. SOOY

LOCATED IN
PART OF LOT 7 IN
THE ORIGINAL AMHERST TOWNSHIP
CITY OF AMHERST, LORAIN COUNTY, OHIO

05-00-007-000-009