



PARENT PARCEL: 07-00-020-101-100, 07-00-020-101-007

CHILD PARCEL: 07-00-020-101-104 THRU -115

STARTING POINT: CENTERLINE OF SANDLEWOOD AVE & POPLAR ST.

NO. 00803

07-00-020-101-007-114, 115, 111

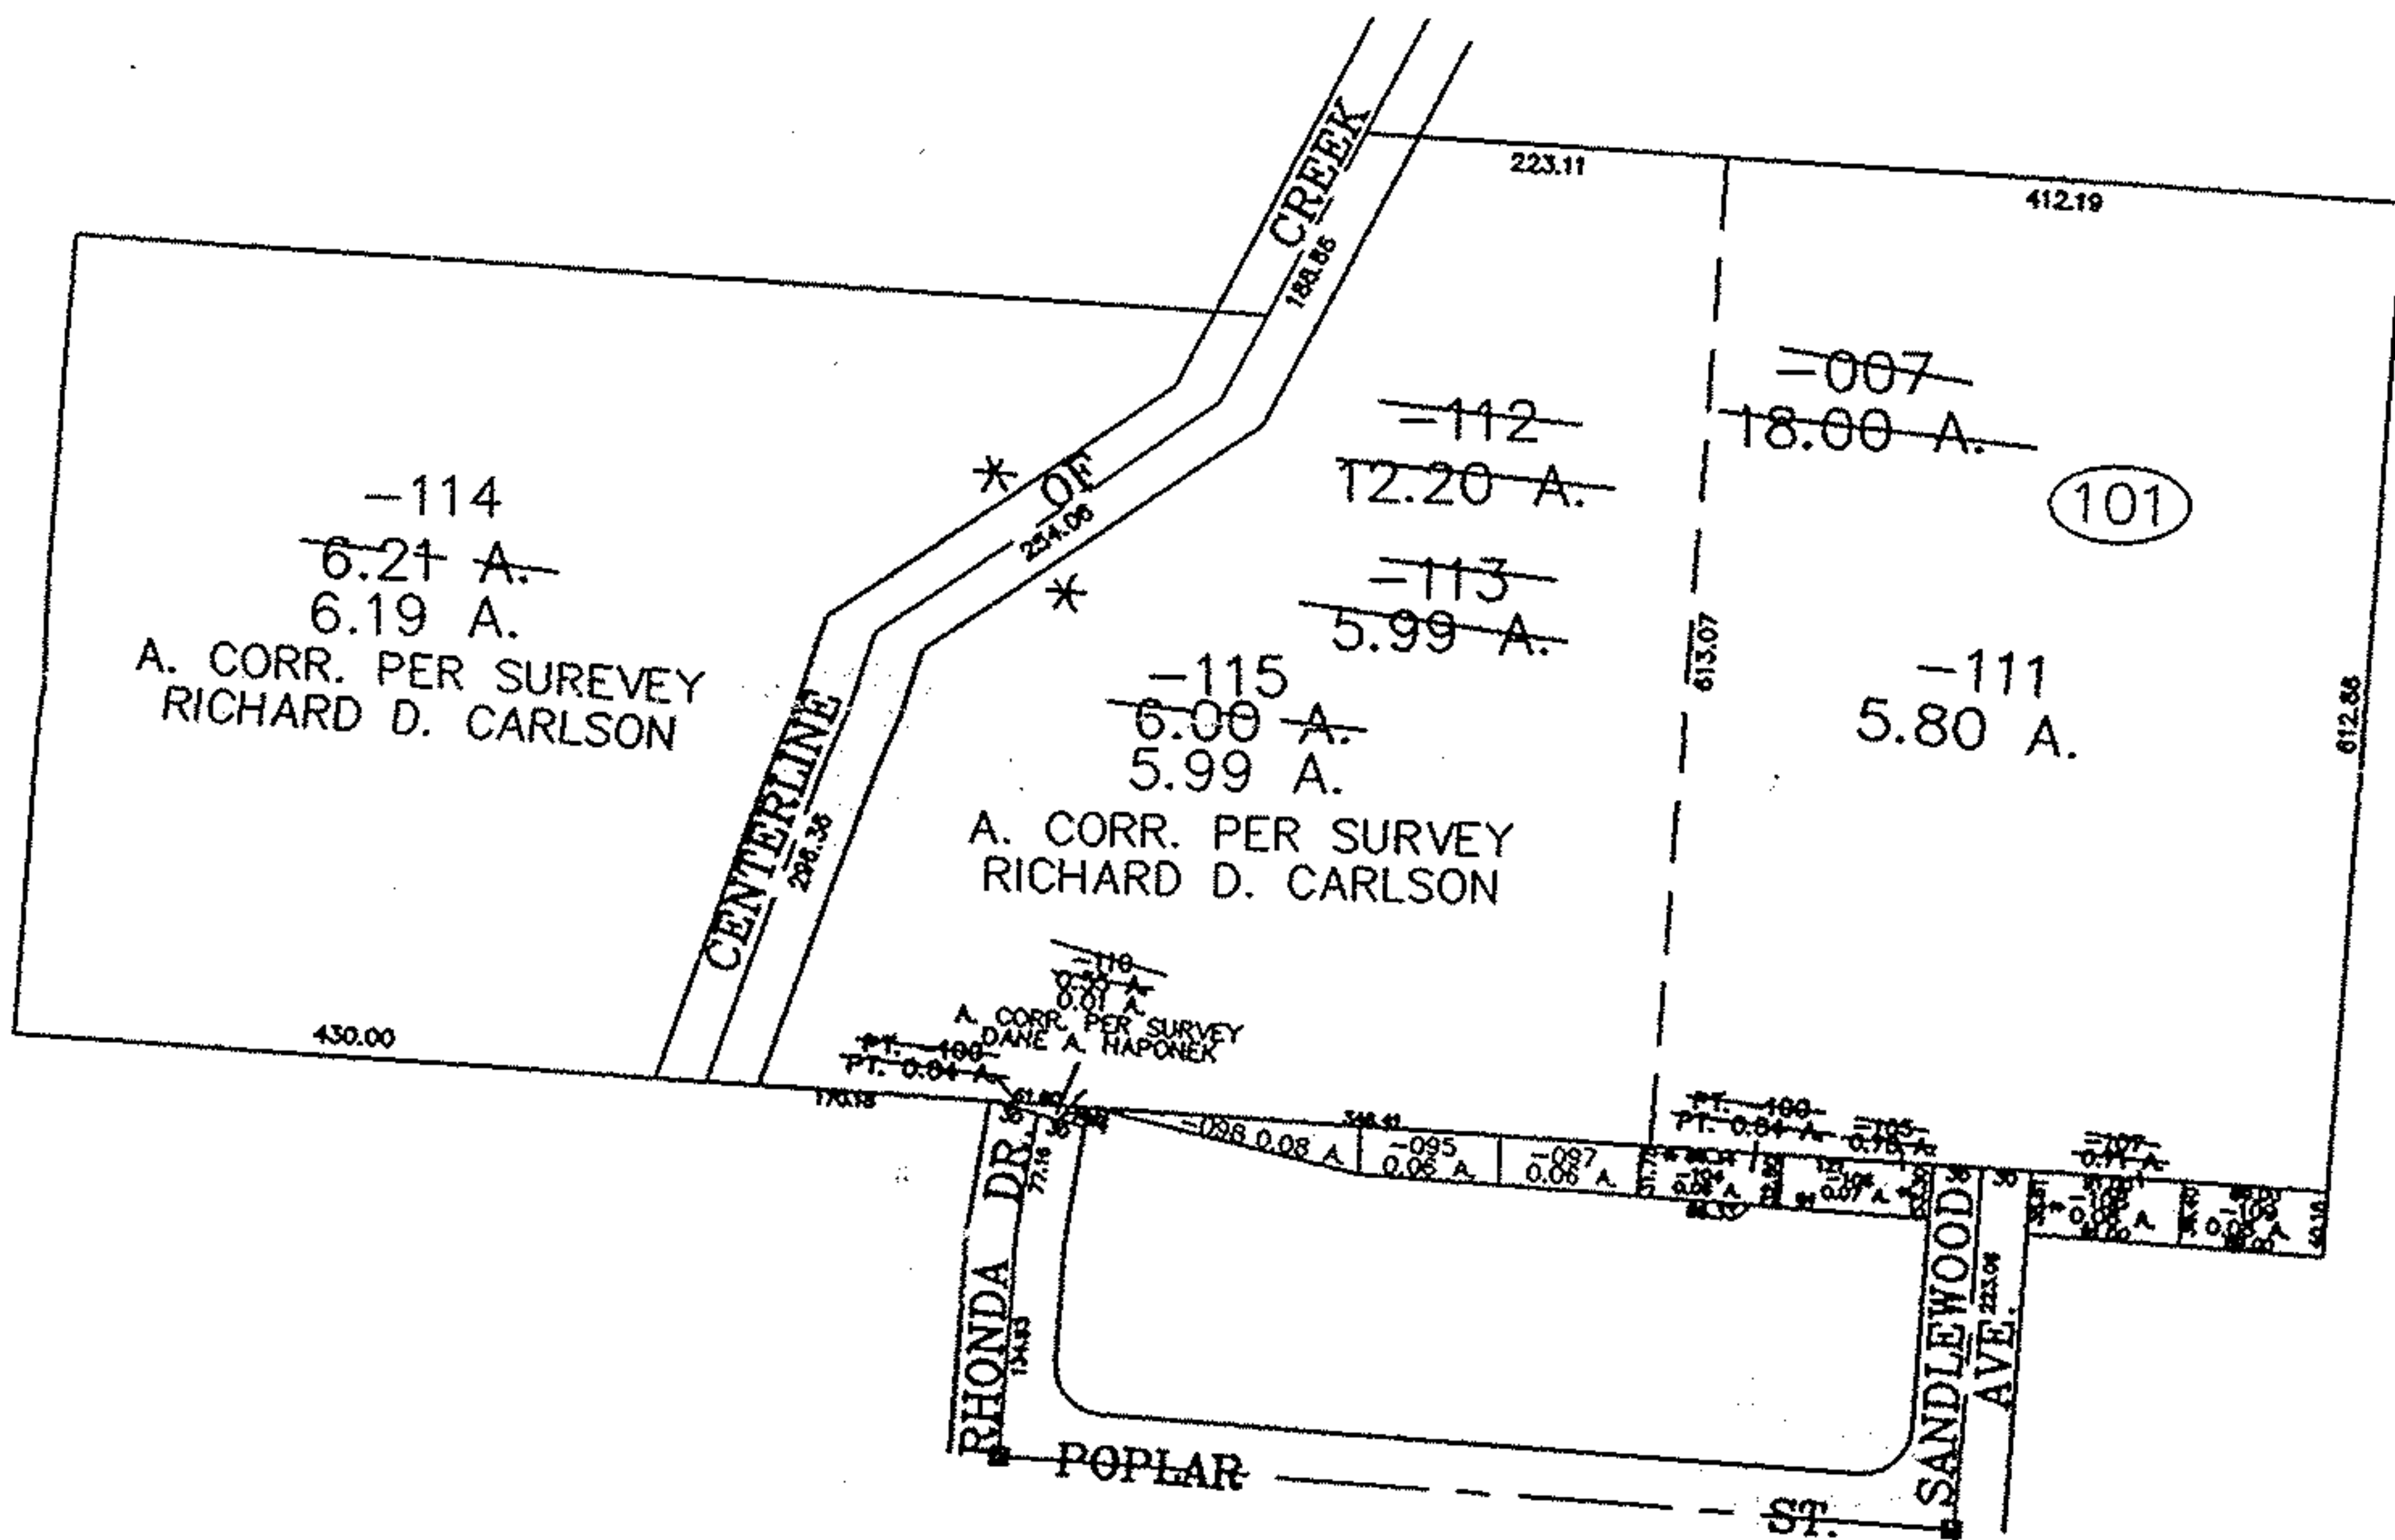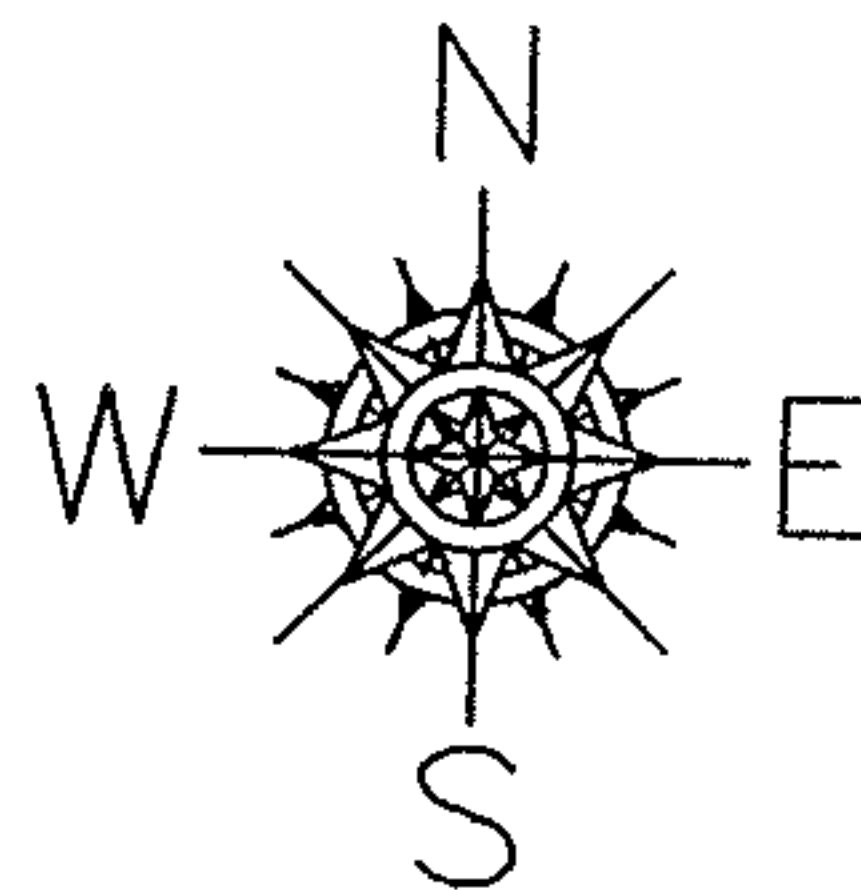

**SPLITS/DEEDS PROCESSED**

LORAIN COUNTY TAX MAP DEPARTMENT  
226 MIDDLE AVE. ELYRIA, OHIO

SURVEYED BY: DANE HAPONEK, RICK CARLSON  
CLOSURE: 0.01 : 10,000

MAP PAGE(S): 7-00-020-A, C

APPROVED BY: JAH DATE: 7-13-01

SCALE: 1" = 200' PRIOR INSTRUMENT: 980584765