


07-00-014-105-108  
# 15306  
map page

07-00-014-D

7-00-014-D

# 15306

07-00-014-105-108

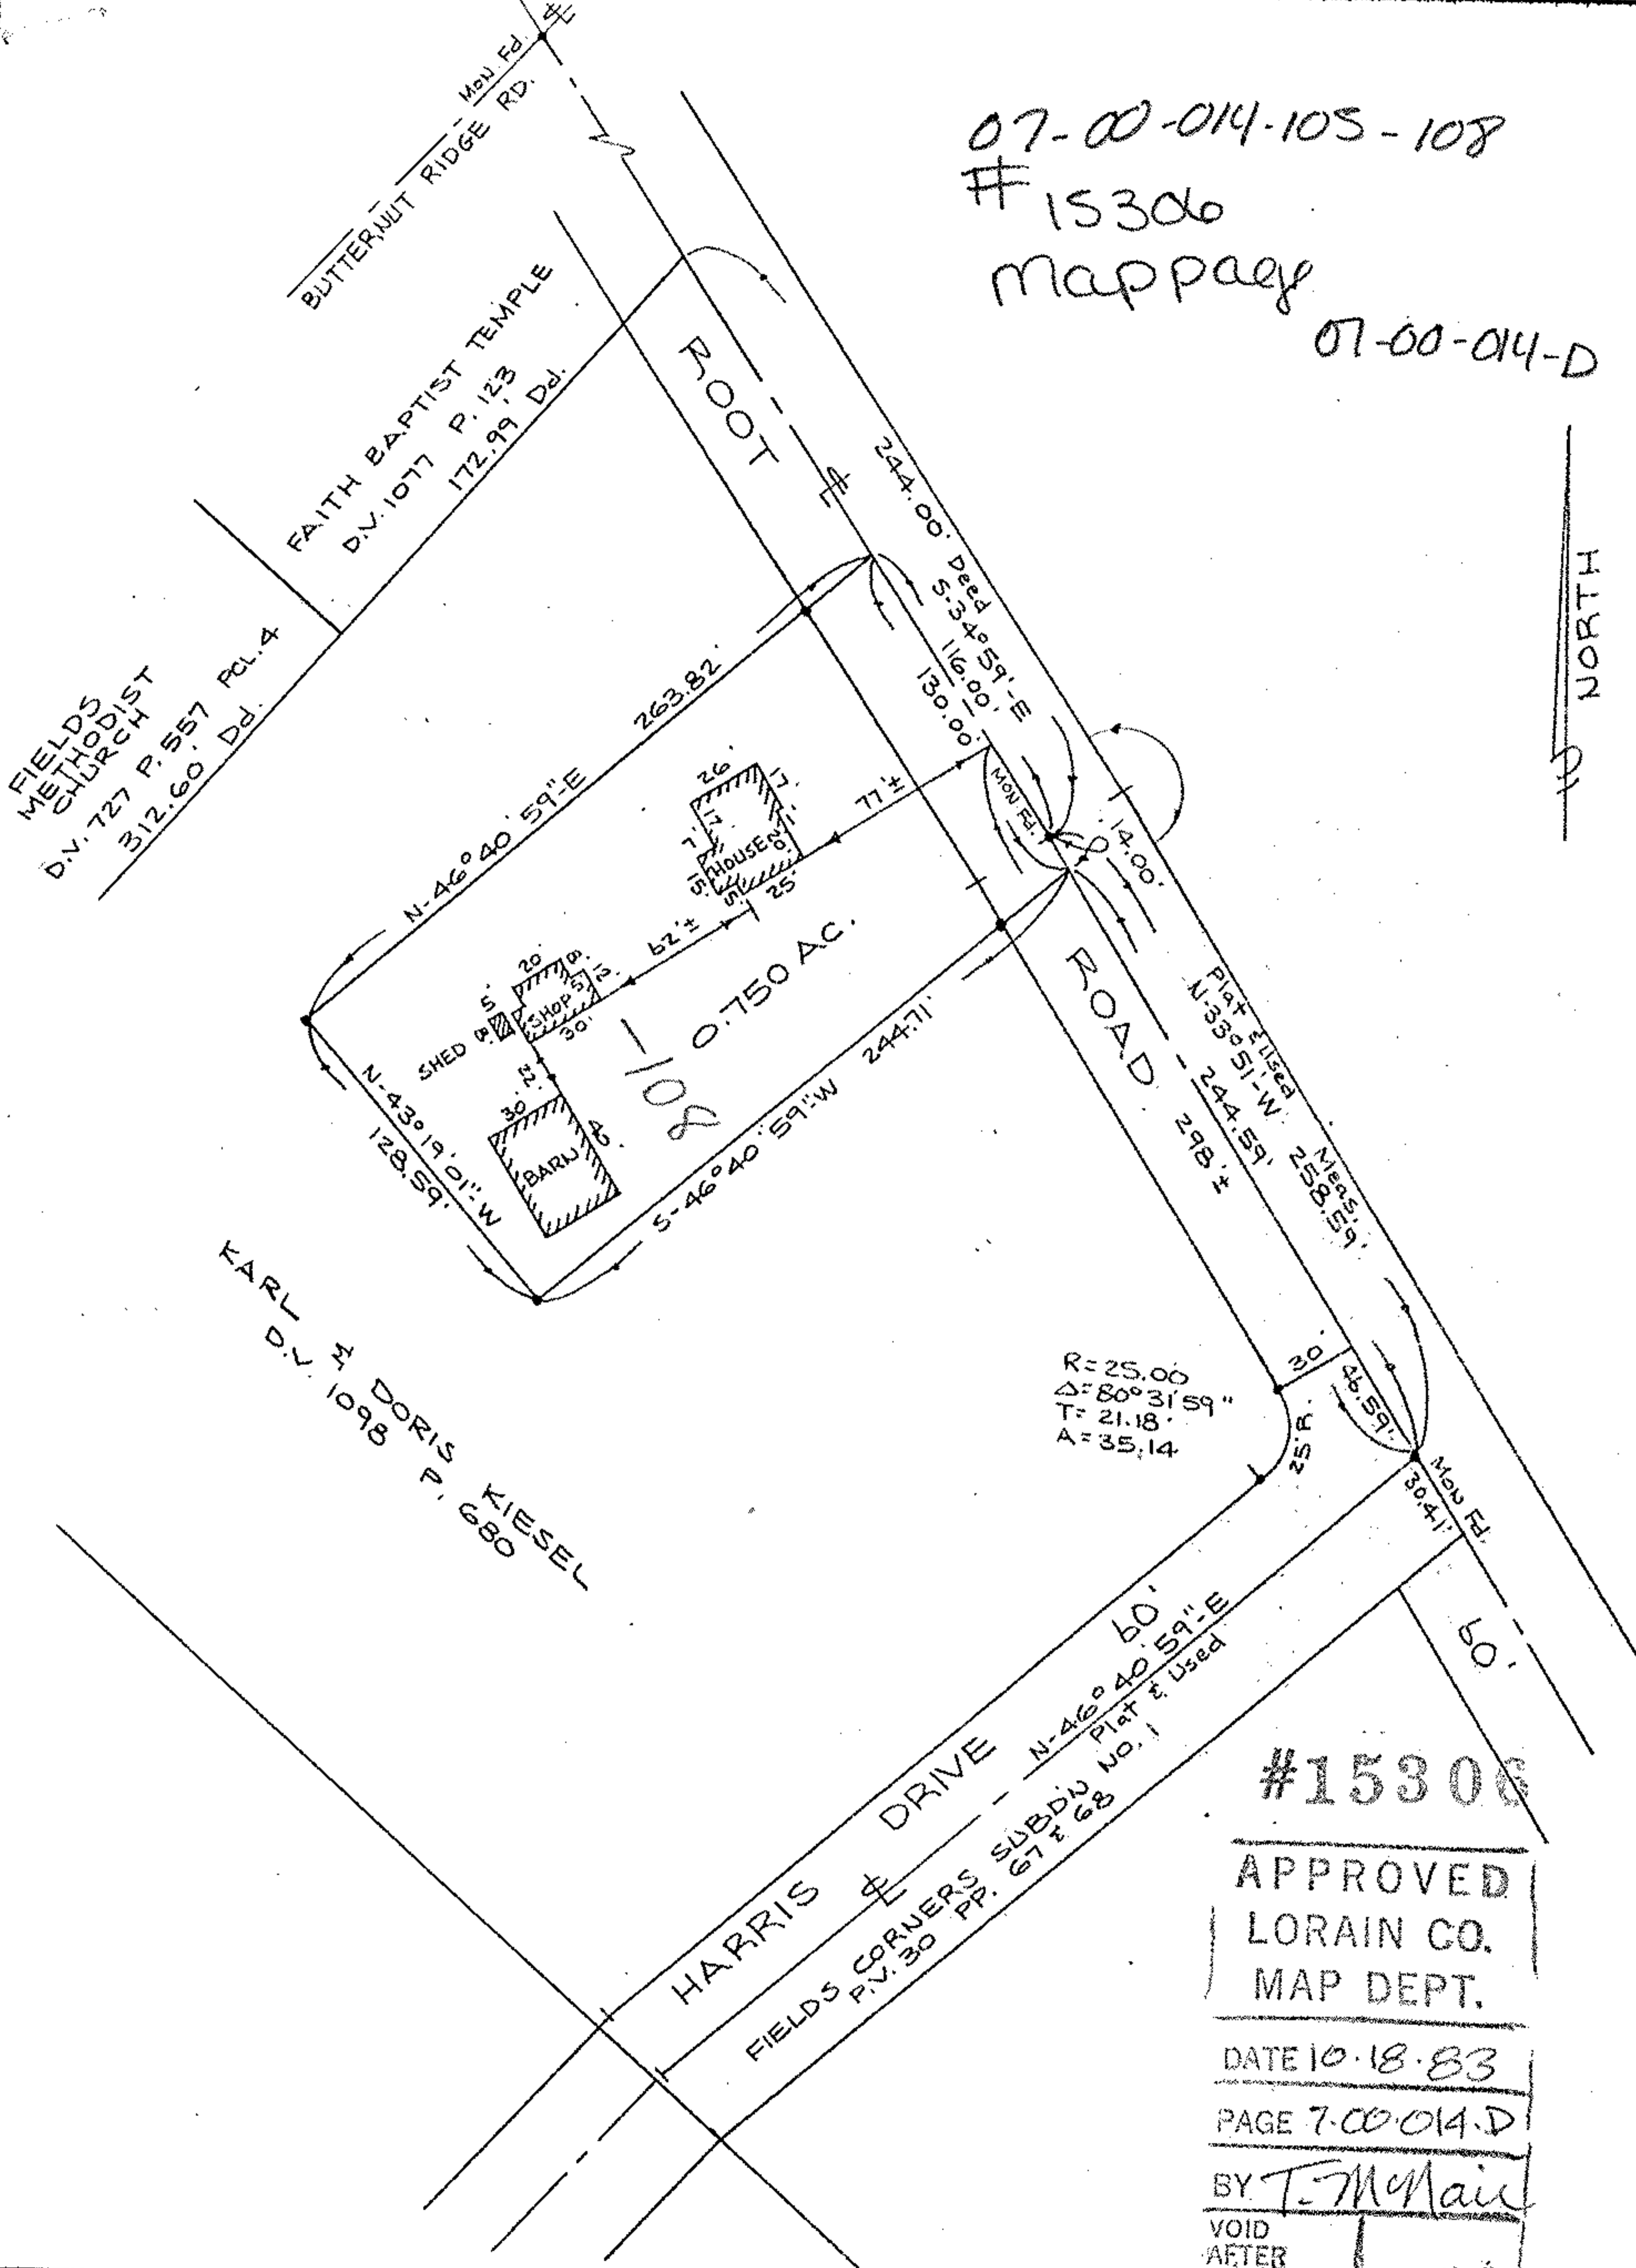

NORTH

#15306

APPROVED  
LORAIN CO.  
MAP DEPT.  
DATE 10-18-83  
PAGE 7-00-014-D  
BY T. McMain  
VOID  
AFTER

Prepared for: KARL KIESEL

Scale: