


06-21-004-101-027

#19343A

6-4

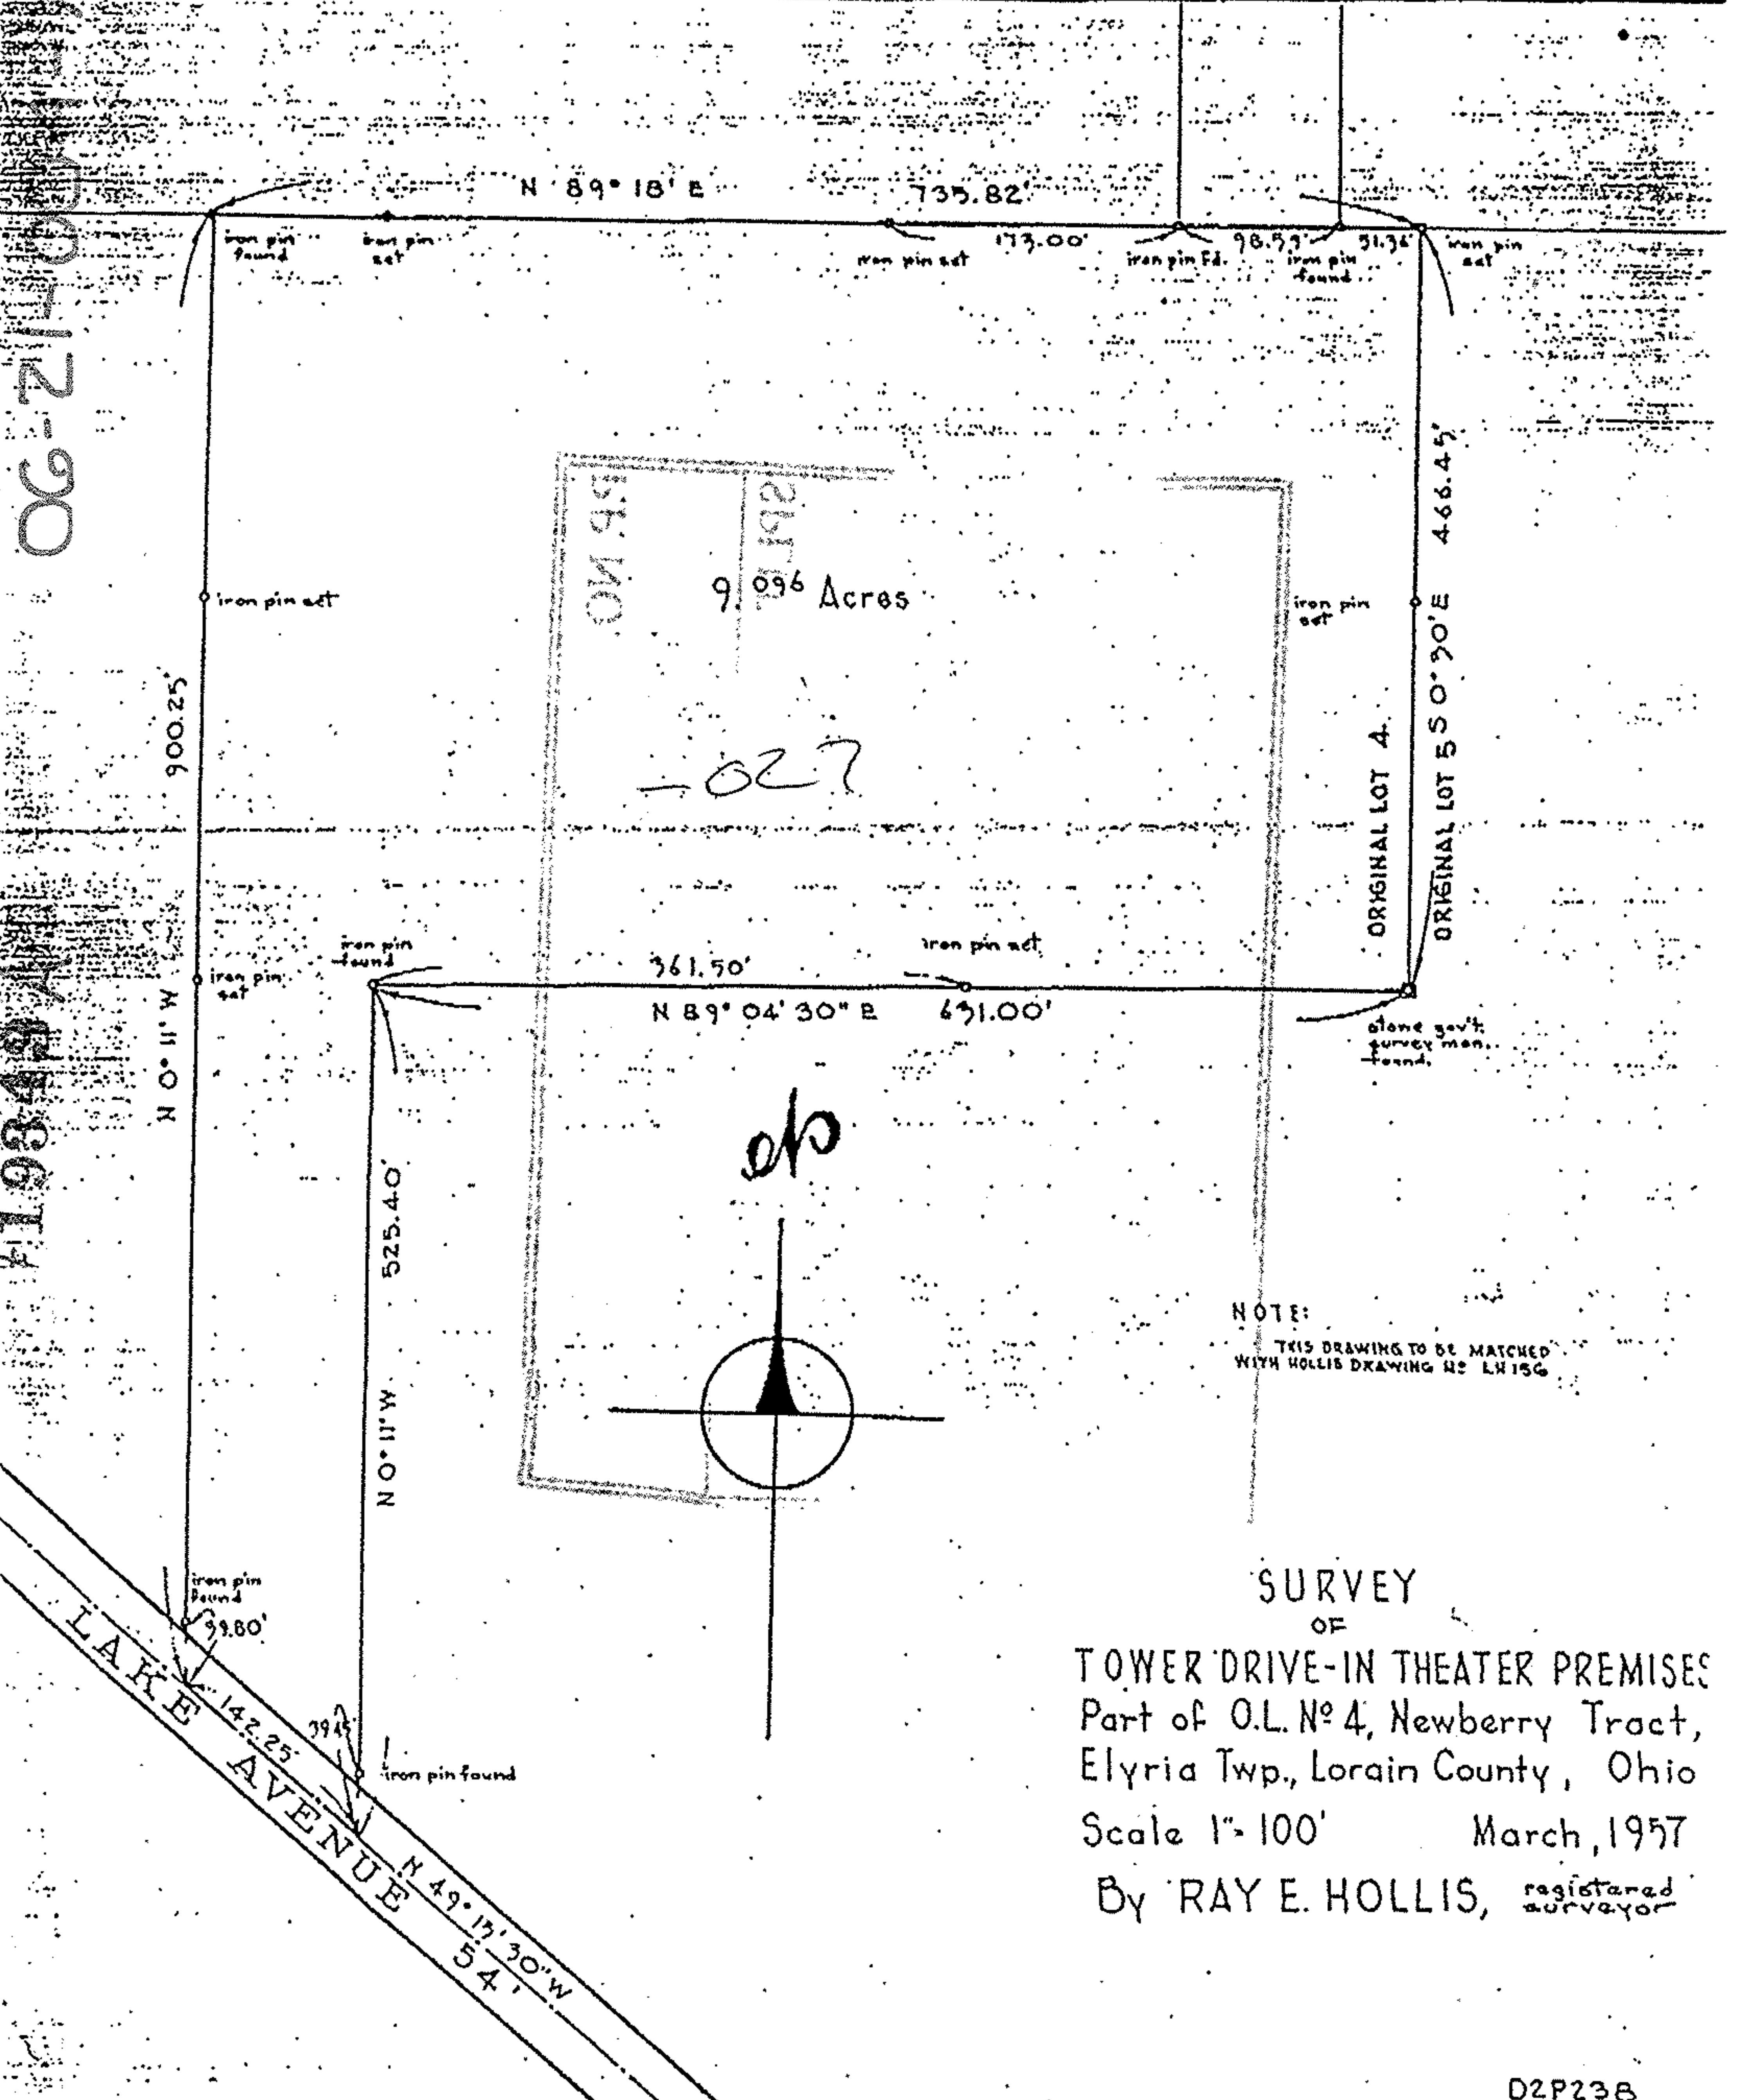

06-21-004-101-027

#19343 A

APPROVED
LORAIN CO.
MAP DEPT.
DATE 4-26-91
PAGE 6-4
CAROLYN
BY FRANCIS
VOID
AFTER # 19343-A

D2P23B