

13-11-028-000-009-7012 006, 007
 13-11-029-000-011, 012, 013


DATE OF SURVEY

21958

13-D
 OK
 Carl M. Feick

Leon and Betty Groot
 1192 707

Gloria Davidson
 907 - 0073

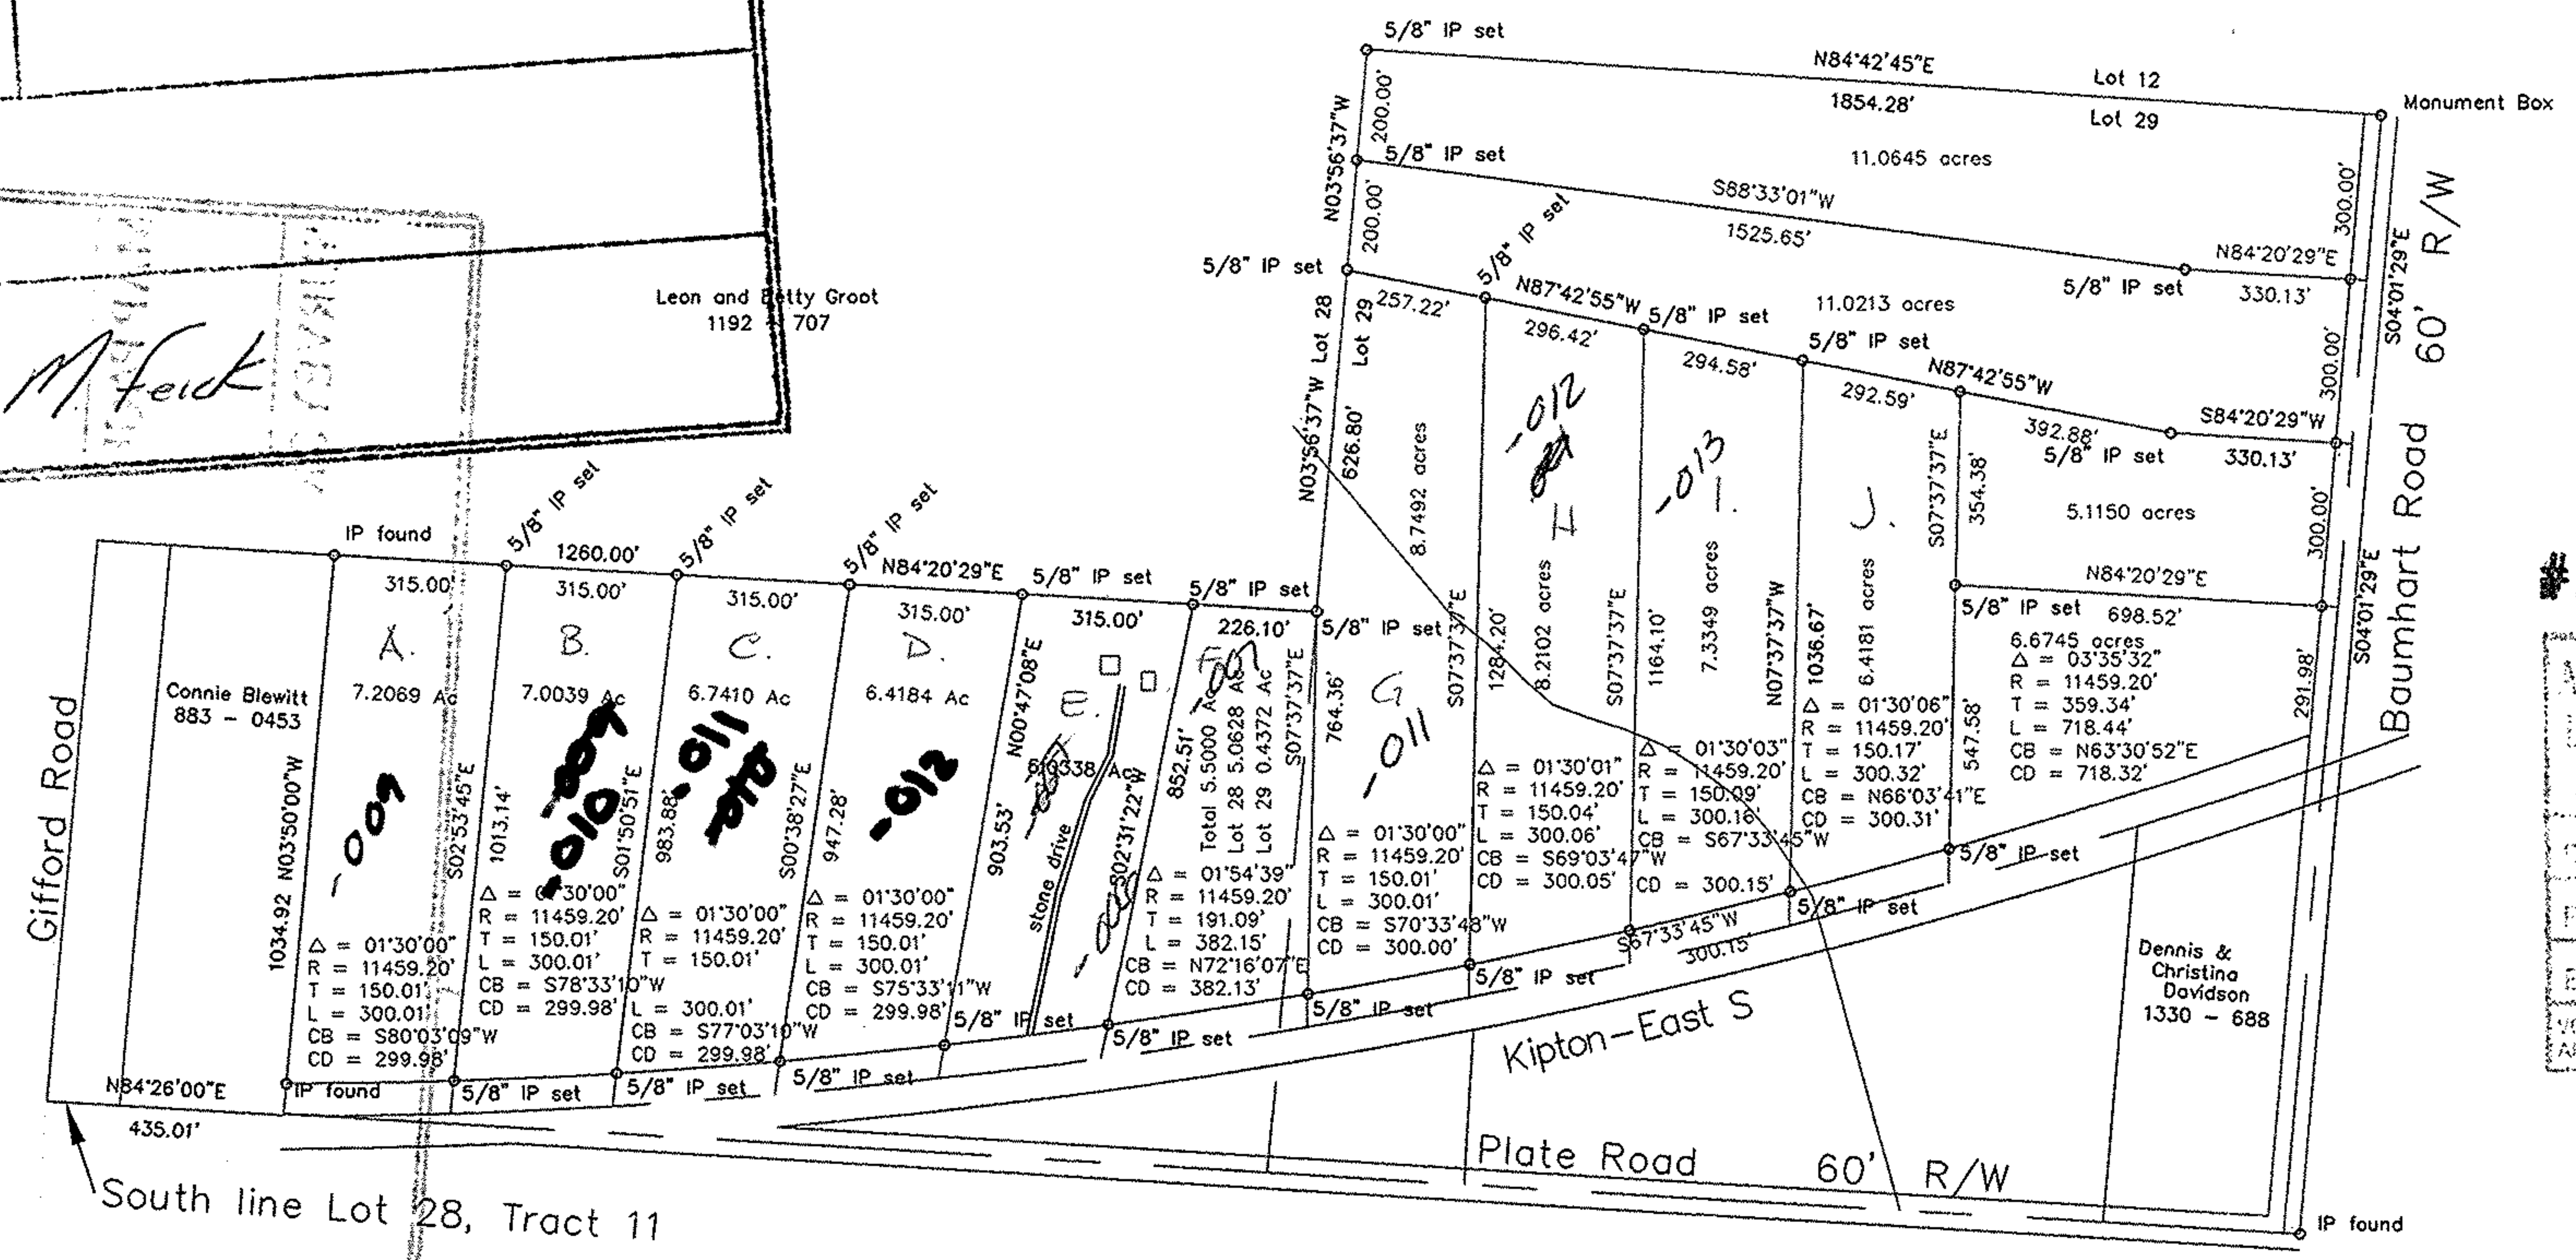


#21958

APPROVED
 LORAIN CO.
 MAP DEPT.
 DATE 11-15-96
 PAGE 13-D
 BY T. McVain
 VOID AFTER 21958

assumed

GRAPHIC SCALE

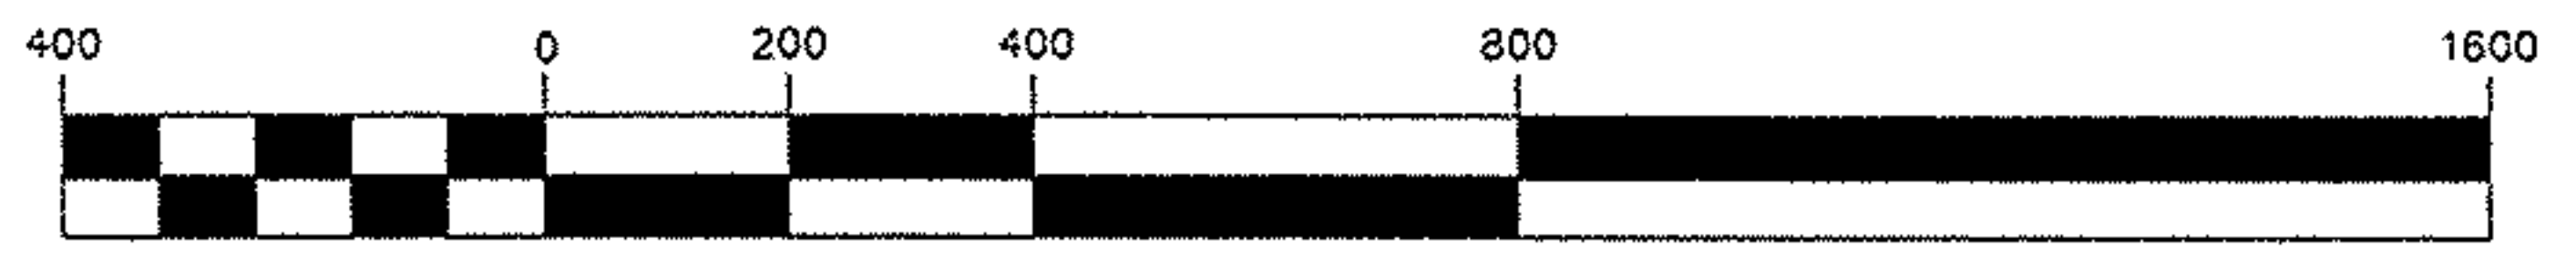

(IN FEET)
 1 inch = 400 ft.



Carl M. Feick
 P.S. 7035

FEICK SURVEYORS

224 East Water Street, Sandusky, Ohio 44870, 419-625-3241

DRAWN BY: CMF

DATE: 10/12/95

JOB NO.: S4737

SHEET 1 OF 1

Plat of Survey

Chuck Davidson

49300 Rt. 20 West
 Tract 11, Lots 28 & 29
 Camden Twp., Lorain Co. Ohio