


06-23-004 007-015.022

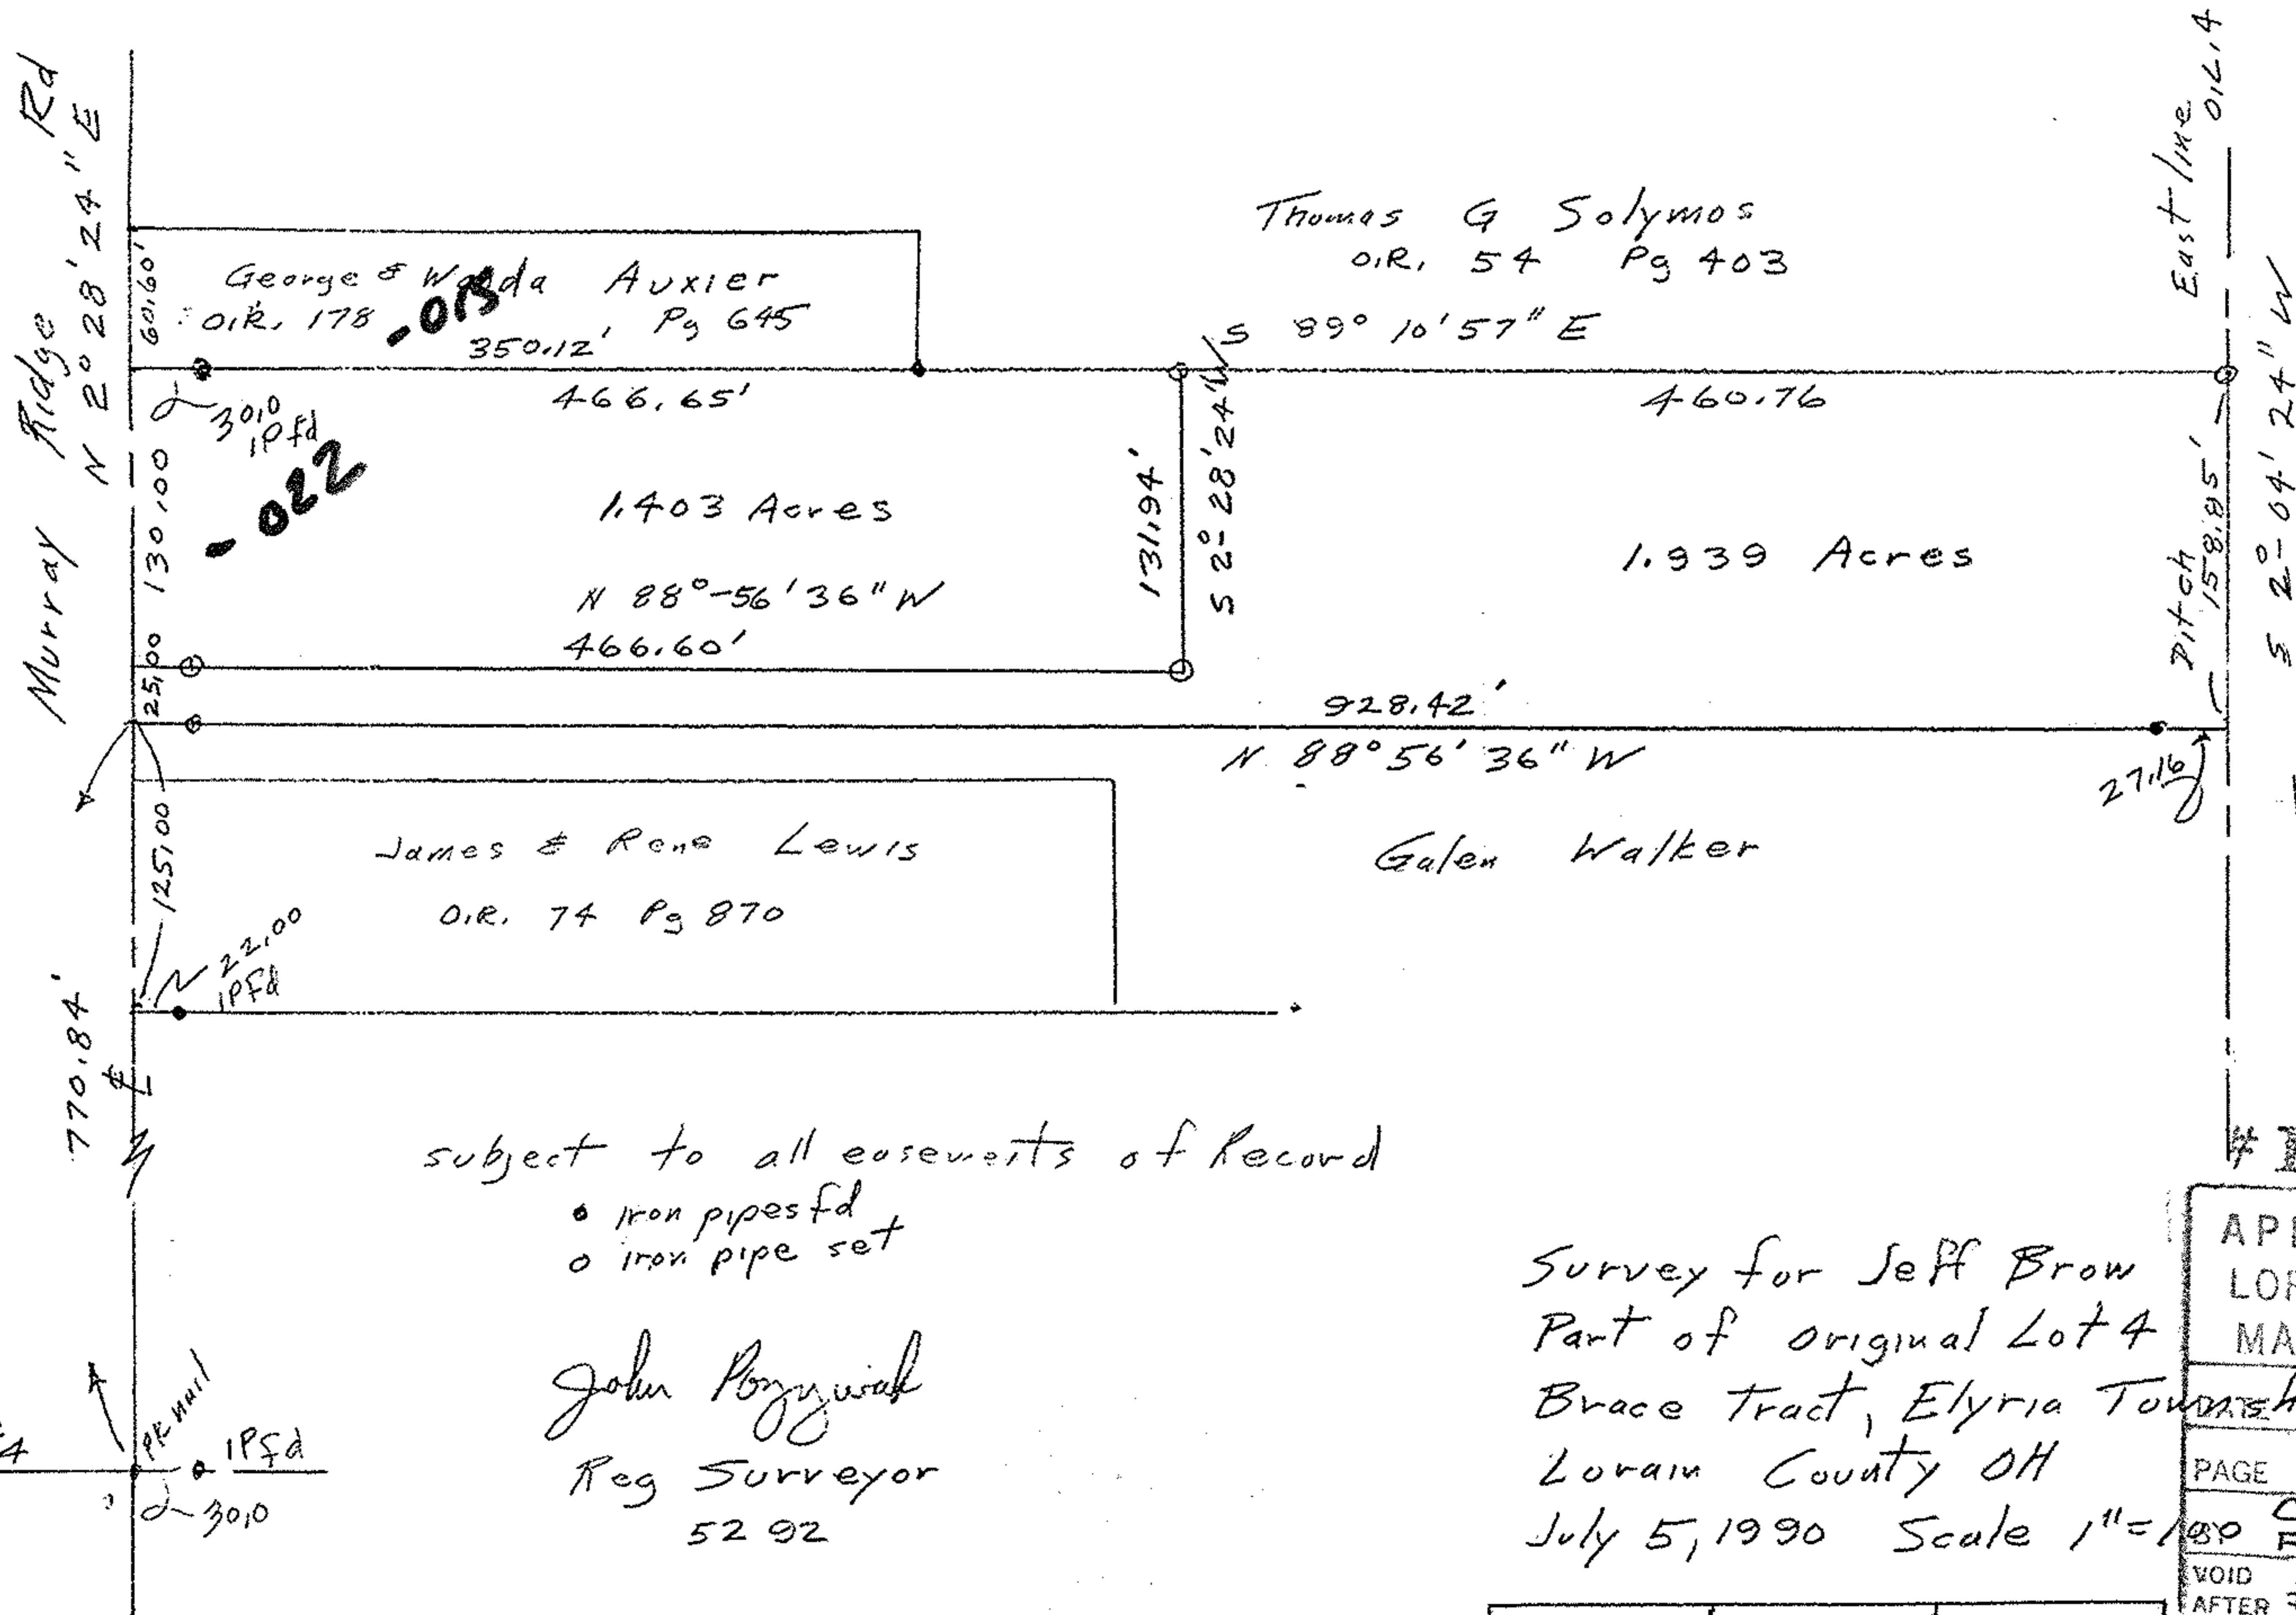

subject to all easements of record


- iron pipes fd
- o iron pipe set

John Poryziak
Reg Surveyor
52 92

Survey for Jeff Brow
Part of original Lot 4
Brace Tract, Elyria Township
Lorain County OH
July 5, 1990 Scale 1" = 100'

#19264

APPROVED	
LORAIN CO.	
MAP DEPT.	
PAGE 6-22	
CAROLYN FRANCIS	
VOID AFTER	# 19264

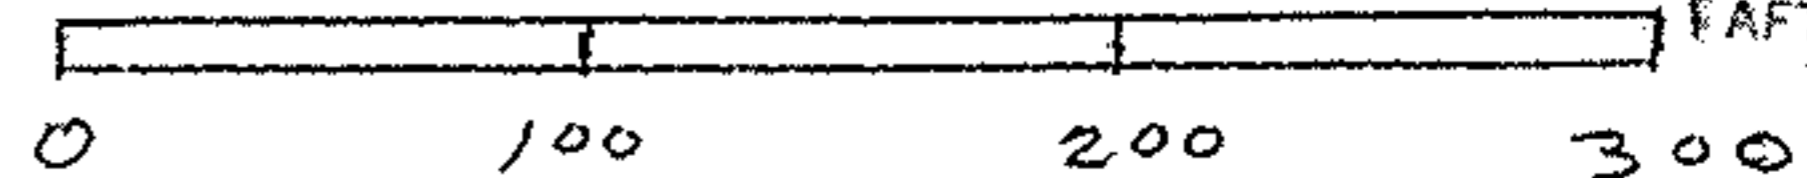

So, line 0.2. 4
3010
IPFd