



PLAT OF SURVEY FOR  
 MRS. ELIZABETH BREZNAI  
 ORIGINAL LOTS 2 & 3 - BRACE TRACT - EL  
 LORAIN COUNTY - OHIO  
 SCALE: 1" = 100'  
 MARCH - 19  
 GARY E. PENFOUND Reg. Surveyor N

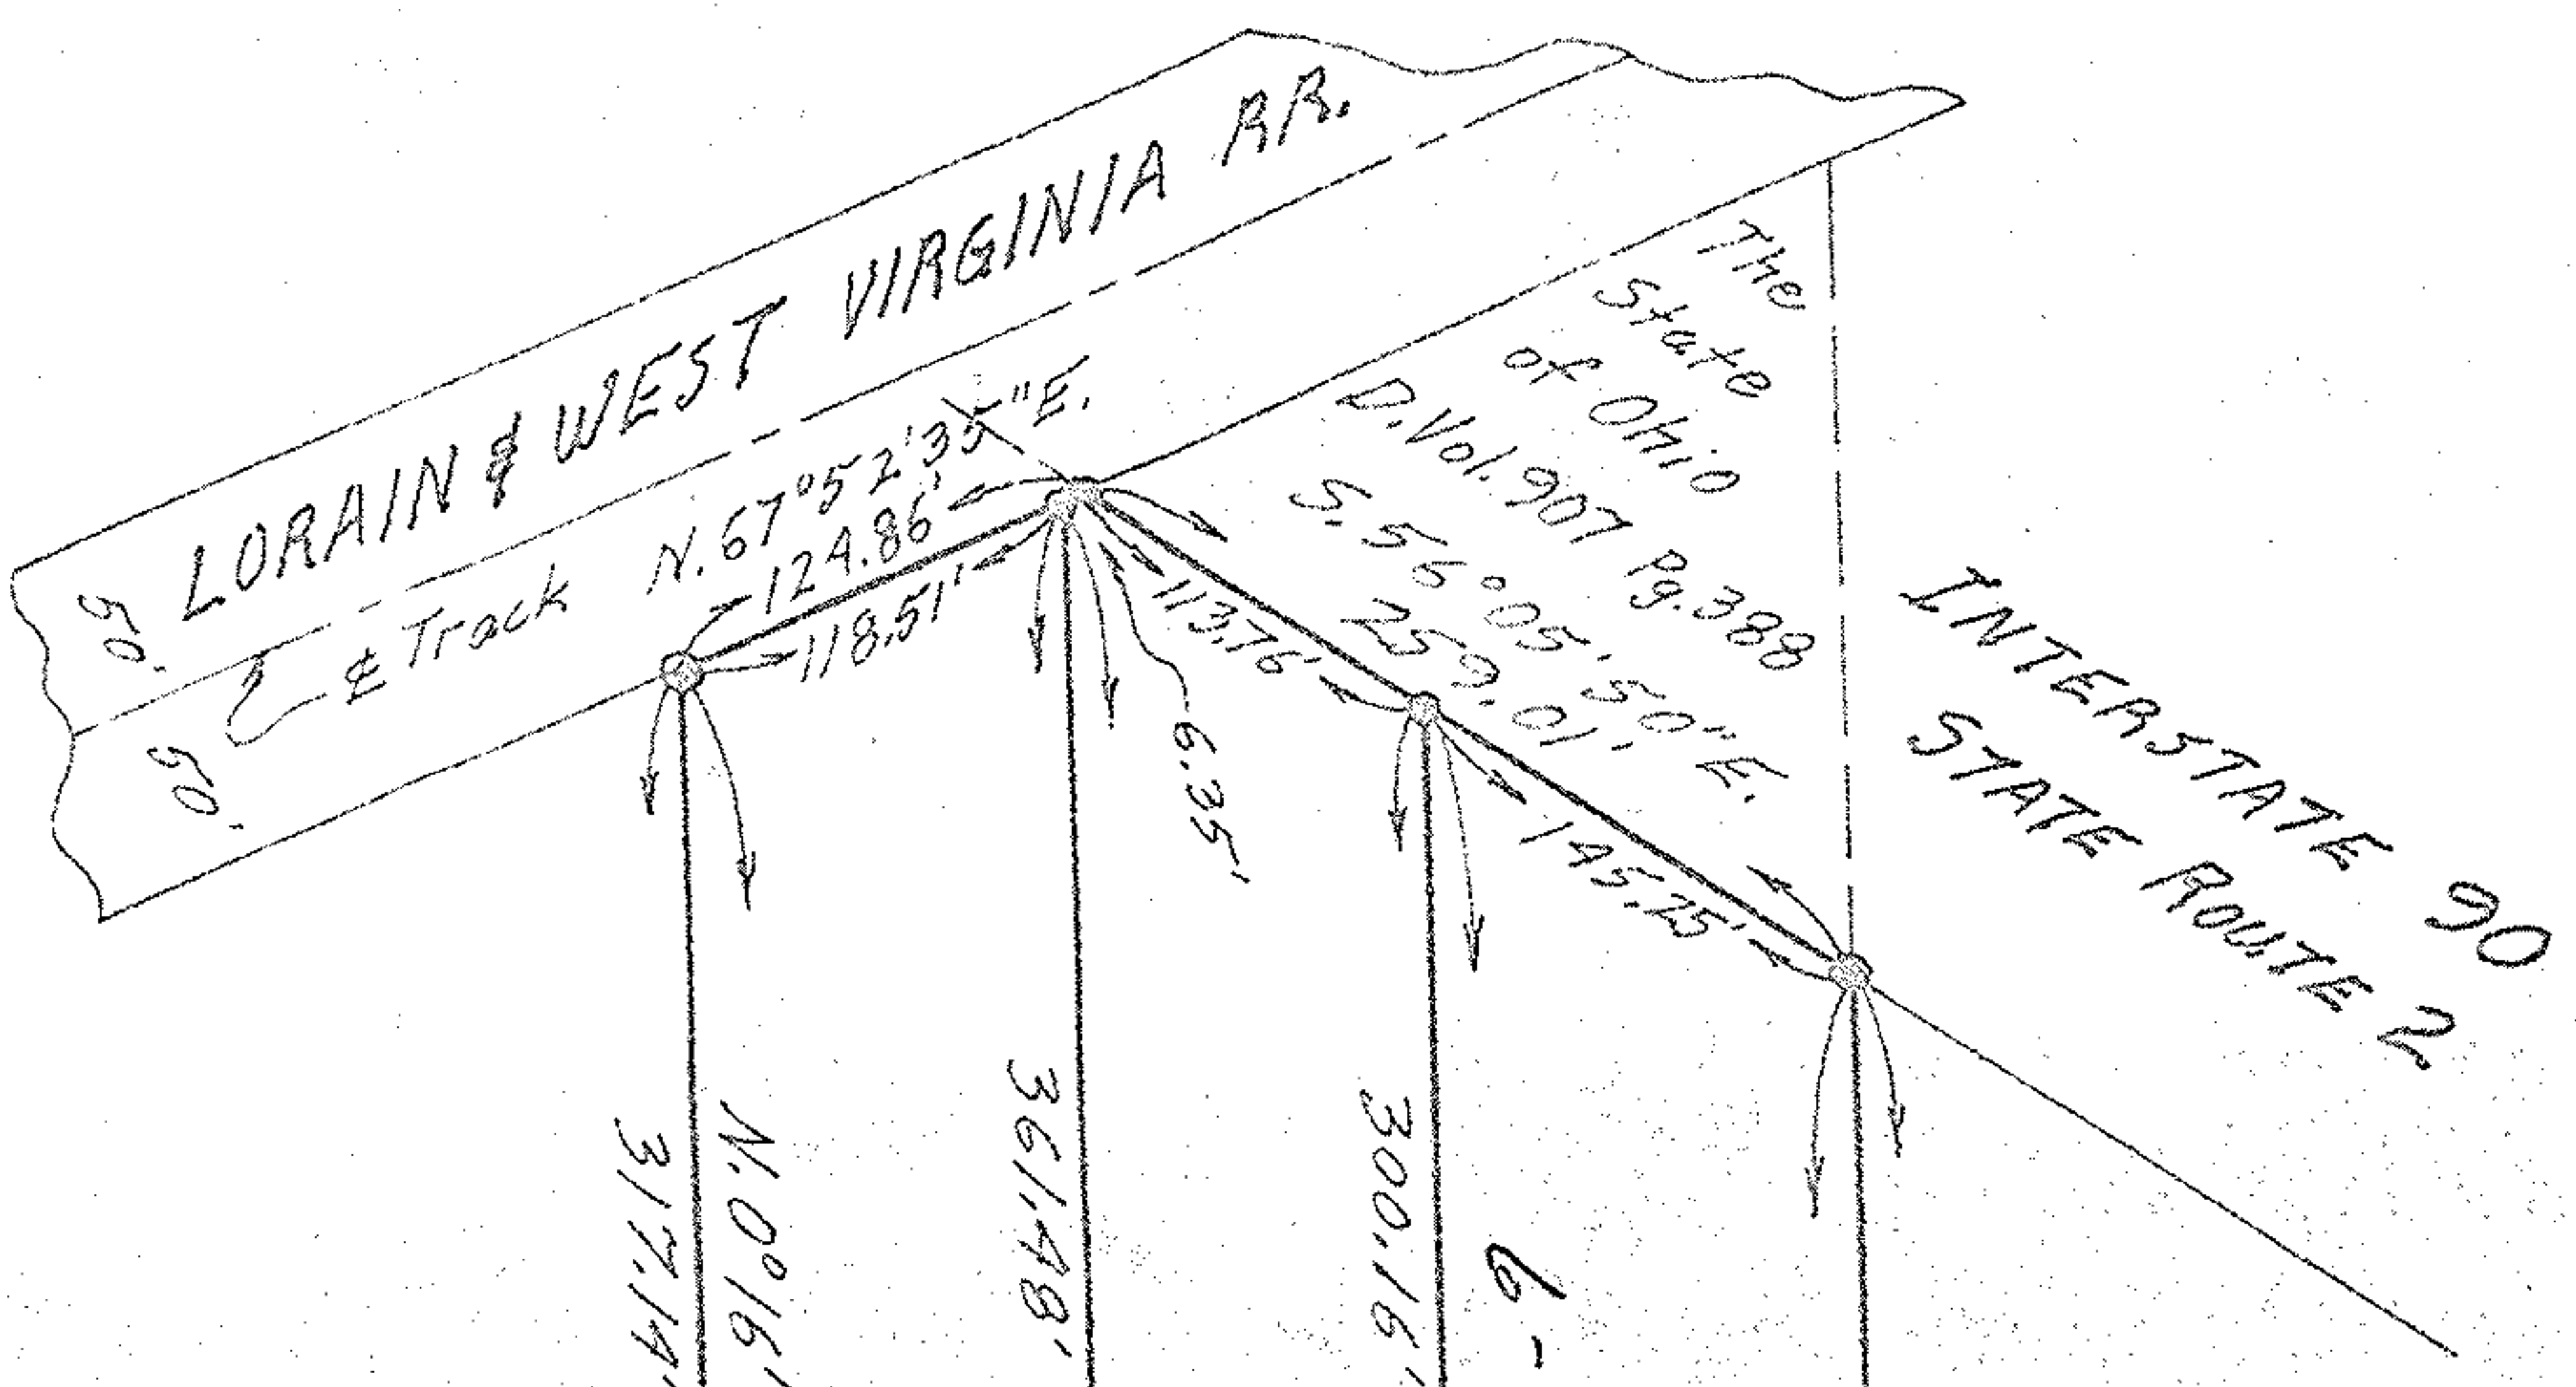

NOTES: ○ indicates iron  
 ● indicates iron  
 otherwise assumed

6-23-002  
 6-23-003

06-23-003-101-011

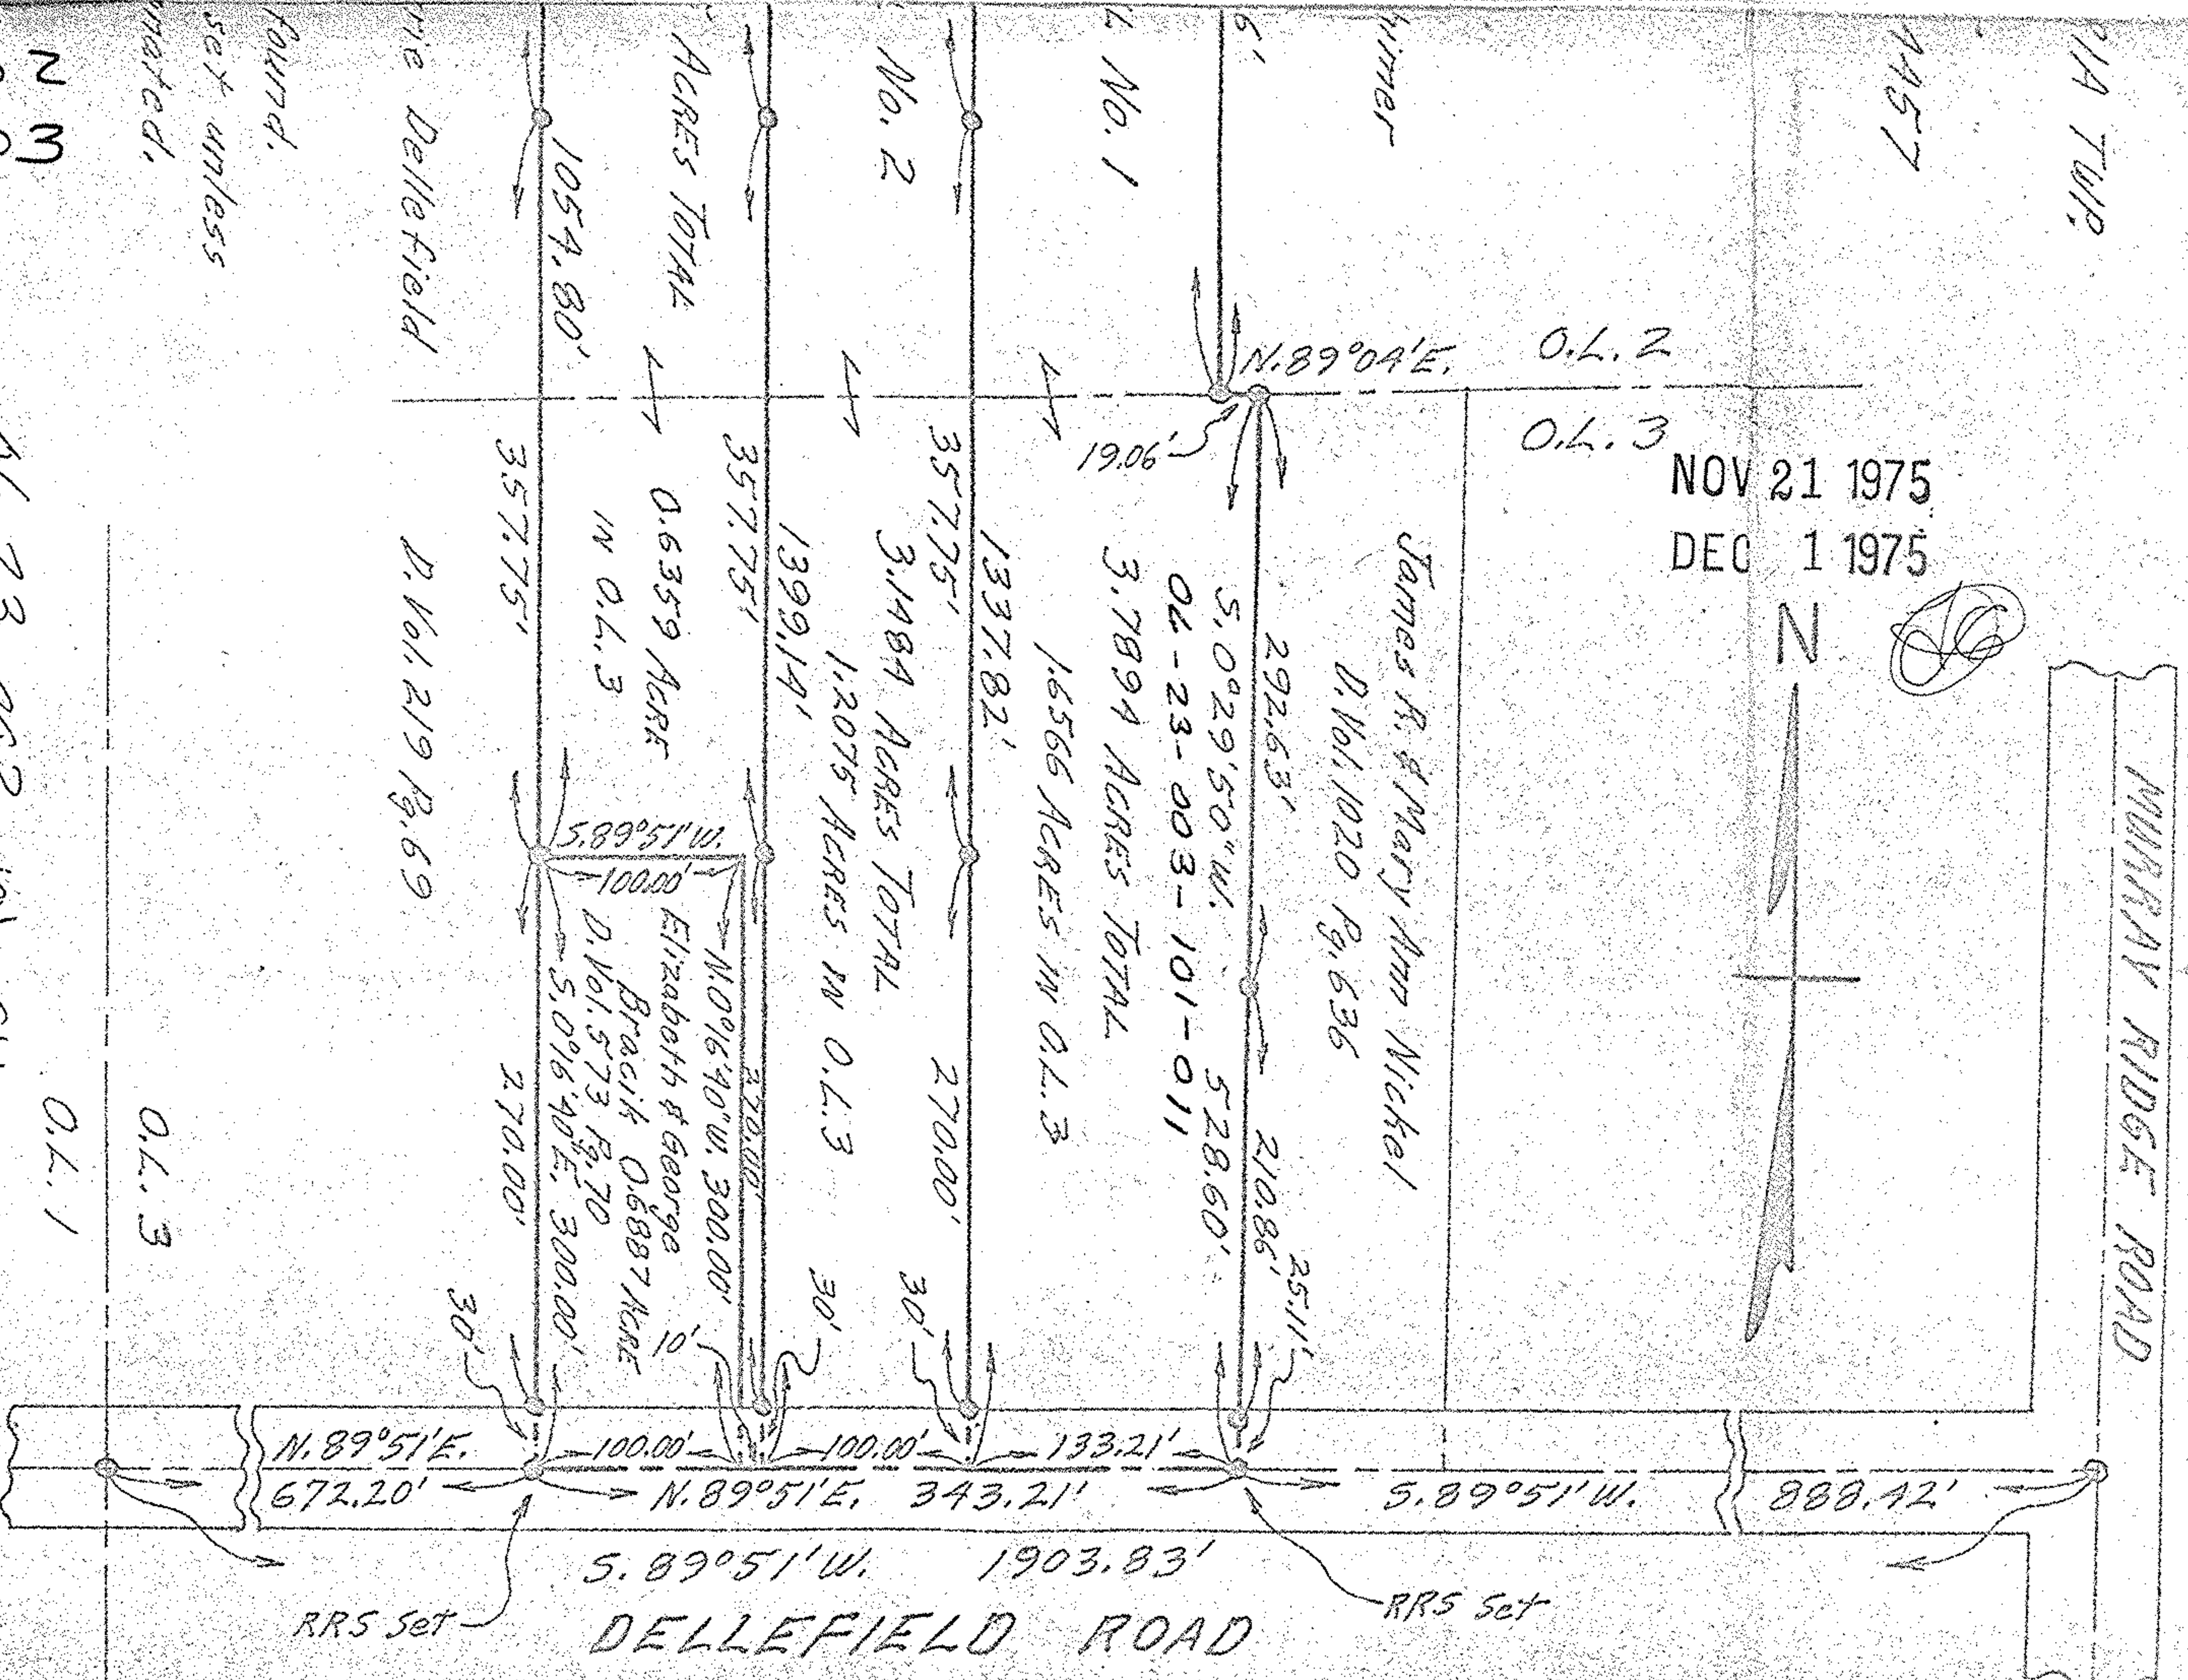

9261  
 6-21